

Lot 1.

Lot 2.

Lot 3.

Lot 4.

Lot 5.

Lot 6.

Lot 7.

Lot 8.

Lot 9.

THIRTY

E71W

Surveyed August 24, 1920.

Lot 1.

06

3117E

6

39

91

91

Surveyed August 24, 1926.


oo

9

Note: Streams, except in the vic irrigated land, are sketched approximate location.

GE21E.

20-2-1

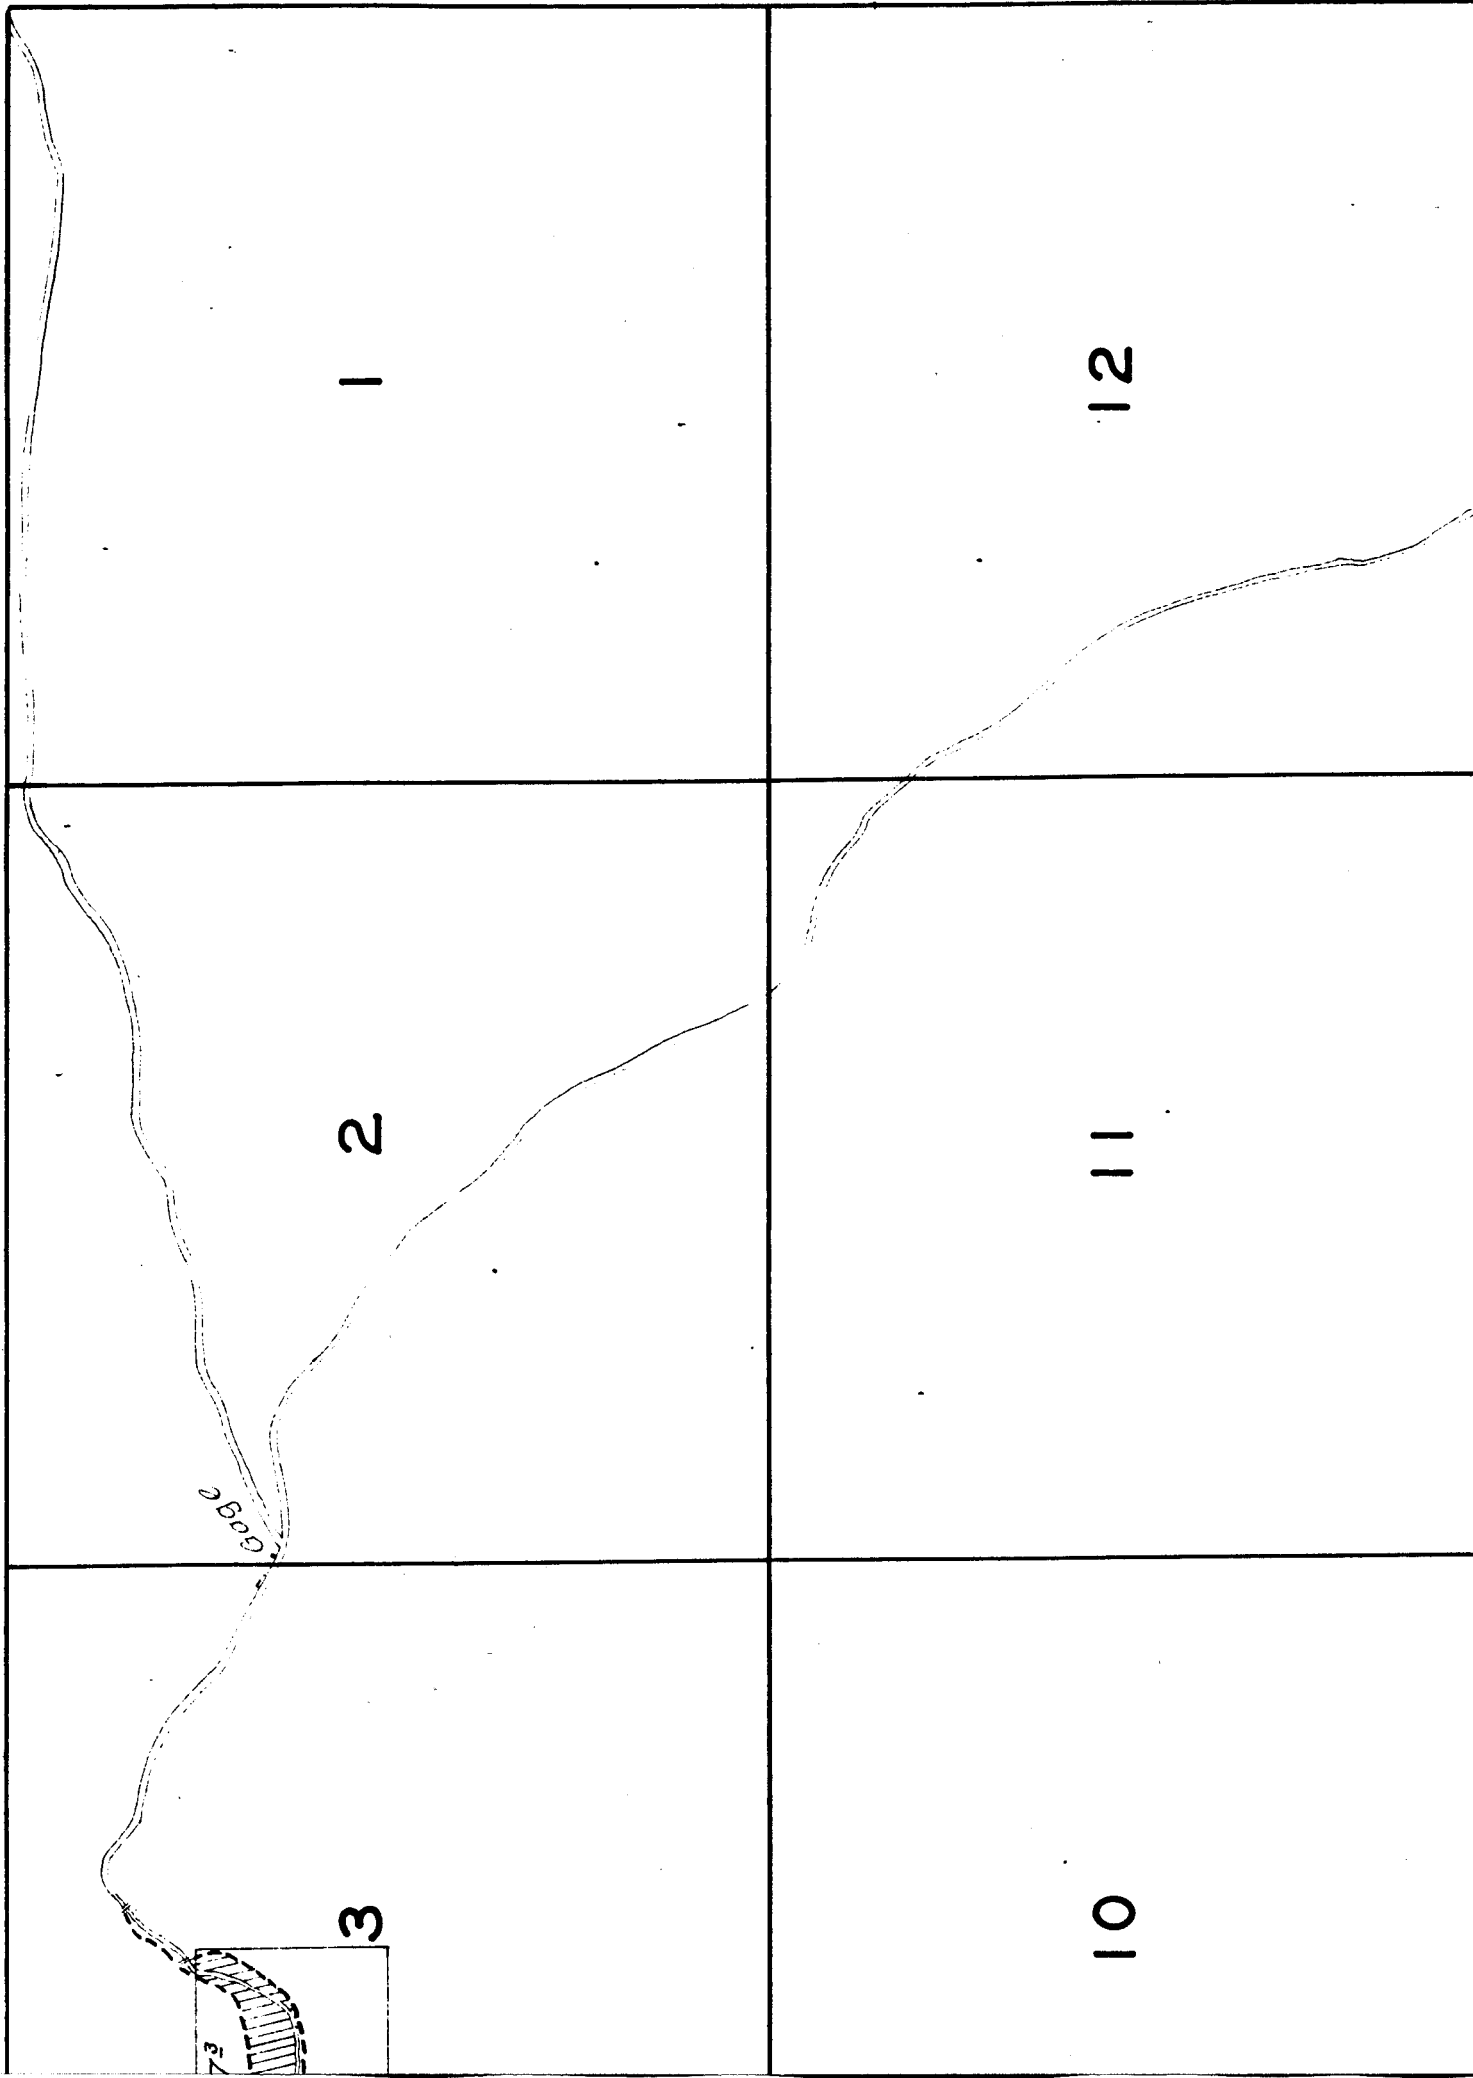

15

14

13

George Stewart

0-

1°

Surveyed August 23, 1926.

22

23

24

TOWNSHIP 5 S., RANGE 21 E.

Lot 4.

06

THIRTY

MILE

CREEK

4

C.M. Smith

39

73

02

01

3

Surveyed August 24, 1926.

9

10

16

15

23


24

26

25

35

36

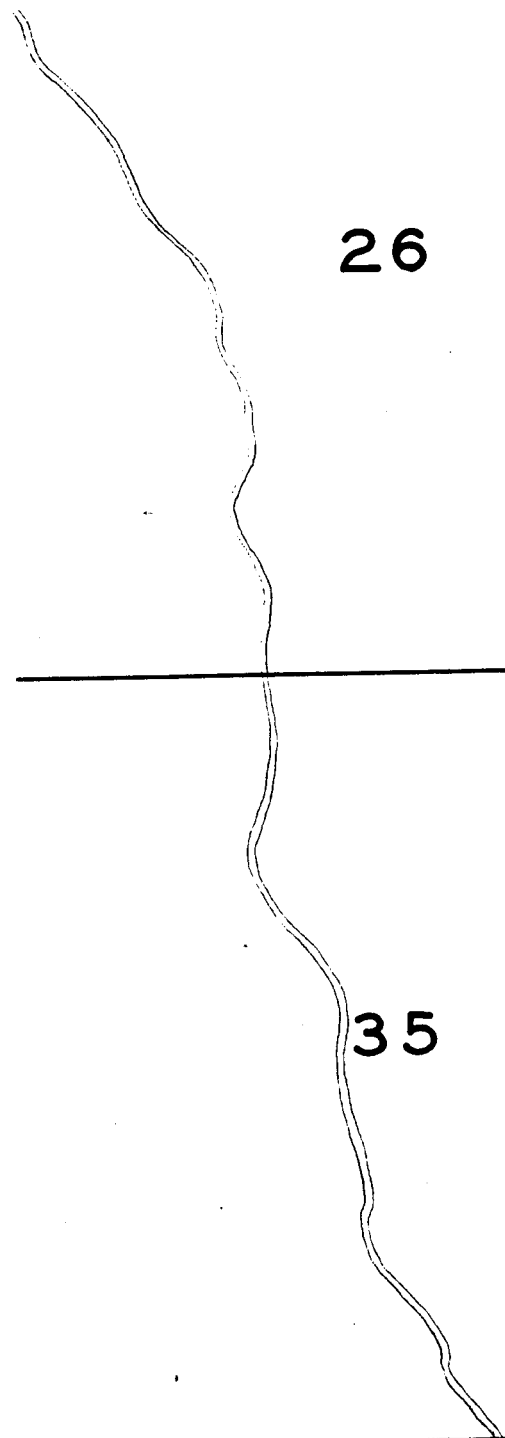

19

20

30

29

31

32

28

27

33

34

16

15

21

22

Note: Streams, except in the vicinity of irrigated land, are sketched in approximate location.

