

21

22

28

t
d

27



6

5

7

8

18

17

2

1

11

12

14

13

27

26



25

34

35

36

*Zachary Spring piped to
house for domestic
use.*

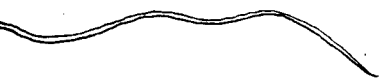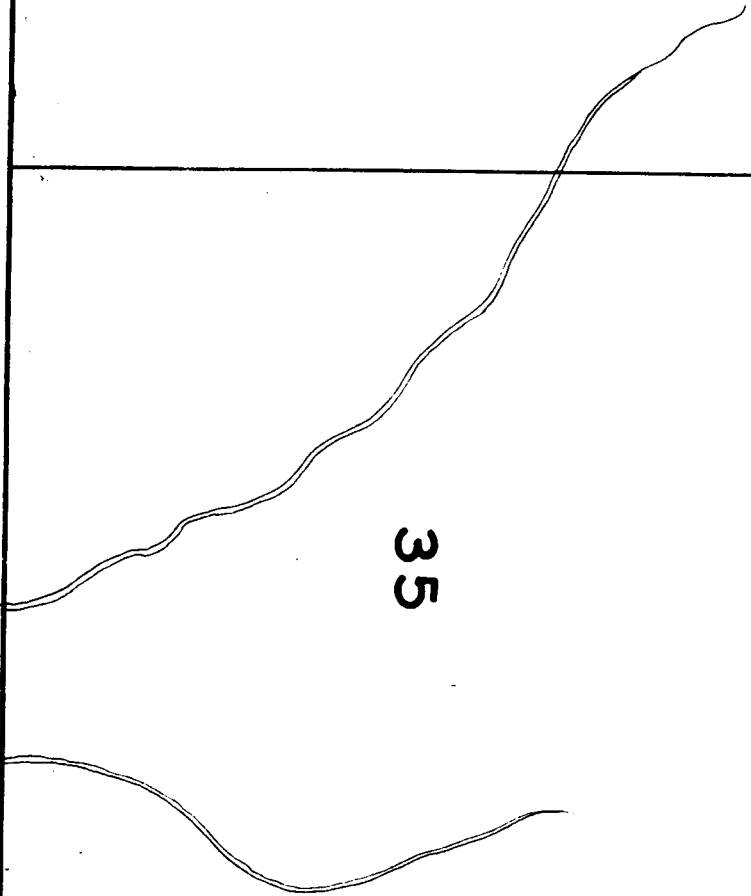

15

14

13

22

23

24

TOWNSHIP 7 S., RANGE 24E.

4

3

9


10

15

22

16

21

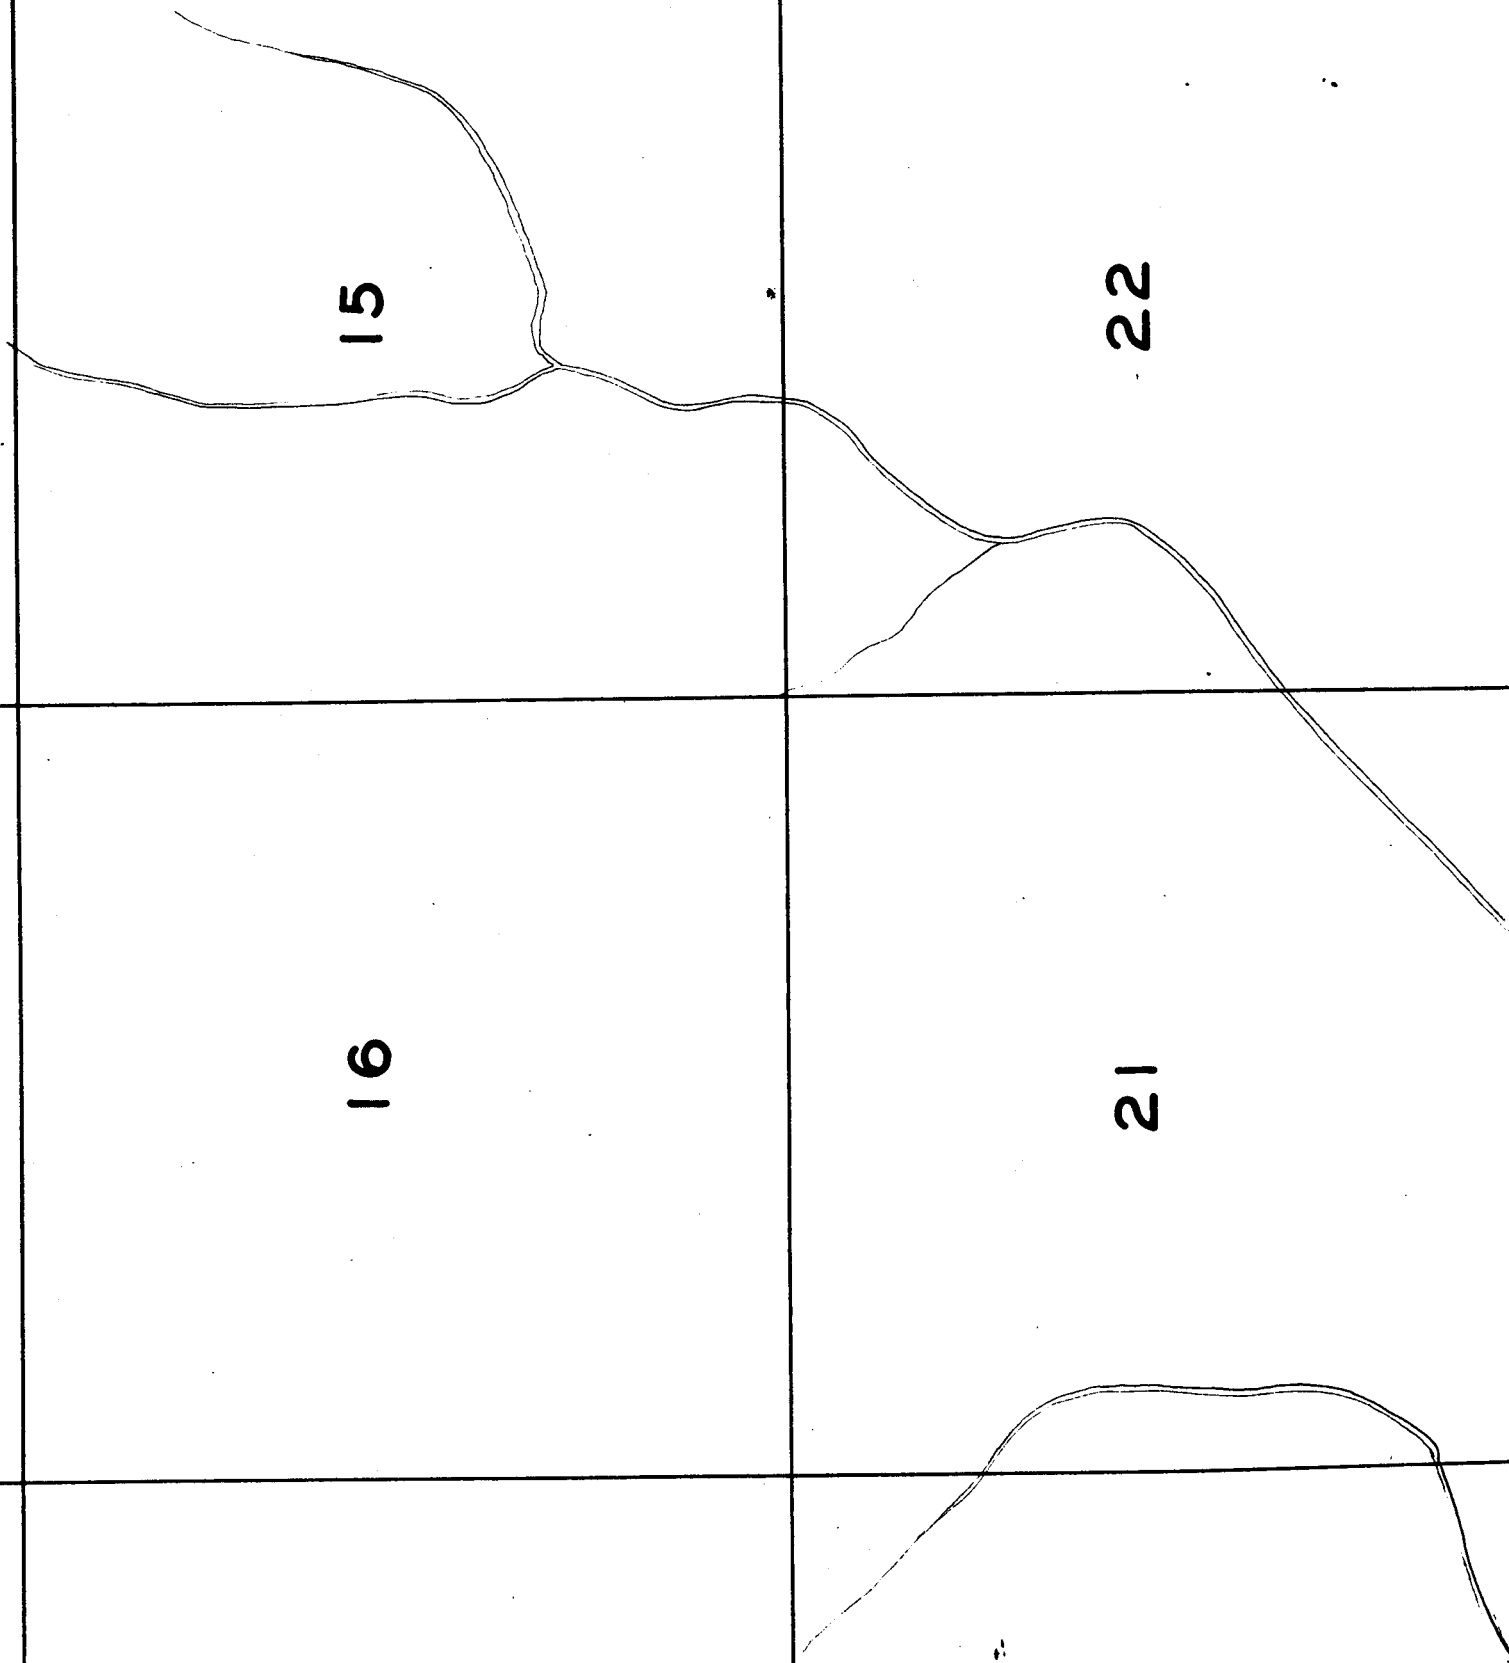

Lot 1.

Surveyed October 20, 1925.

Lot 2.

N. S. Nelson

1/5

Spring

1/3

30

Saw Mill

Lot 3.

31

Elmer M. Quinn

A. H. Akin

8'

Ed. Beach

23'

03'

H. A. Warrington

32

Surveyed October 16 and 17, 1925.

29

Note: Location of streams and roads, except in the vicinity of irrigated land, sketched in approximate location.

28

33

Gage

14

