


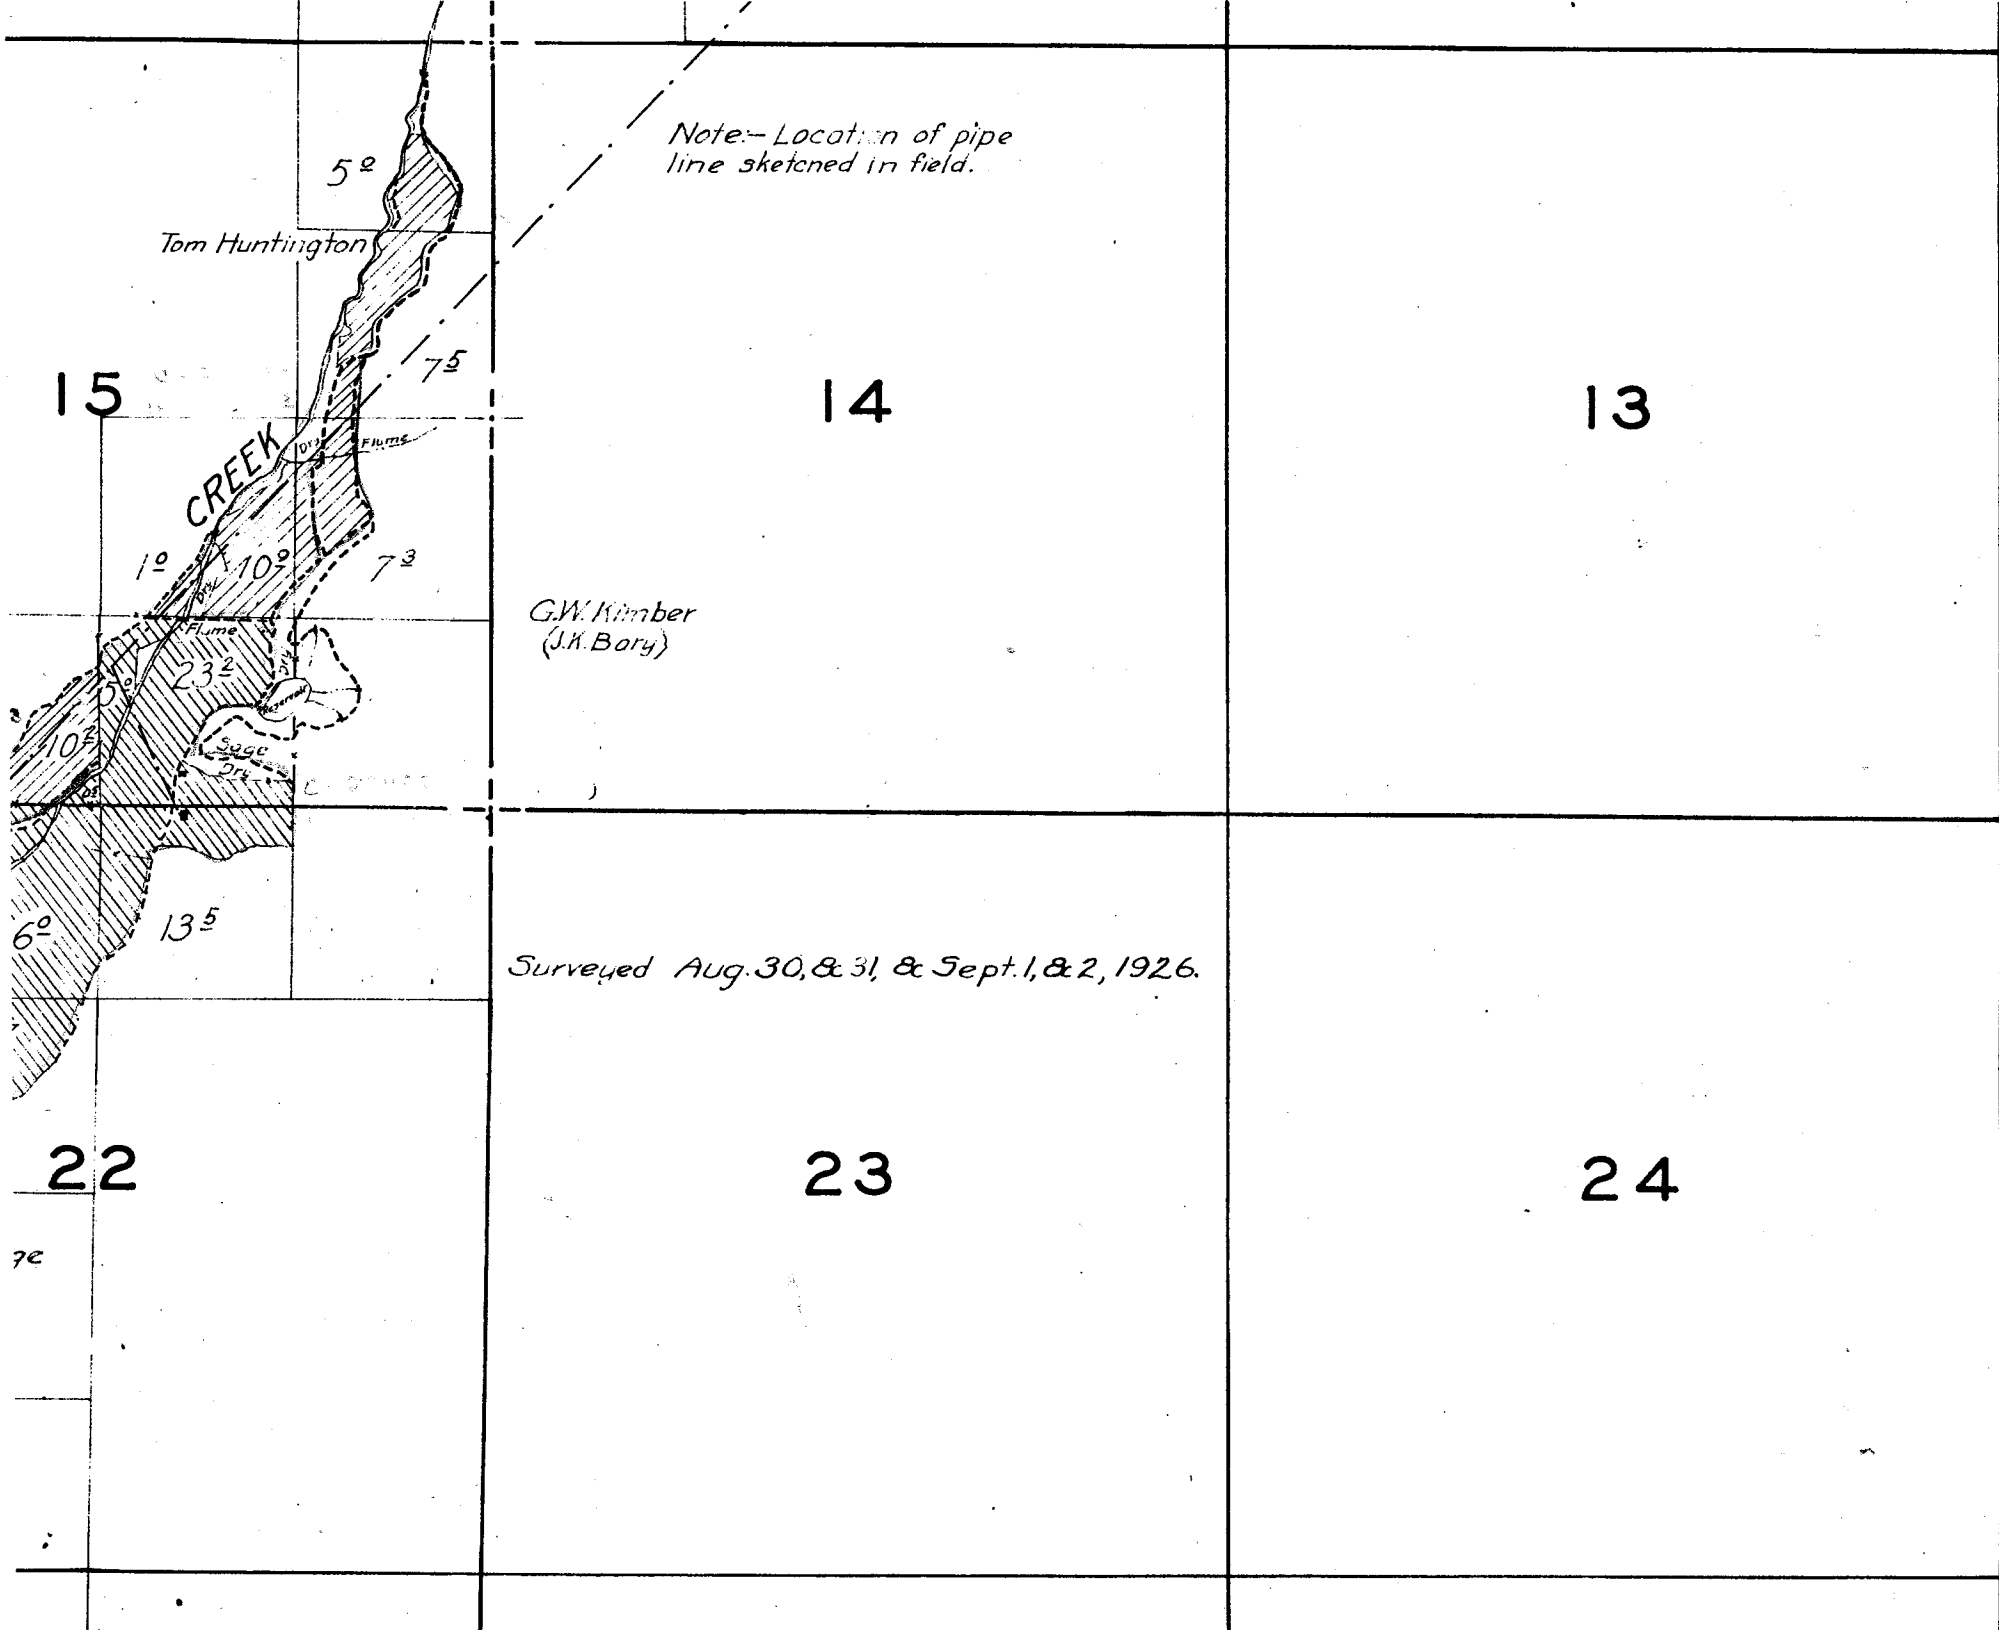


15

27

26

25

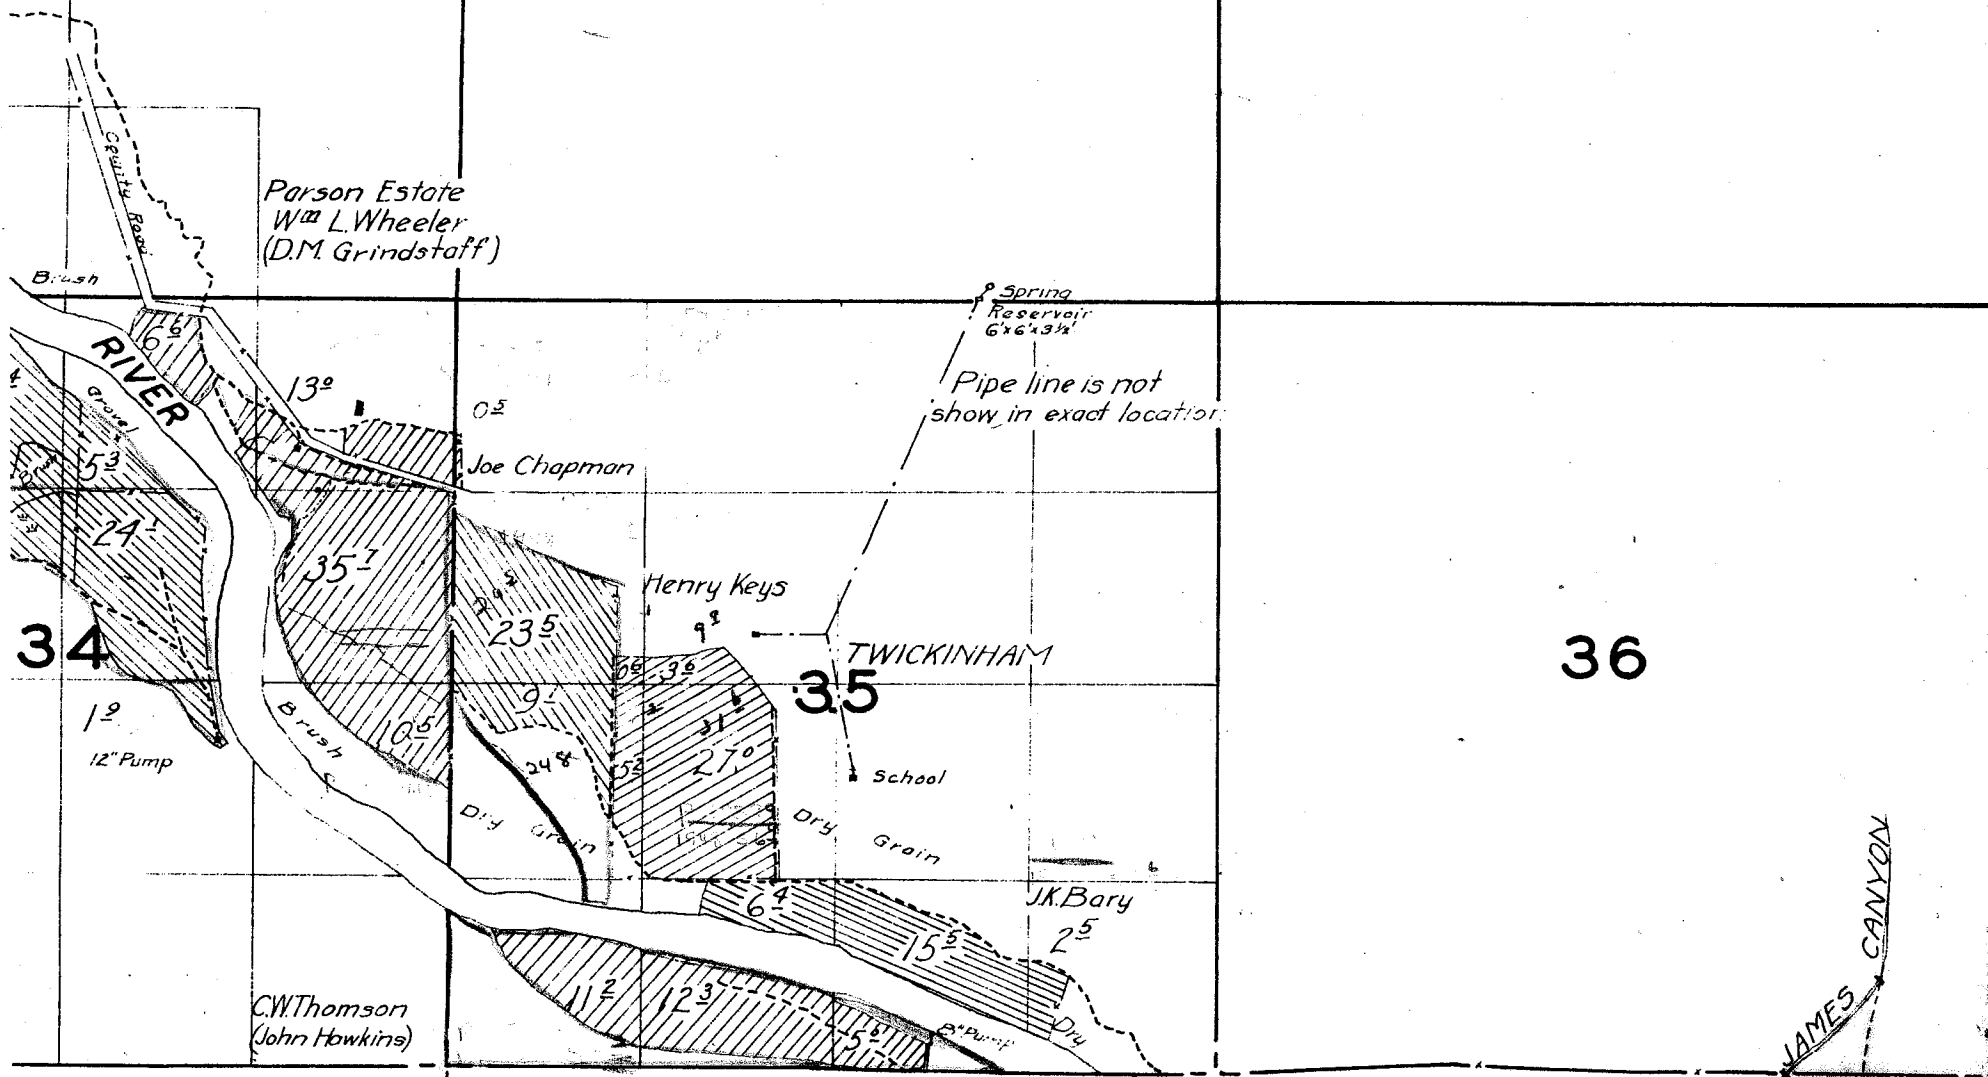

30

29


28

31

32

33

Watering

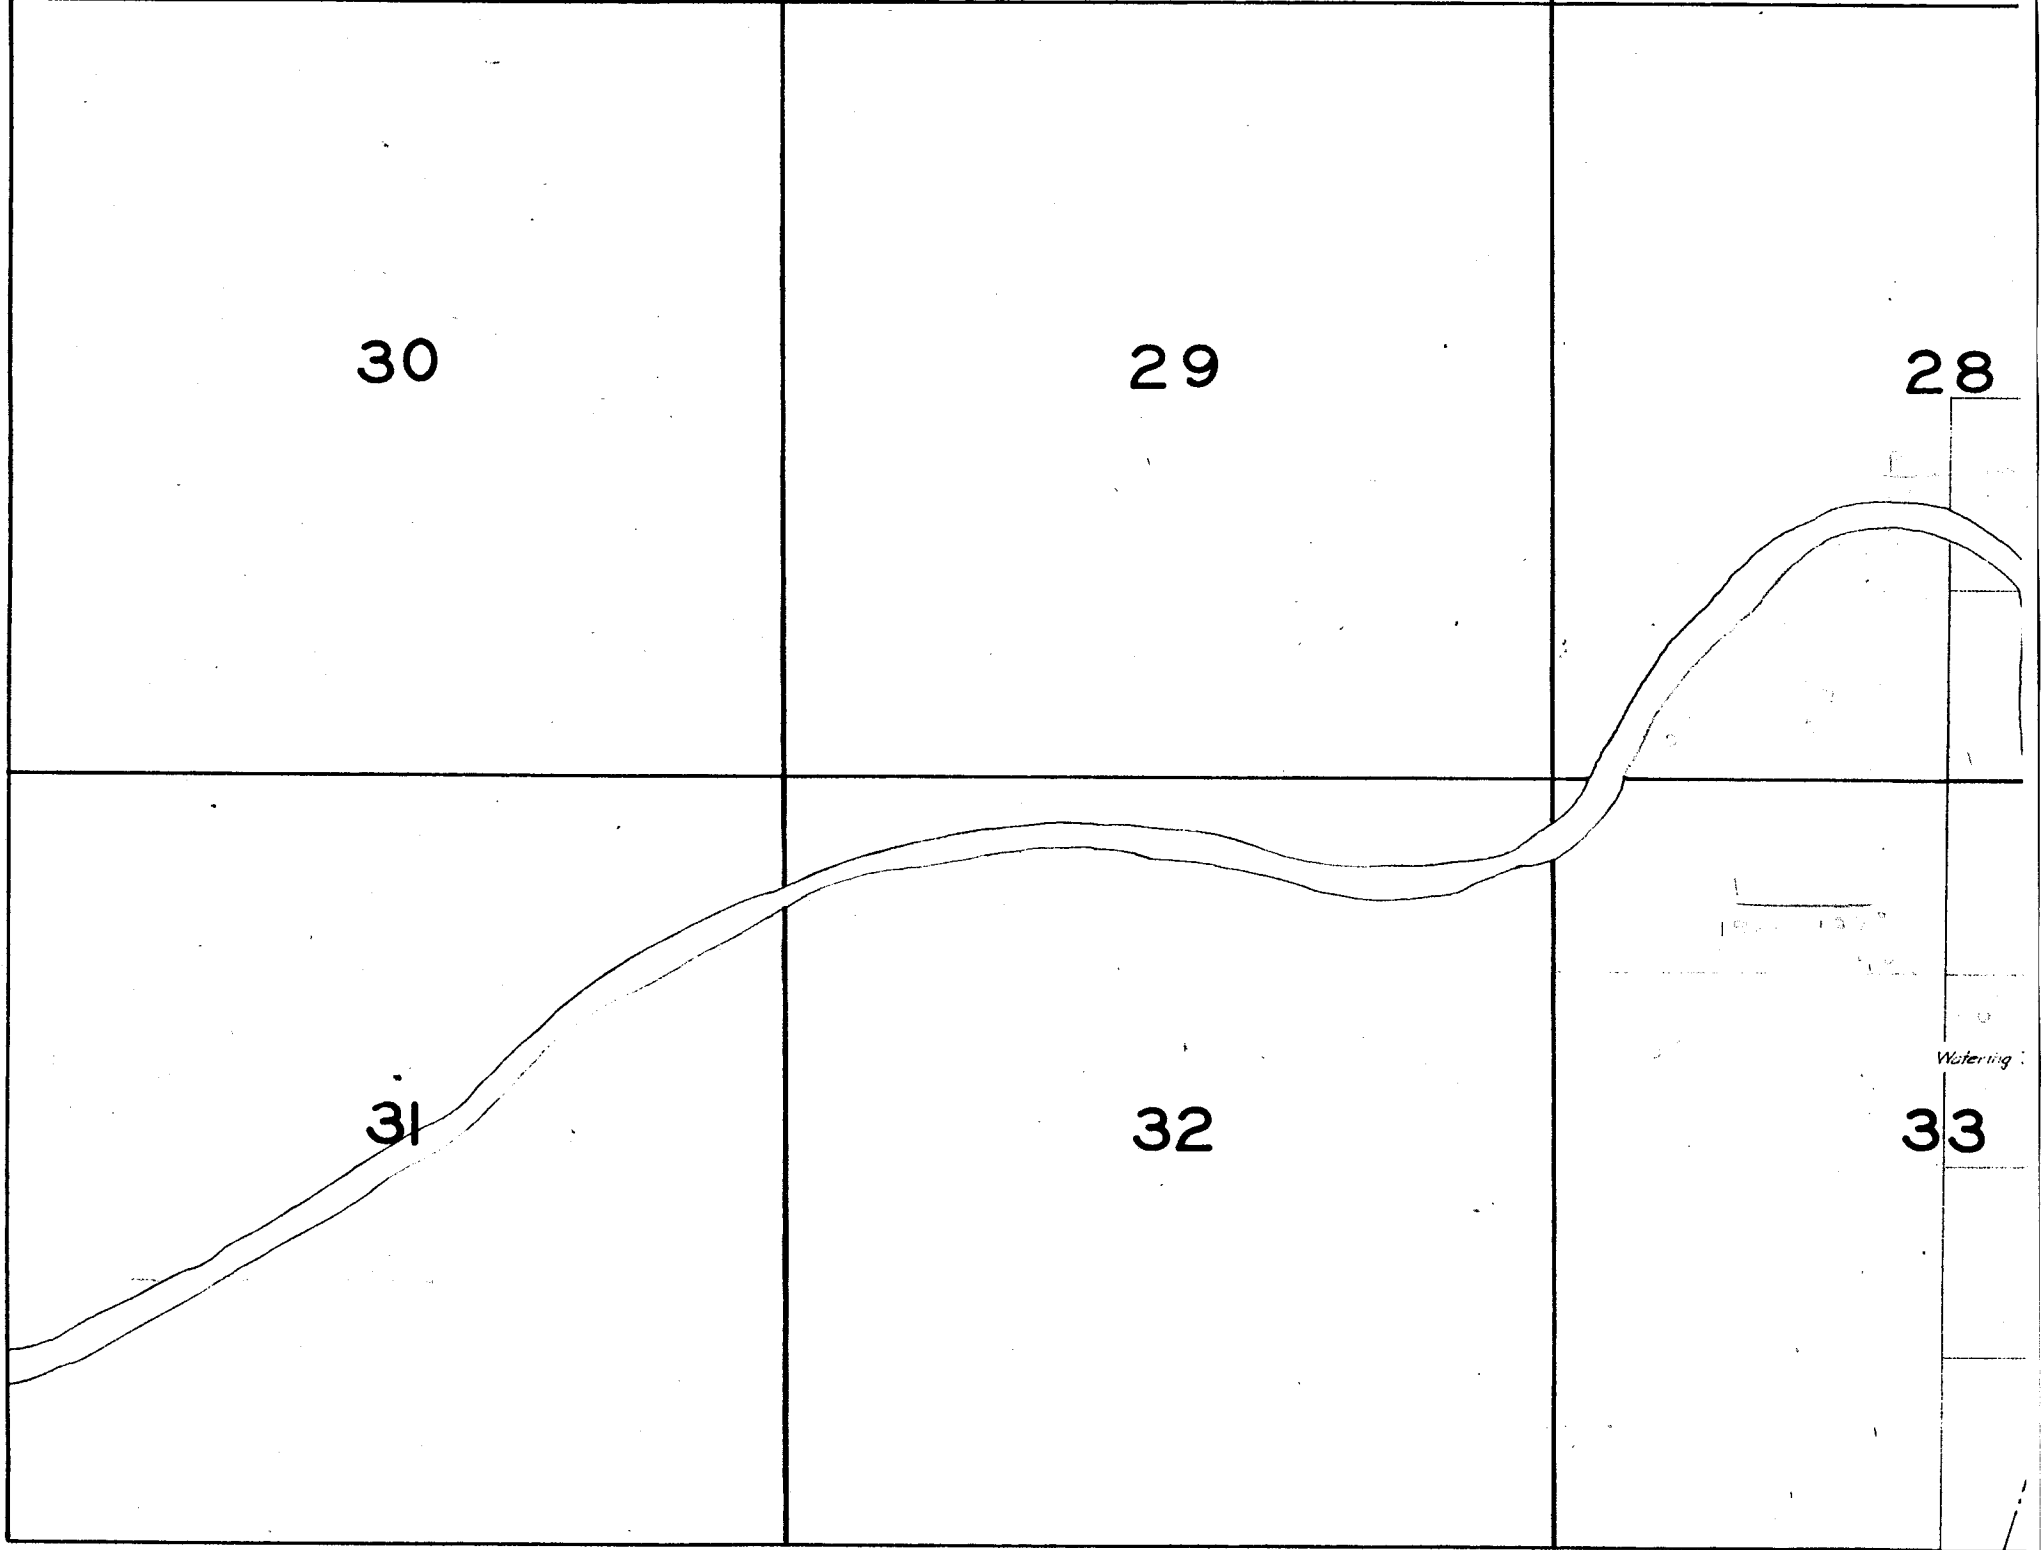

18

17

16

19

*Note: Except in the vicinity of irrigated
lands streams and river are sketched in
approximate locations.*

21


TOWNSHIP 9 S., RANGE 21 E.


4

3

9

10

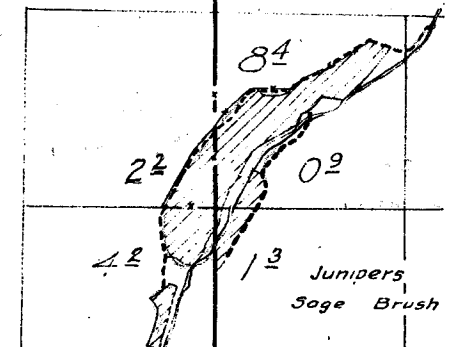

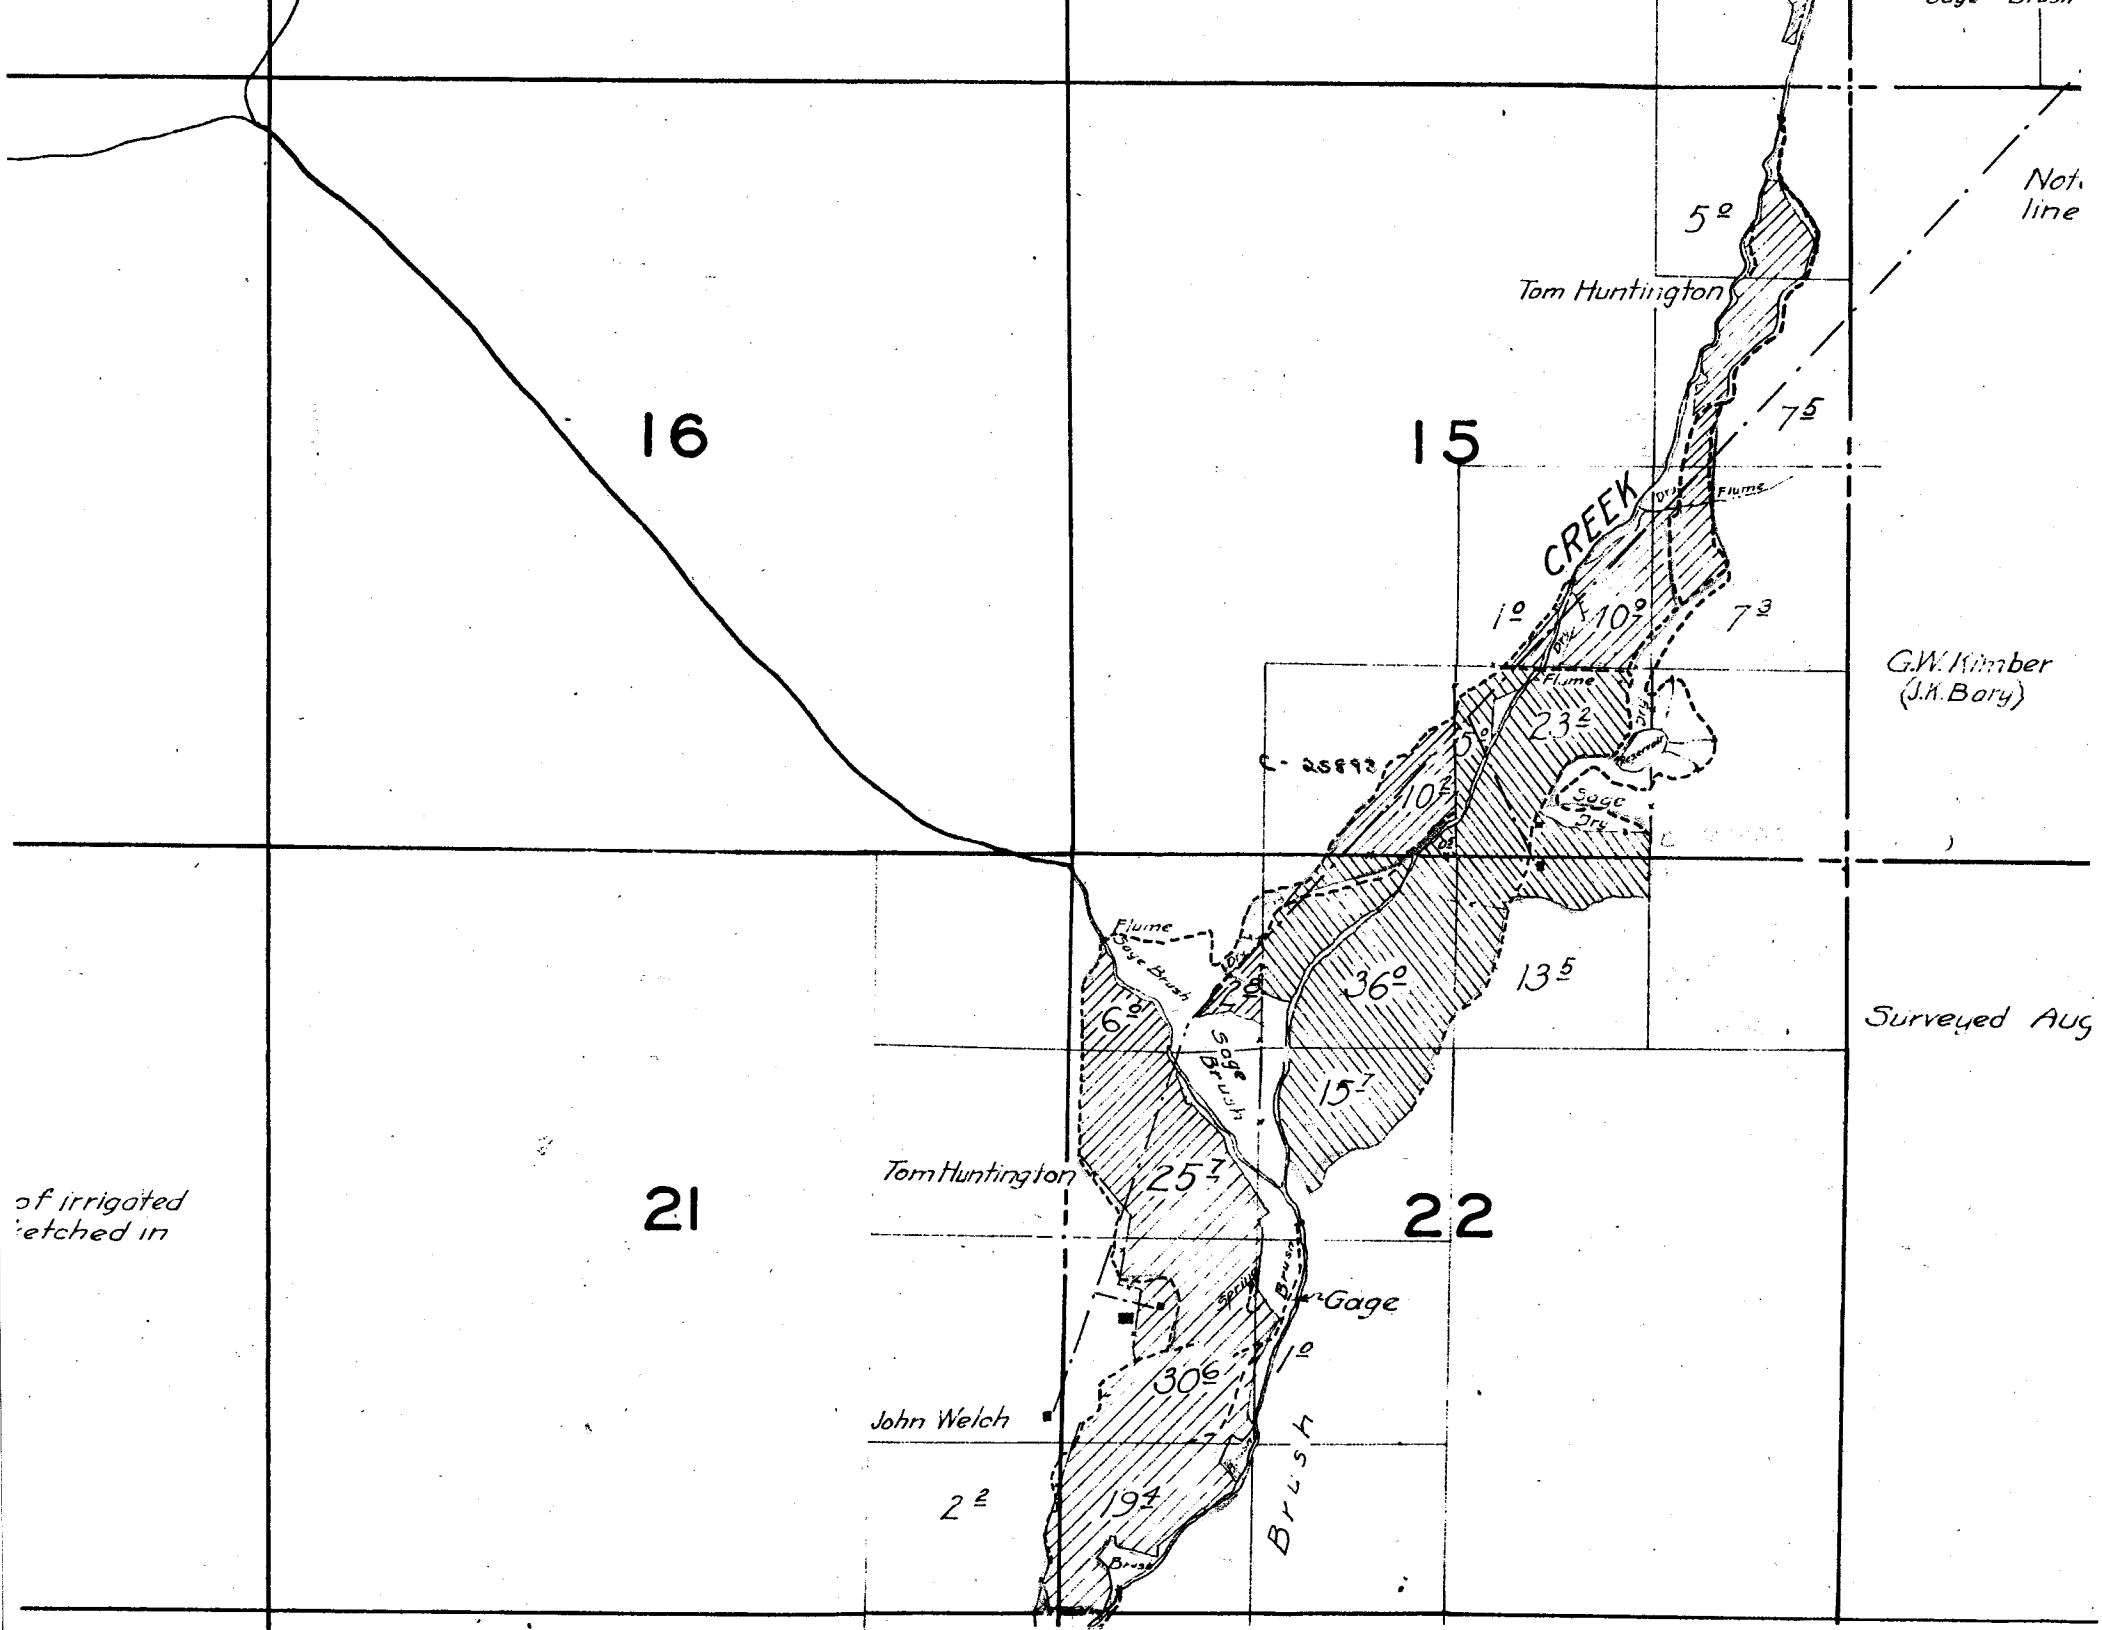


56-2-2

2

1

12


11

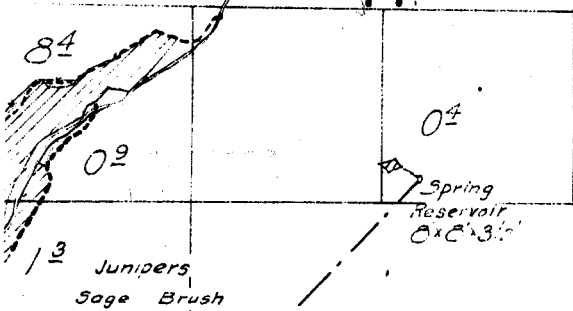

Note:— Location of pipe
line sketched in field.

14

13

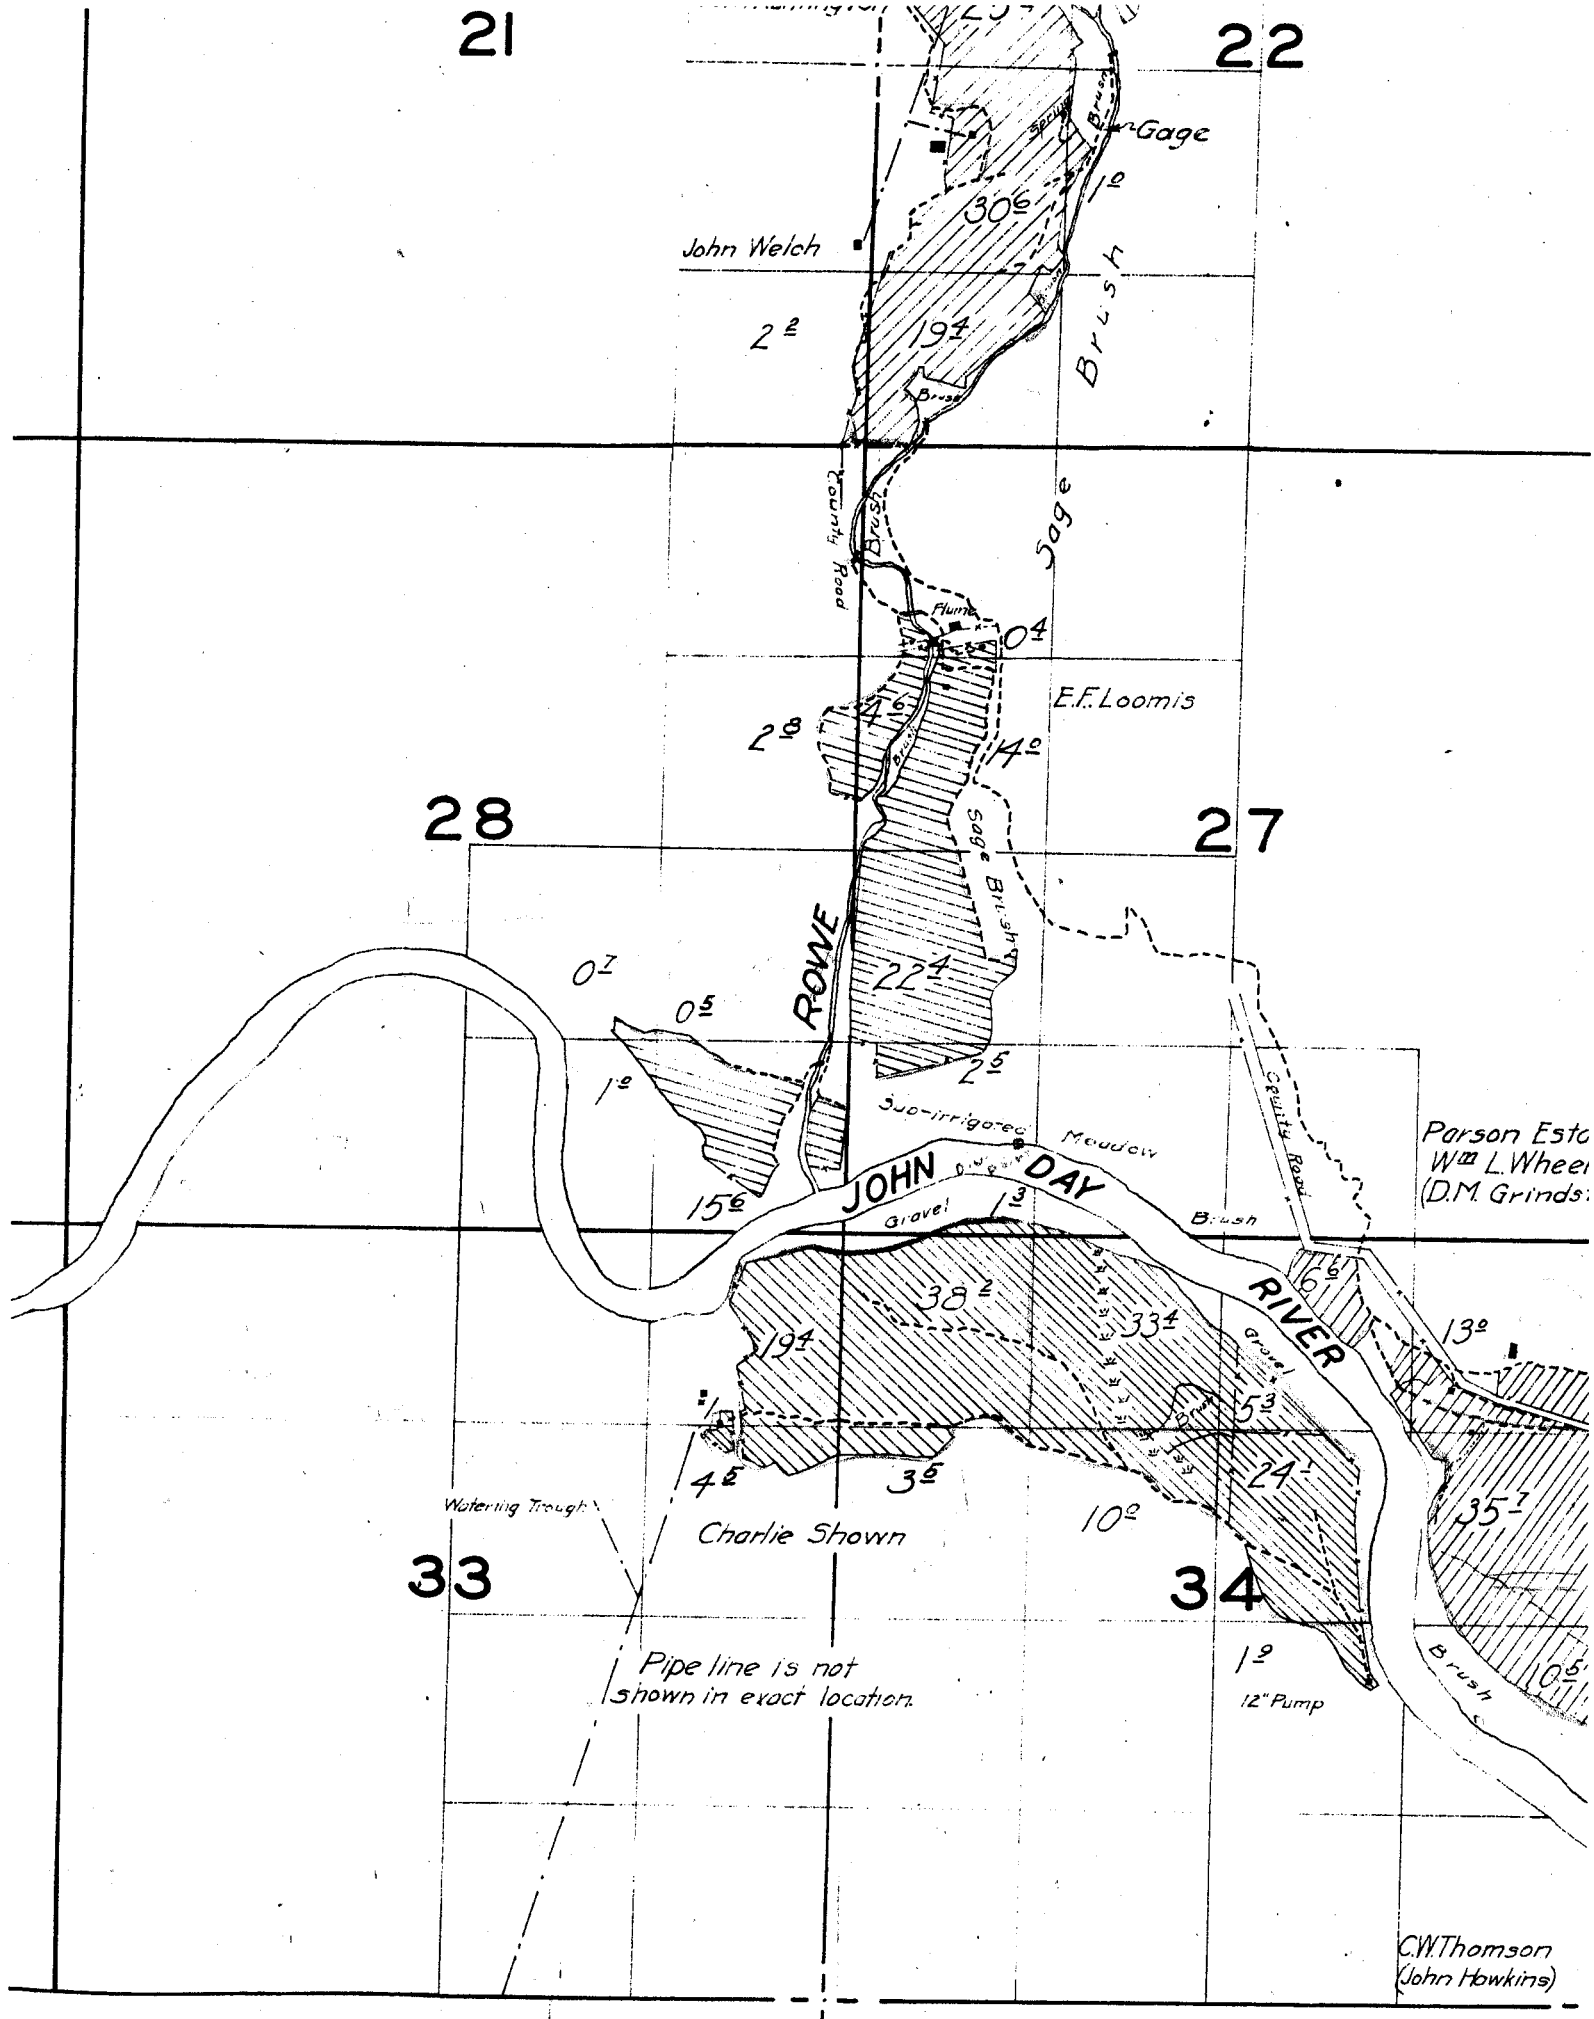

6

5

7

8

18

17