

Note: Location of pipe
line sketched in field.

Tom Huntington

52

75

15

14

13

CREEK

12

73

G.W. Timber
(M. Bory)

Flume

232

Sage

Dr. C. B. Bory

60

135

Surveyed Aug. 30, & 31, & Sept. 1, & 2, 1926.

22

23

24

7c

27

26

25

Parson Estate
Wm L. Wheeler
(DM Grindstaff)

Pipe line is not
show in exact location

Spring
Reservoir
6x6.5x4

Joe Chapman

Henry Keys

TWICKINHAM

12" Pump

School

JK Barry

CMTThomson
(John Hawkins)

36

34

35

JAMES
CANYON

30


29

28

31

32

33

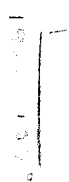

Watering

18

17

16

19

*Note: Except in the vicinity of irrigated
lands streams and river are sketched in
approximate locations.*

21


TOWNSHIP 9 S., RANGE 21 E.

4


3

9

10

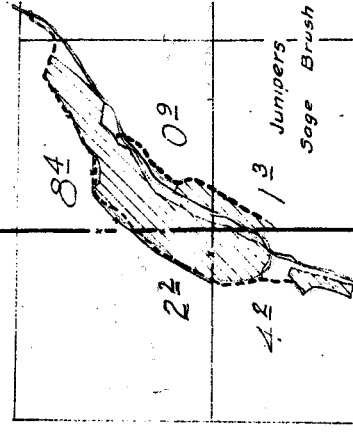

Survived Aug

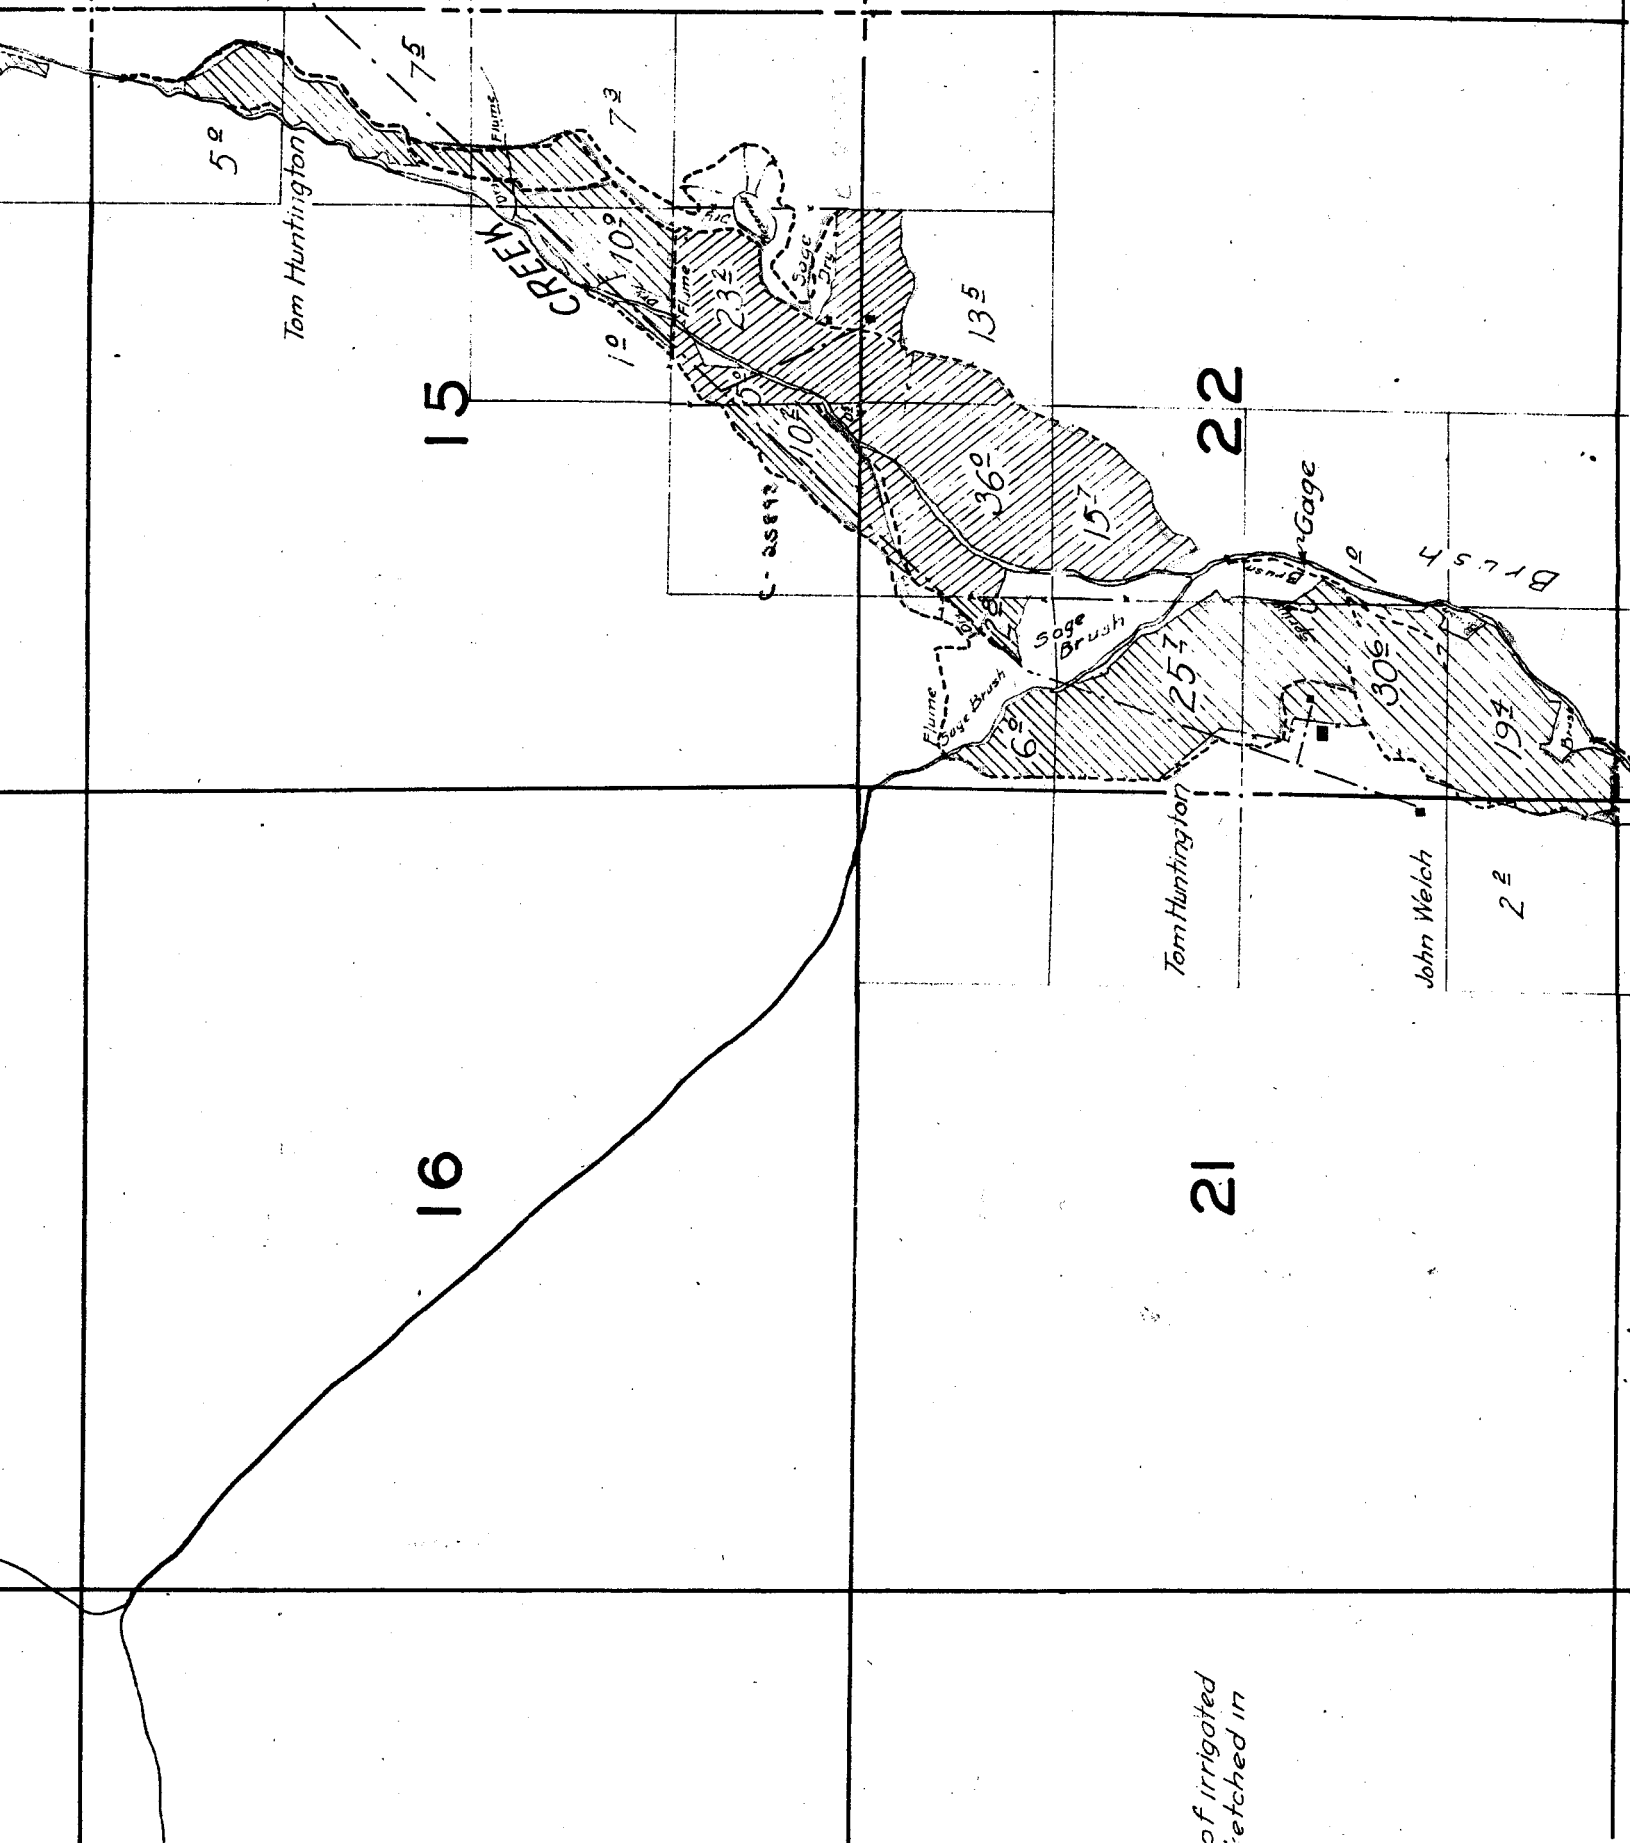

of irrigated
etched in

56-2-2

2

1

12

11

84

09

04

13

Junipers
Sage Brush

Spring
Reservoir
0x0.3

Note:—Location of pipe
line sketched in field.

14

13

6

5

7

8

18

17

21

22

John Welch

2²

Gage

Brush

County Road

Sage

Flume

E.F. Loomis

2⁸

27

28

0⁷0⁵

ROWE

2²

Suo-irrigated

Meadow

JOHN DAY

Gravel

1⁵

Brush

Parson Esta
W. L. Wheel
(D.M. Grinds)

RIVER

1³1⁹3⁸3³5³2⁴3⁵4⁵3⁵10²

Charlie Shown

Watering Trough

33

34

Pipe line is not
shown in exact location.1²

12" Pump

C.W. Thomson
(John Hawkins)