


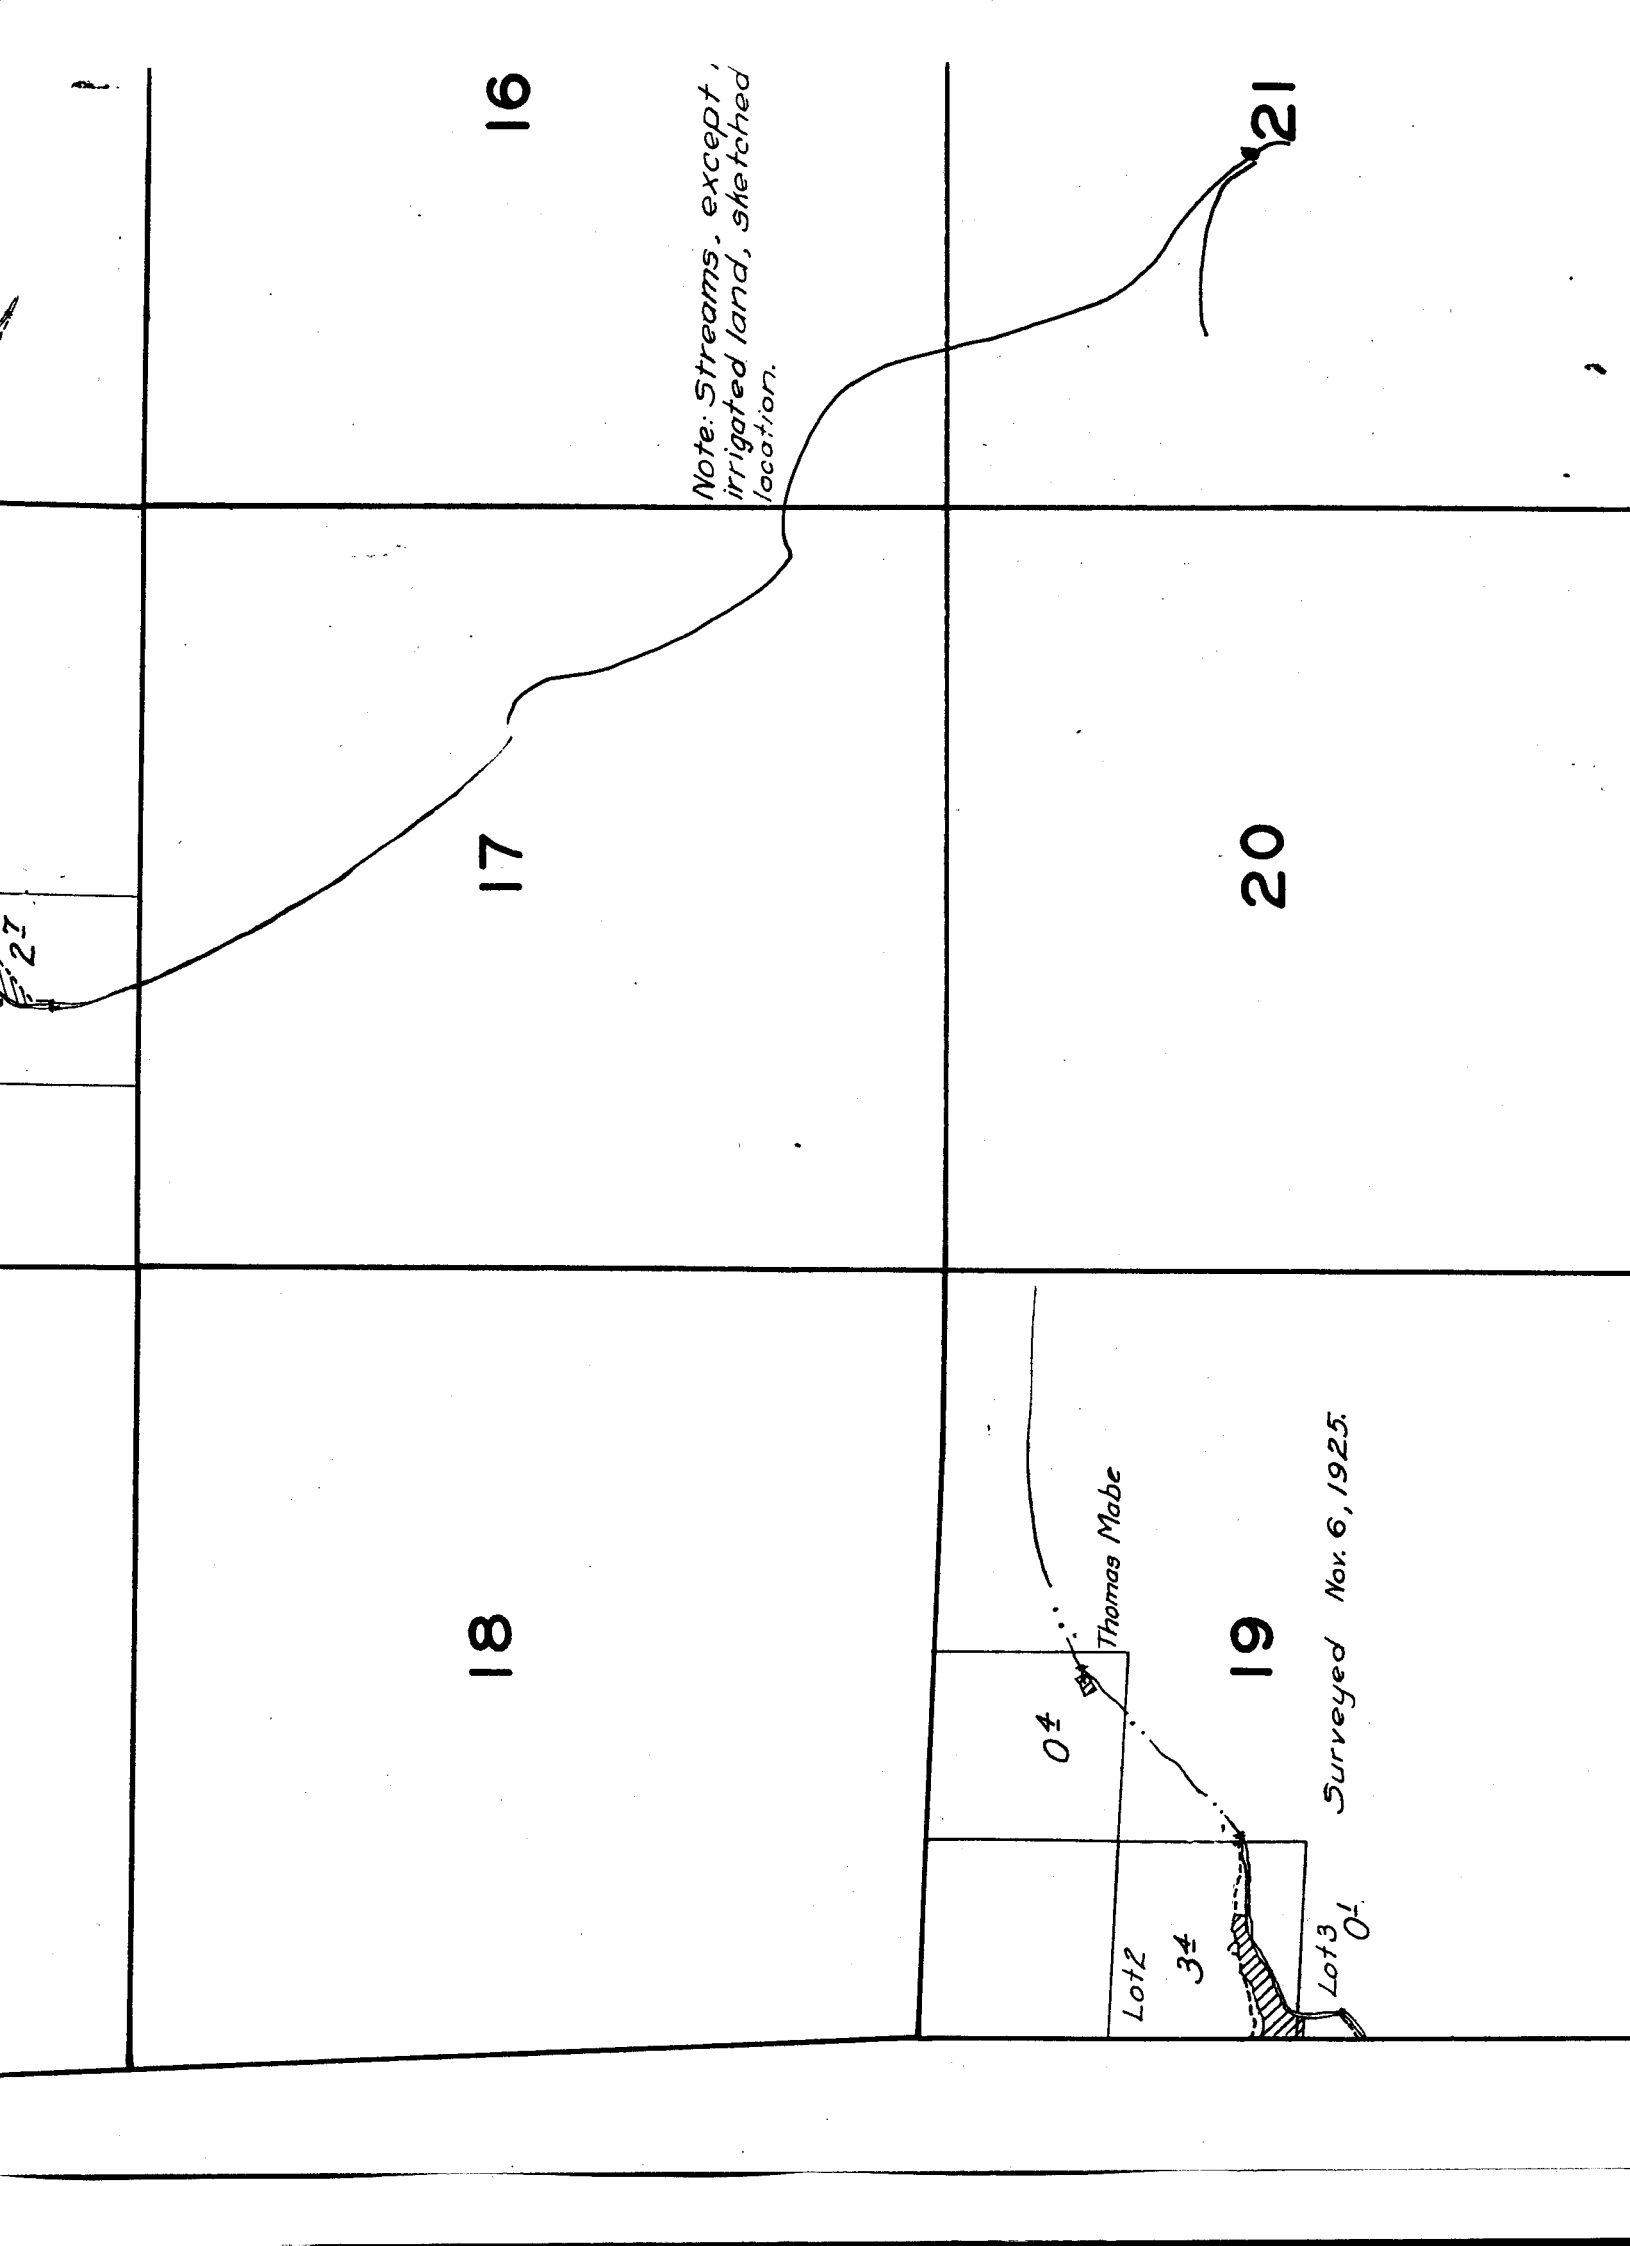

16

*Note: Streams, except,
irrigated land, sketched
location.*

21

17

20

18

19

Thomas Mabe

Surveyed Nov. 6, 1925.

04

Lot 2

34

Lot 3

01


TOWNST

Surveyed Oct. 30 to 1

*Federal Land Bank
(J.I. Thomas)*

၈

2

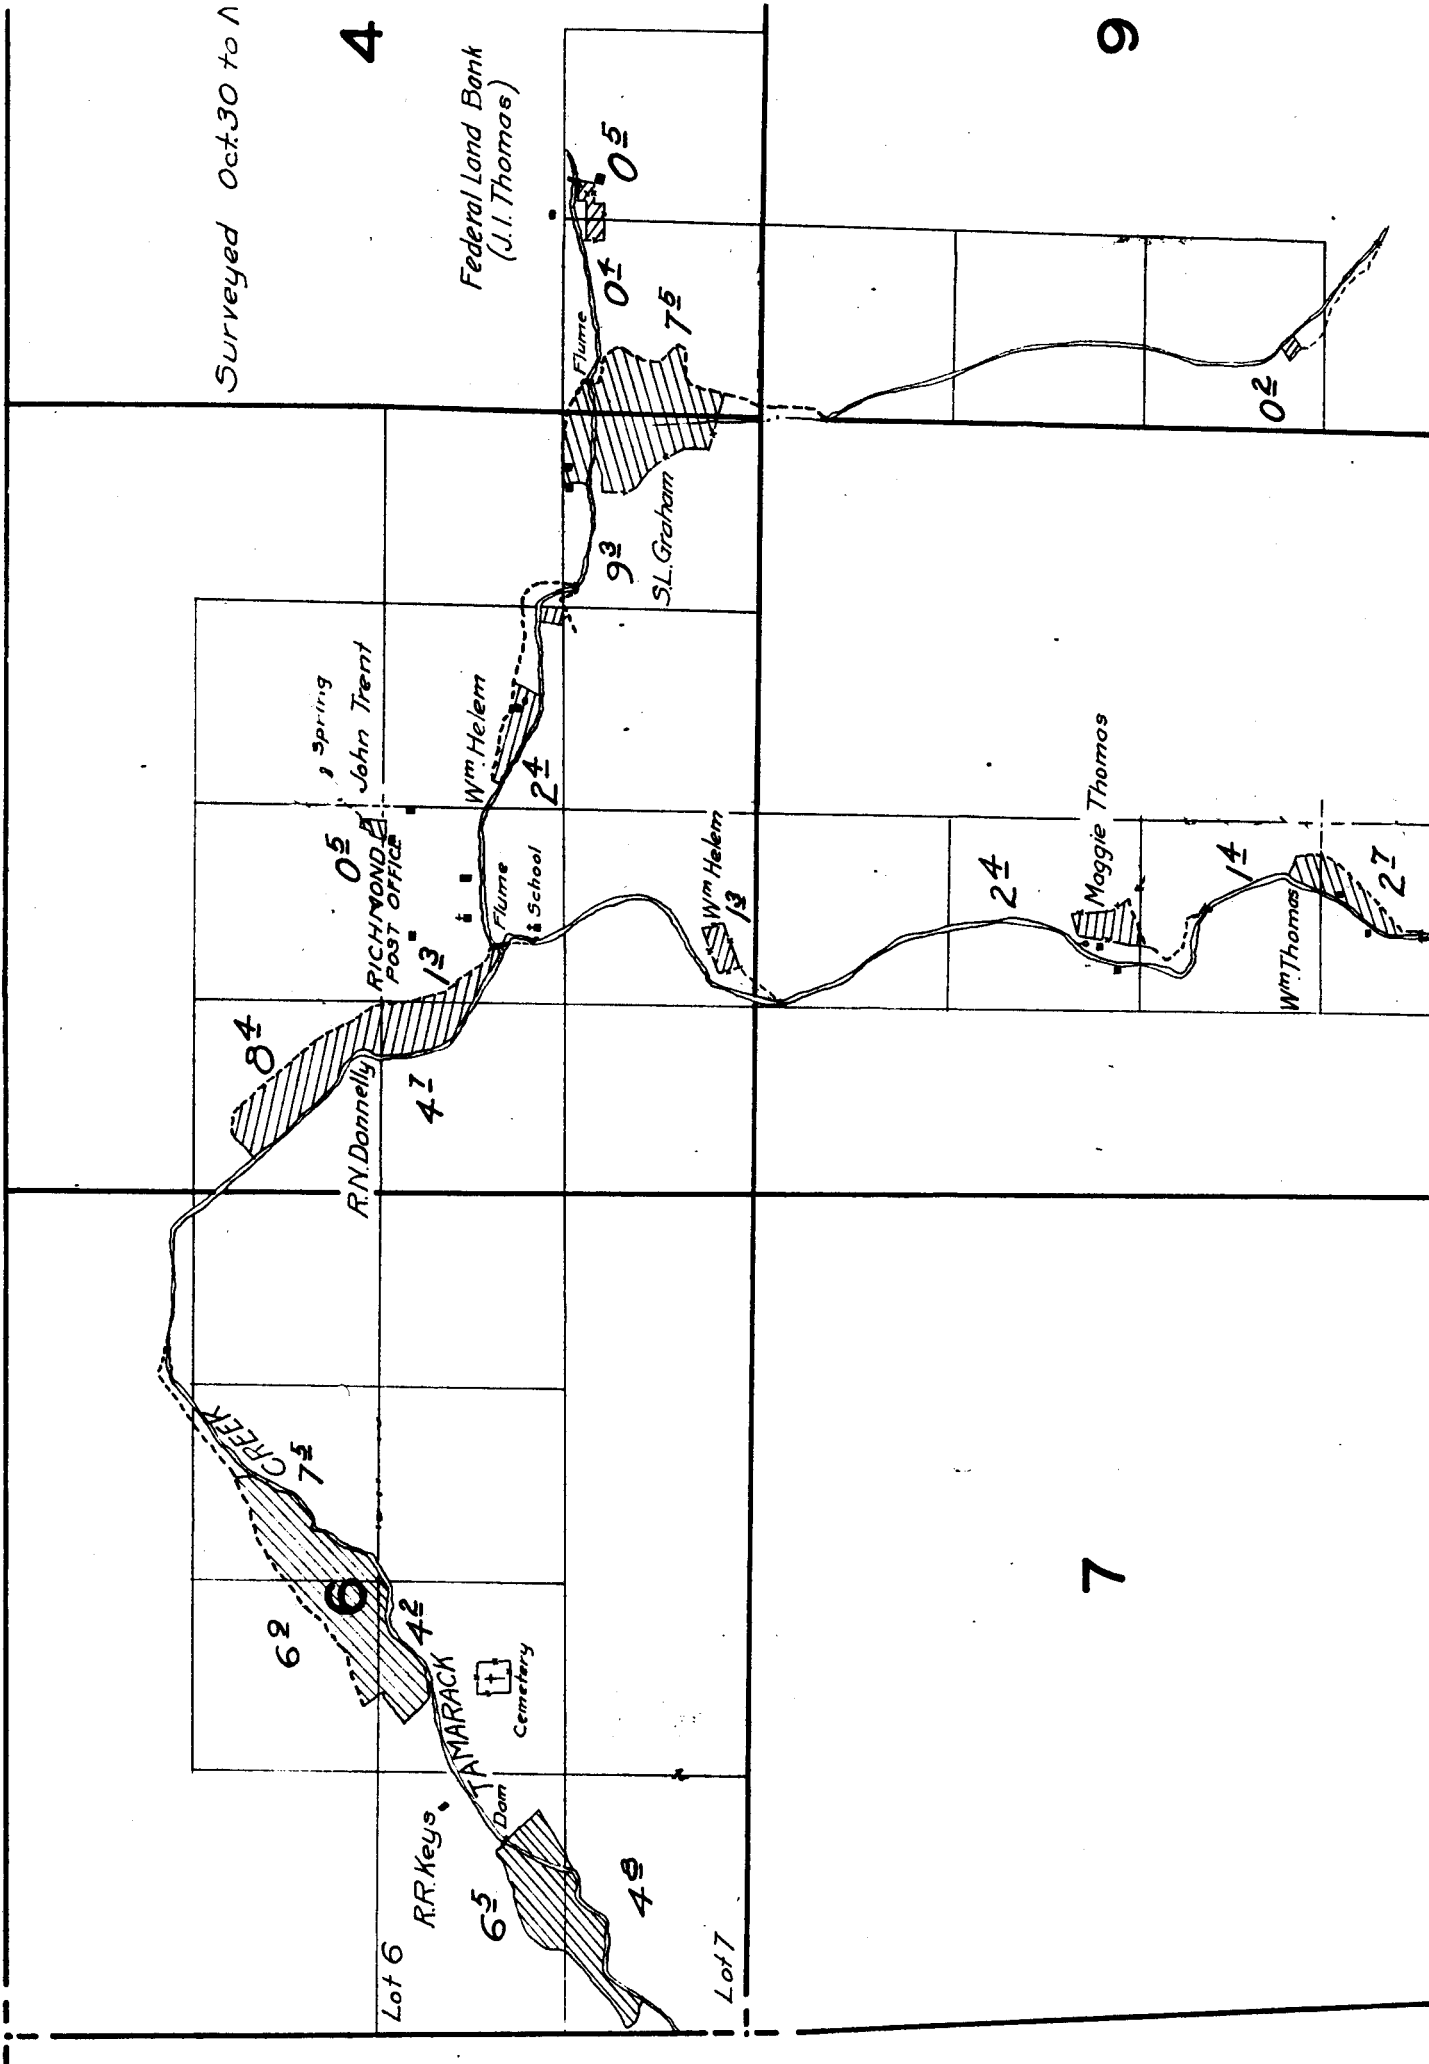


TOWNSHIP 10 S., RANGE 23 E.

urveyed Oct. 30 to Nov. 3, 1925.

4

3

Federal Land Bank
(J.I. Thomas)

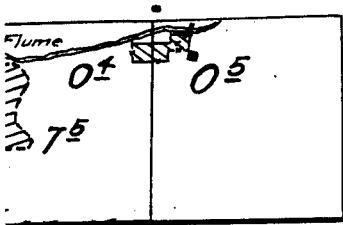

Note: Location of ditch & creek
sketched in field.

Lot 1

Lot 4

74


64

Thick

Pin

9

10

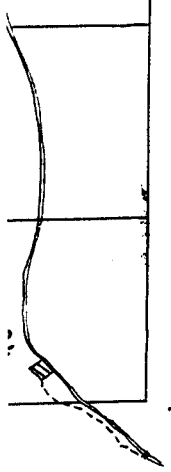

15

14

13


22


23

24

3E 23 E.

76-2-2

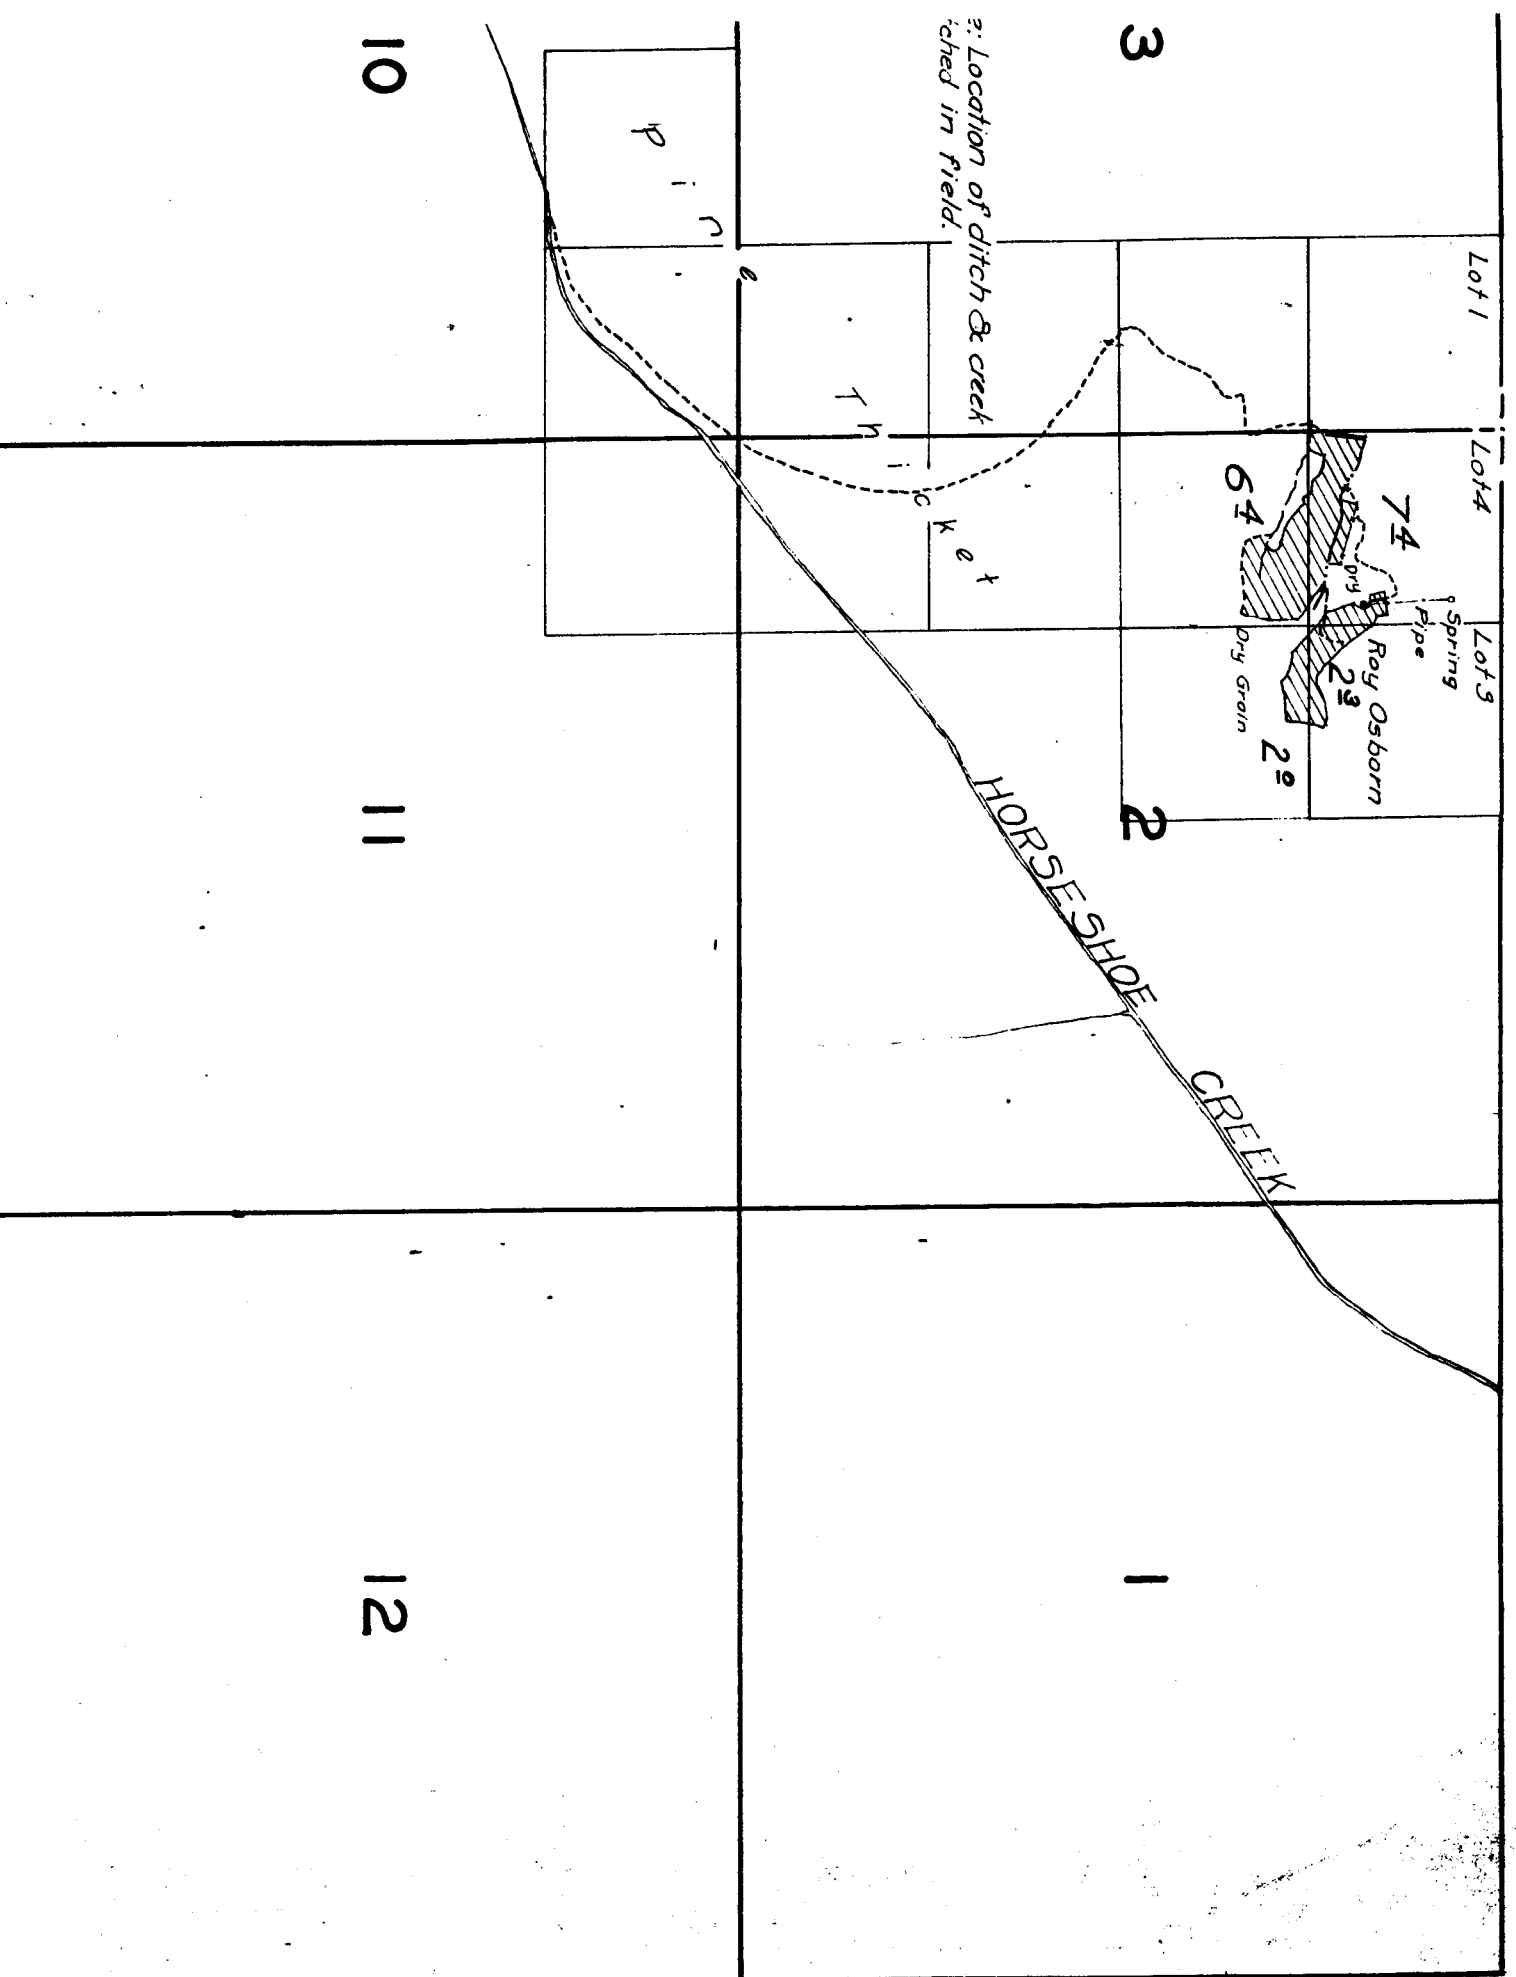

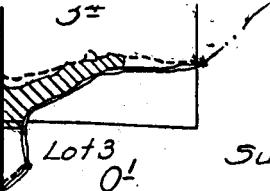


19

Surveyed Nov. 6, 1925.

20

30

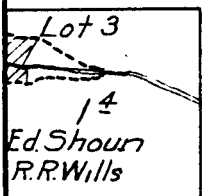

29

31

32

29

28

27

32

33

34

17

16

15

*Note: Streams, except in the vicinity of
irrigated land, sketched in approximate
location.*

20

21

22

23

24

26

25

35

36