

23

24

26

25

35

36


TOWNST

Surveyed Oct. 30 to 1


4

Federal Land Bank
(J.I. Thomas)

9

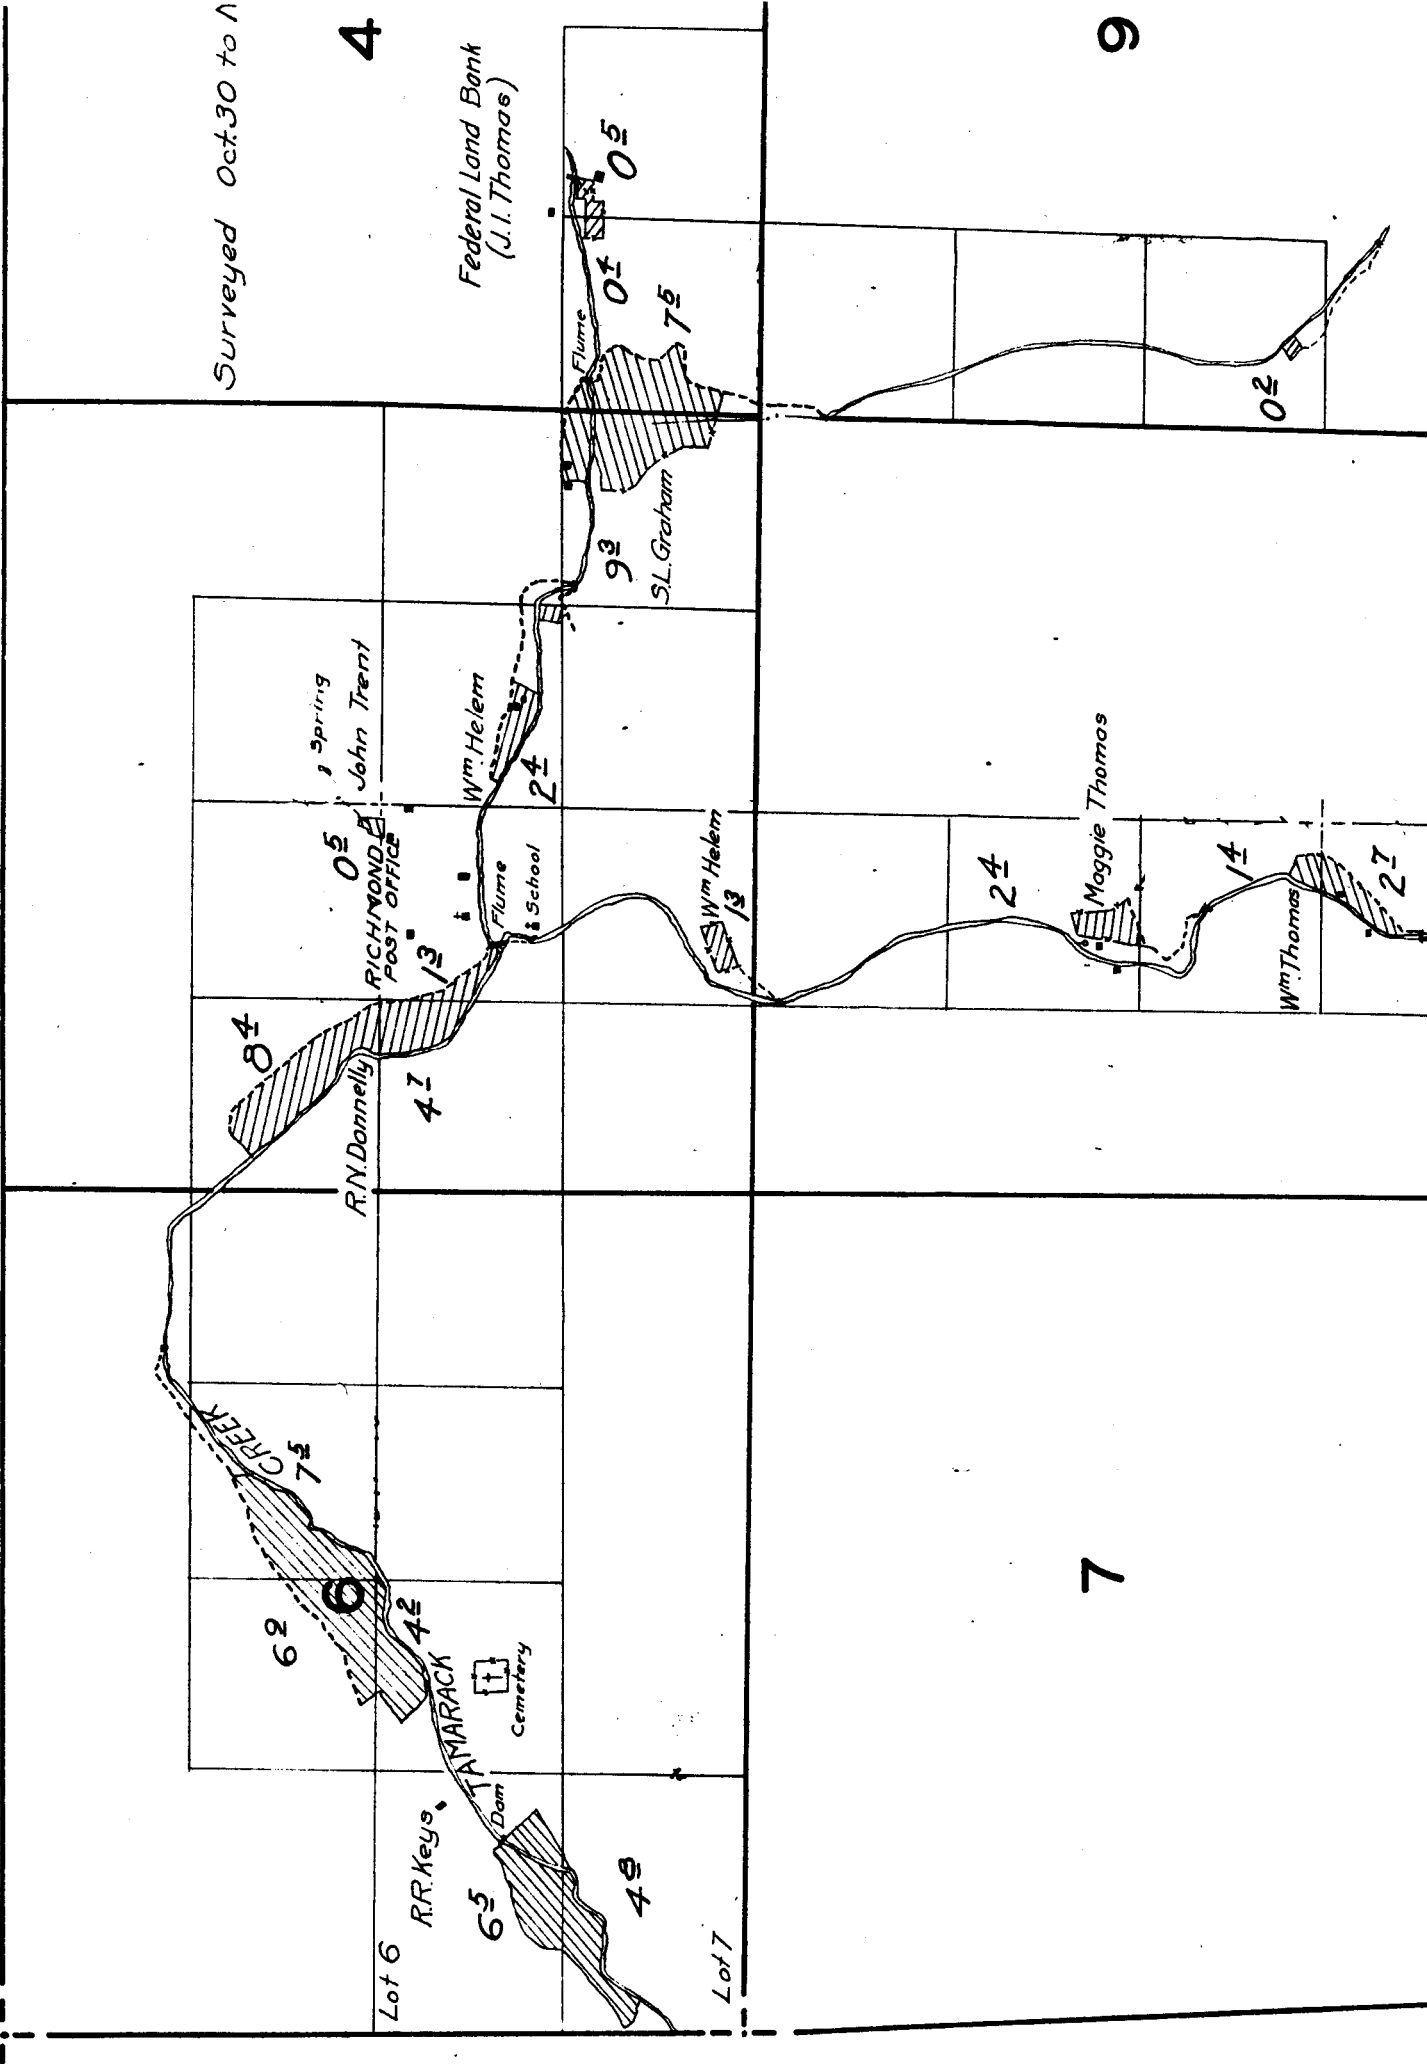

7

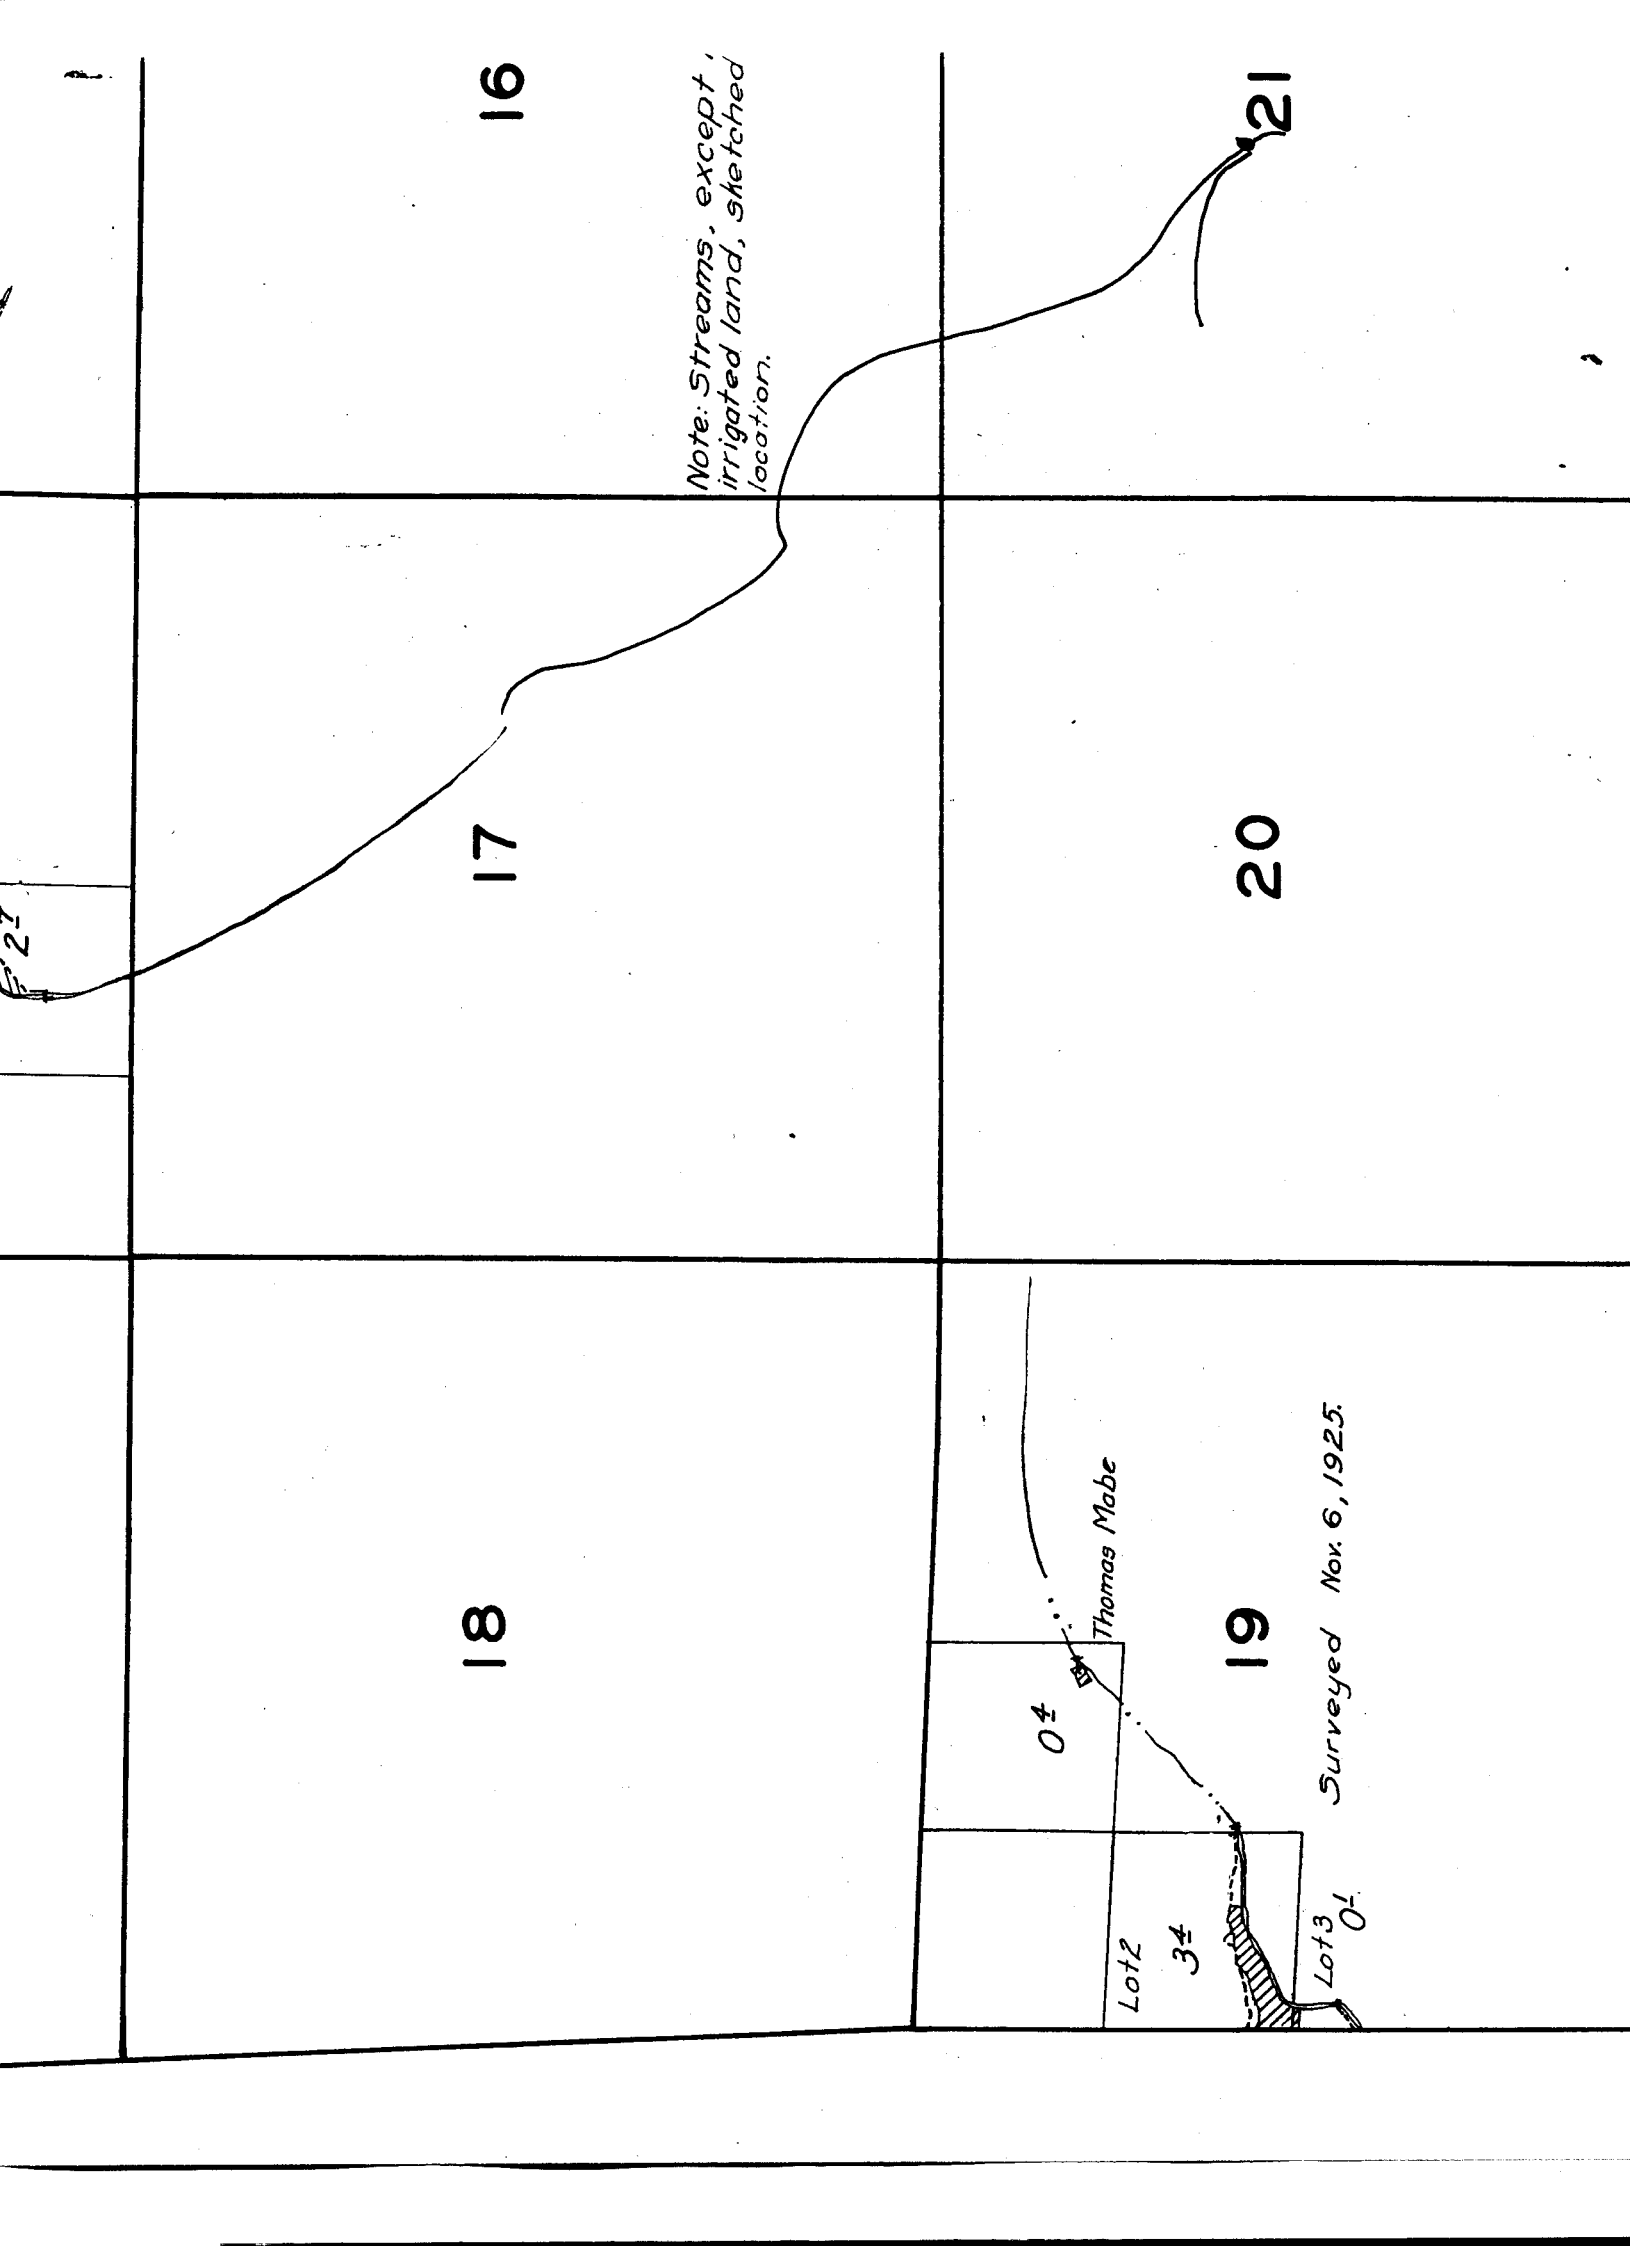

16

*Note: Streams, except,
irrigated land, sketched
location.*

21

17

20

18

19

Thomas Mabe

04

Lot 2

34

Lot 3

Surveyed Nov. 6, 1925.

01

TOWNSHIP 10 S., RANGE 23 E.

urveyed Oct. 30 to Nov. 3, 1925.

4

3

Federal Land Bank
(J.I. Thomas)

Note: Location of ditch & creek
sketched in field.

Lot 1

Lot 4

74

64

Flume
0±
05
75

p i n

Th i c k

9

10

15

14

13


22


23

24

SE 23 E.

76-2-2

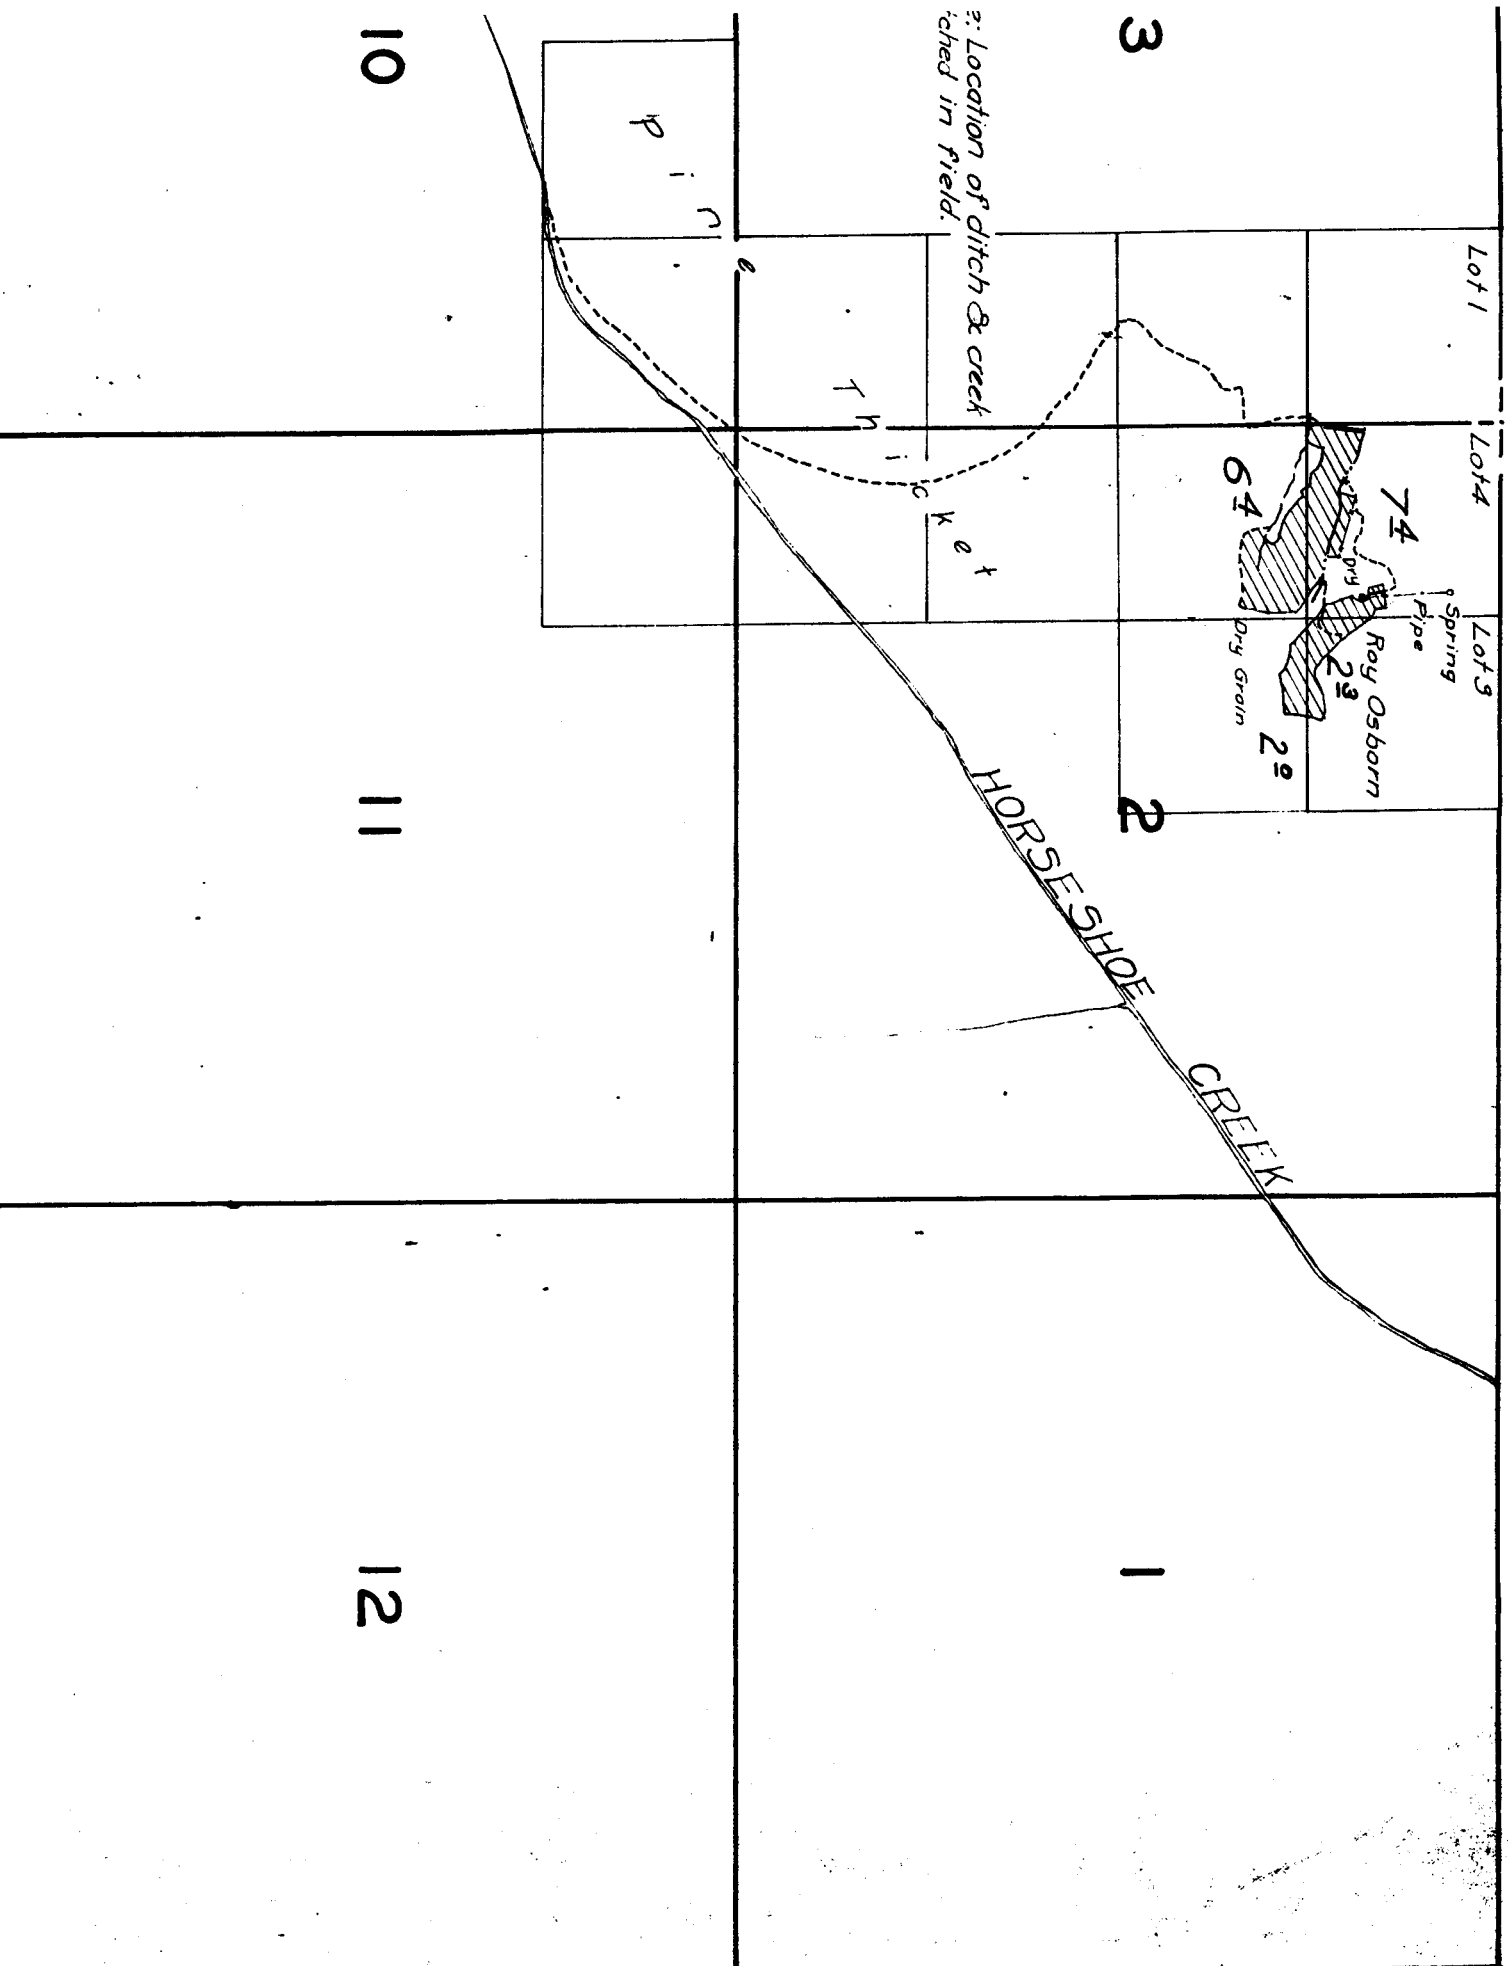

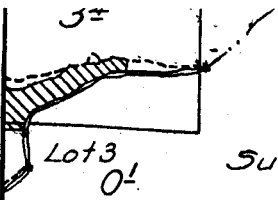


19

Surveyed Nov. 6, 1925.

20

30

29

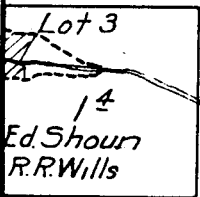

31

32

29

28

27

32

33

34

17

16

15

Note: Streams, except in the vicinity of irrigated land, sketched in approximate location.

20

21

22