

Surveyed - Oct 30, 1925.

27

26

25

34

35

36

DIPPING RACK CREEK

Marion Osborn

Spring

Flume

2°

3°

6°

15°

22°

16°

62

53


Marion Osborn

Spring

20

Line:

10

157

02

22

On

52

163

HORSESHOE CREEK

13

24

14


23

15

22

32

62

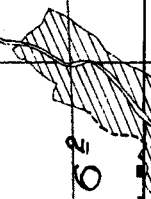

[illegible]

○

35

11

2

32


29

32

30

31

TOWNSHIP 9 S., RANGE 23 E.

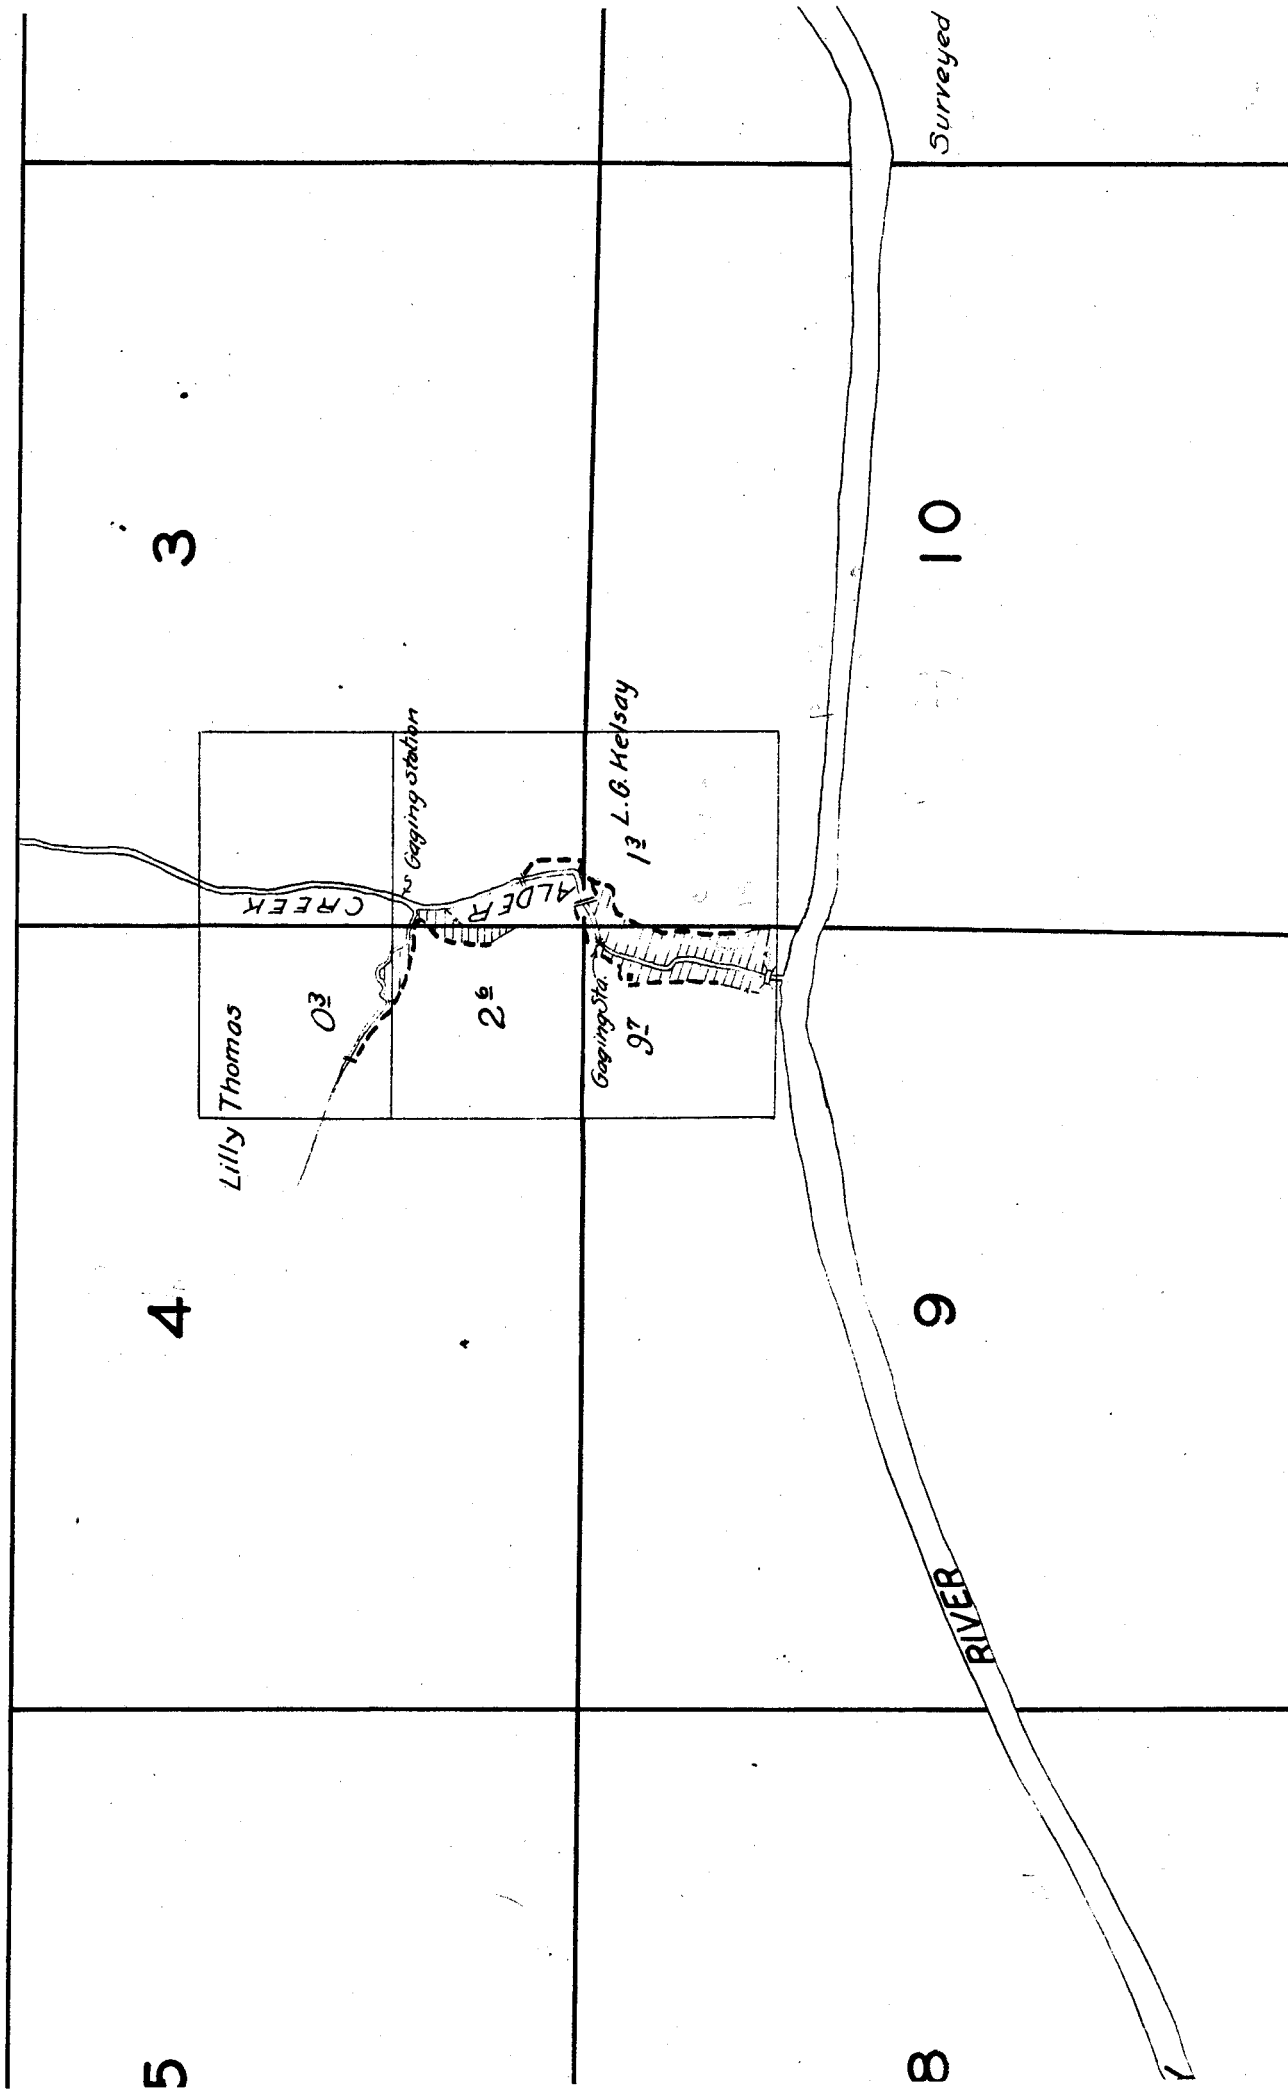

7	NOTE: Streams and river except in the vicinity of irrigated land, sketch in approximate location.	15	
35	21	22	

21

22

28

27

33

34

6

5

Lot 1

Surveyed Oct. 26, 22, 23, 1925.

Lot 2

7

8

DAY
HIGHWAY
SERVICE

Lot 3

M.J. Campbell

Ross Thomas

Lot 4

John Tilley

SERVICE CREEK
POST OFFICE

JOHN

DAY

CREEK

Lot 1

John Tilley

Lot 2

O'Pipe

Keys Donnelly

18

Lot 3

S.J. Howard

Lot 4

17

1 1/2" Pipe

2

1

1^o

2^o

0³

Rock

J.E. Butler
Gage

urveyed Nov. 7 1925.

11

12

0²

L.H. Wright

14

13

HORSESHOE
CREEK