

15

14

13

22

23

24

sketched in approximate
of the vicinity of



12

25

Springs

27


26

25

34

35

36

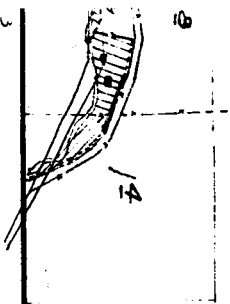

14

13

11

12

2

1

18


17

16

19


20

21

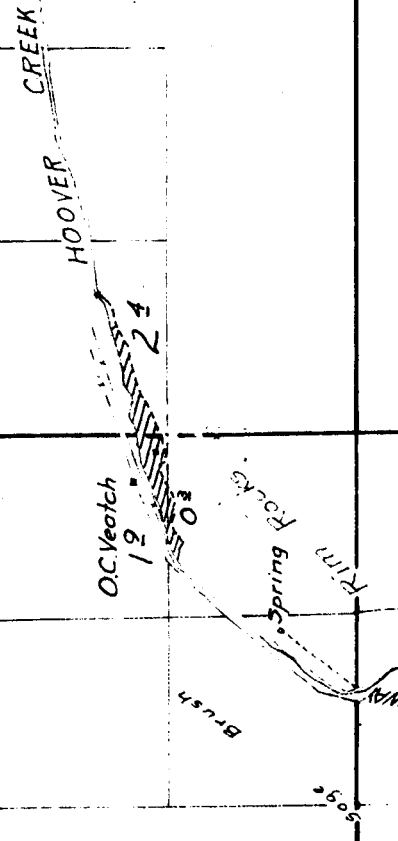


28

Surveyed Nov. 12, 14, 2

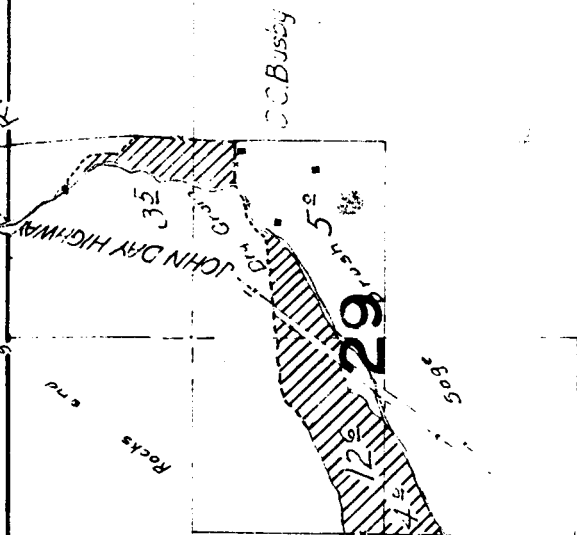

30

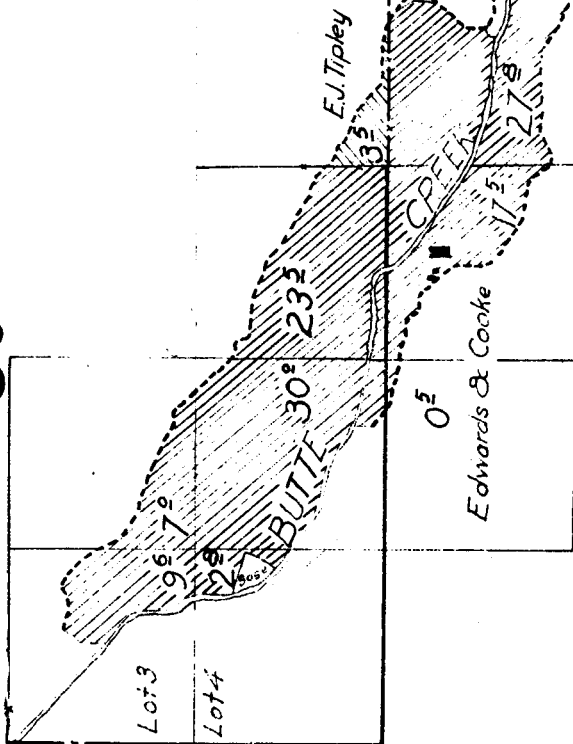


33

FOSSIL


32

31

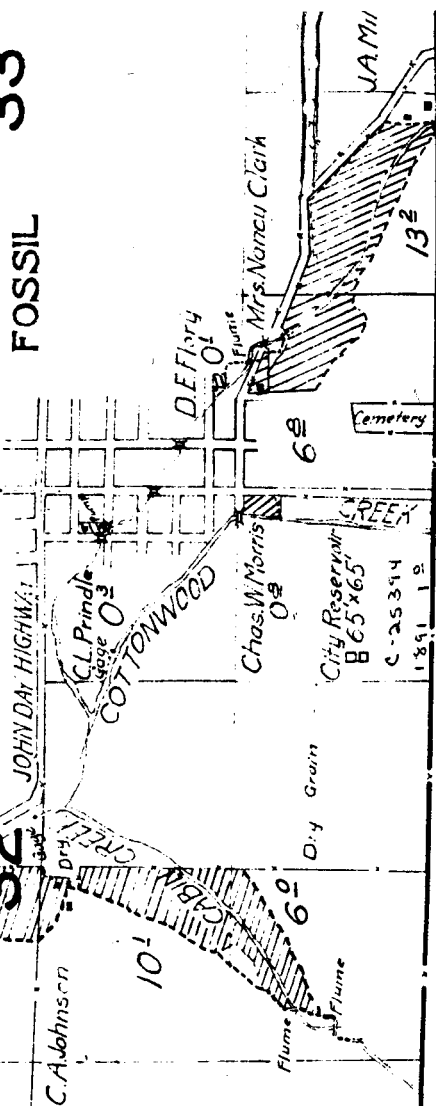

21

22

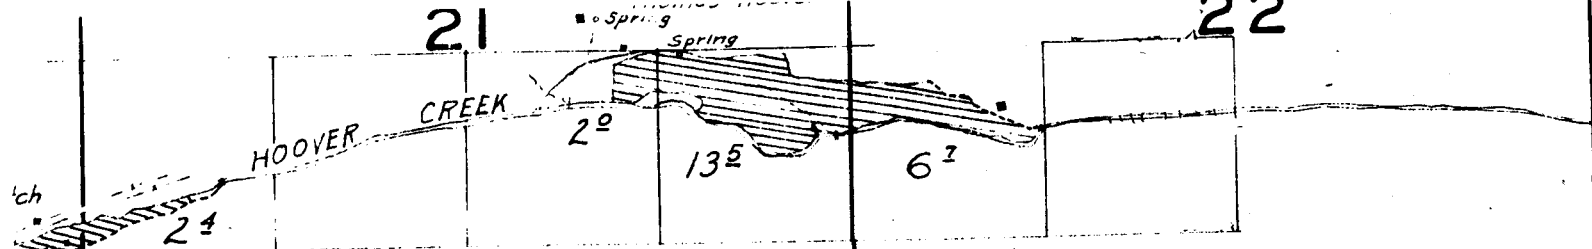

NOTE: Streams sketched in approximate location except in the vicinity of irrigated land.

28


27

Surveyed Nov. 12, 14, 20, & 21, 1925.

FOSSIL

33

34

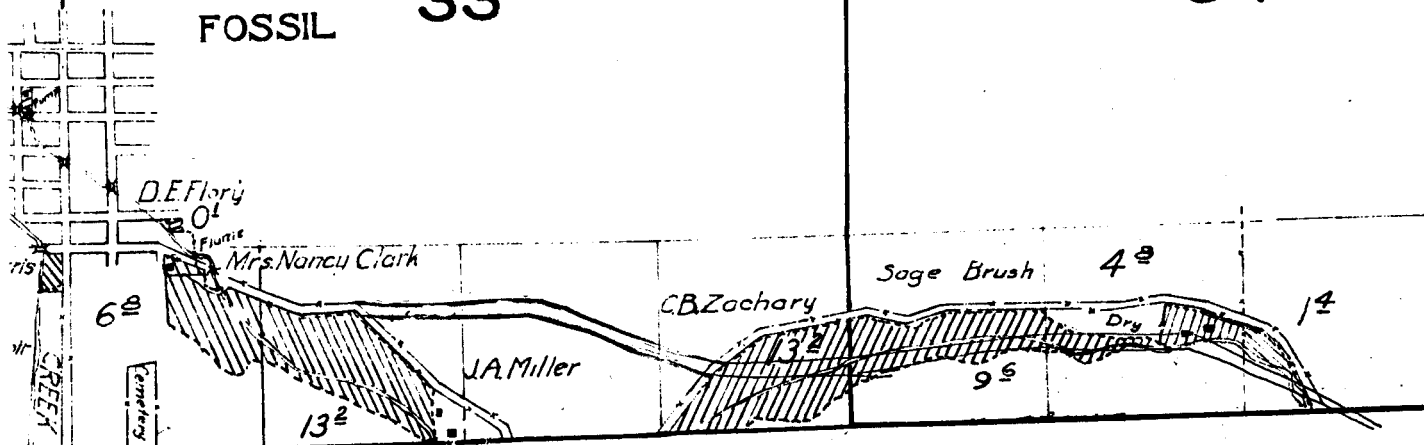

TOWNSHIP 6 S., RANGE 21 E.

4

3

9

10

15

16

22

Thomas Hoover
Spring

21

CREEK

HOOVER

20

13E

61

O.C. Veatch
12

21

02

Spring

Focus

pm

Brush

NOTE: Streams sketched in approximate location except in the vicinity of indicated land.

6

5

7

8

18

17