


6

5

7

8

18

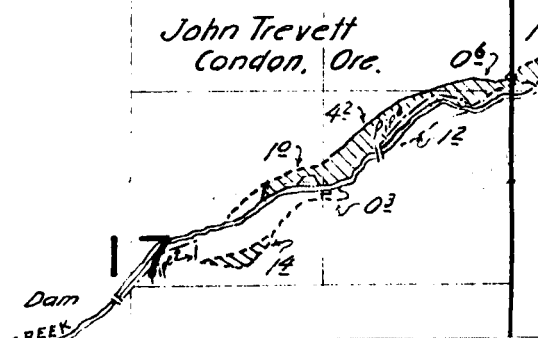

21

22

Surveyed May 12 and 13, 1925.



*Brown-Smith
fence line*


28


27

33

34



TOWNSHIP 3 S., RANGE 22 E..

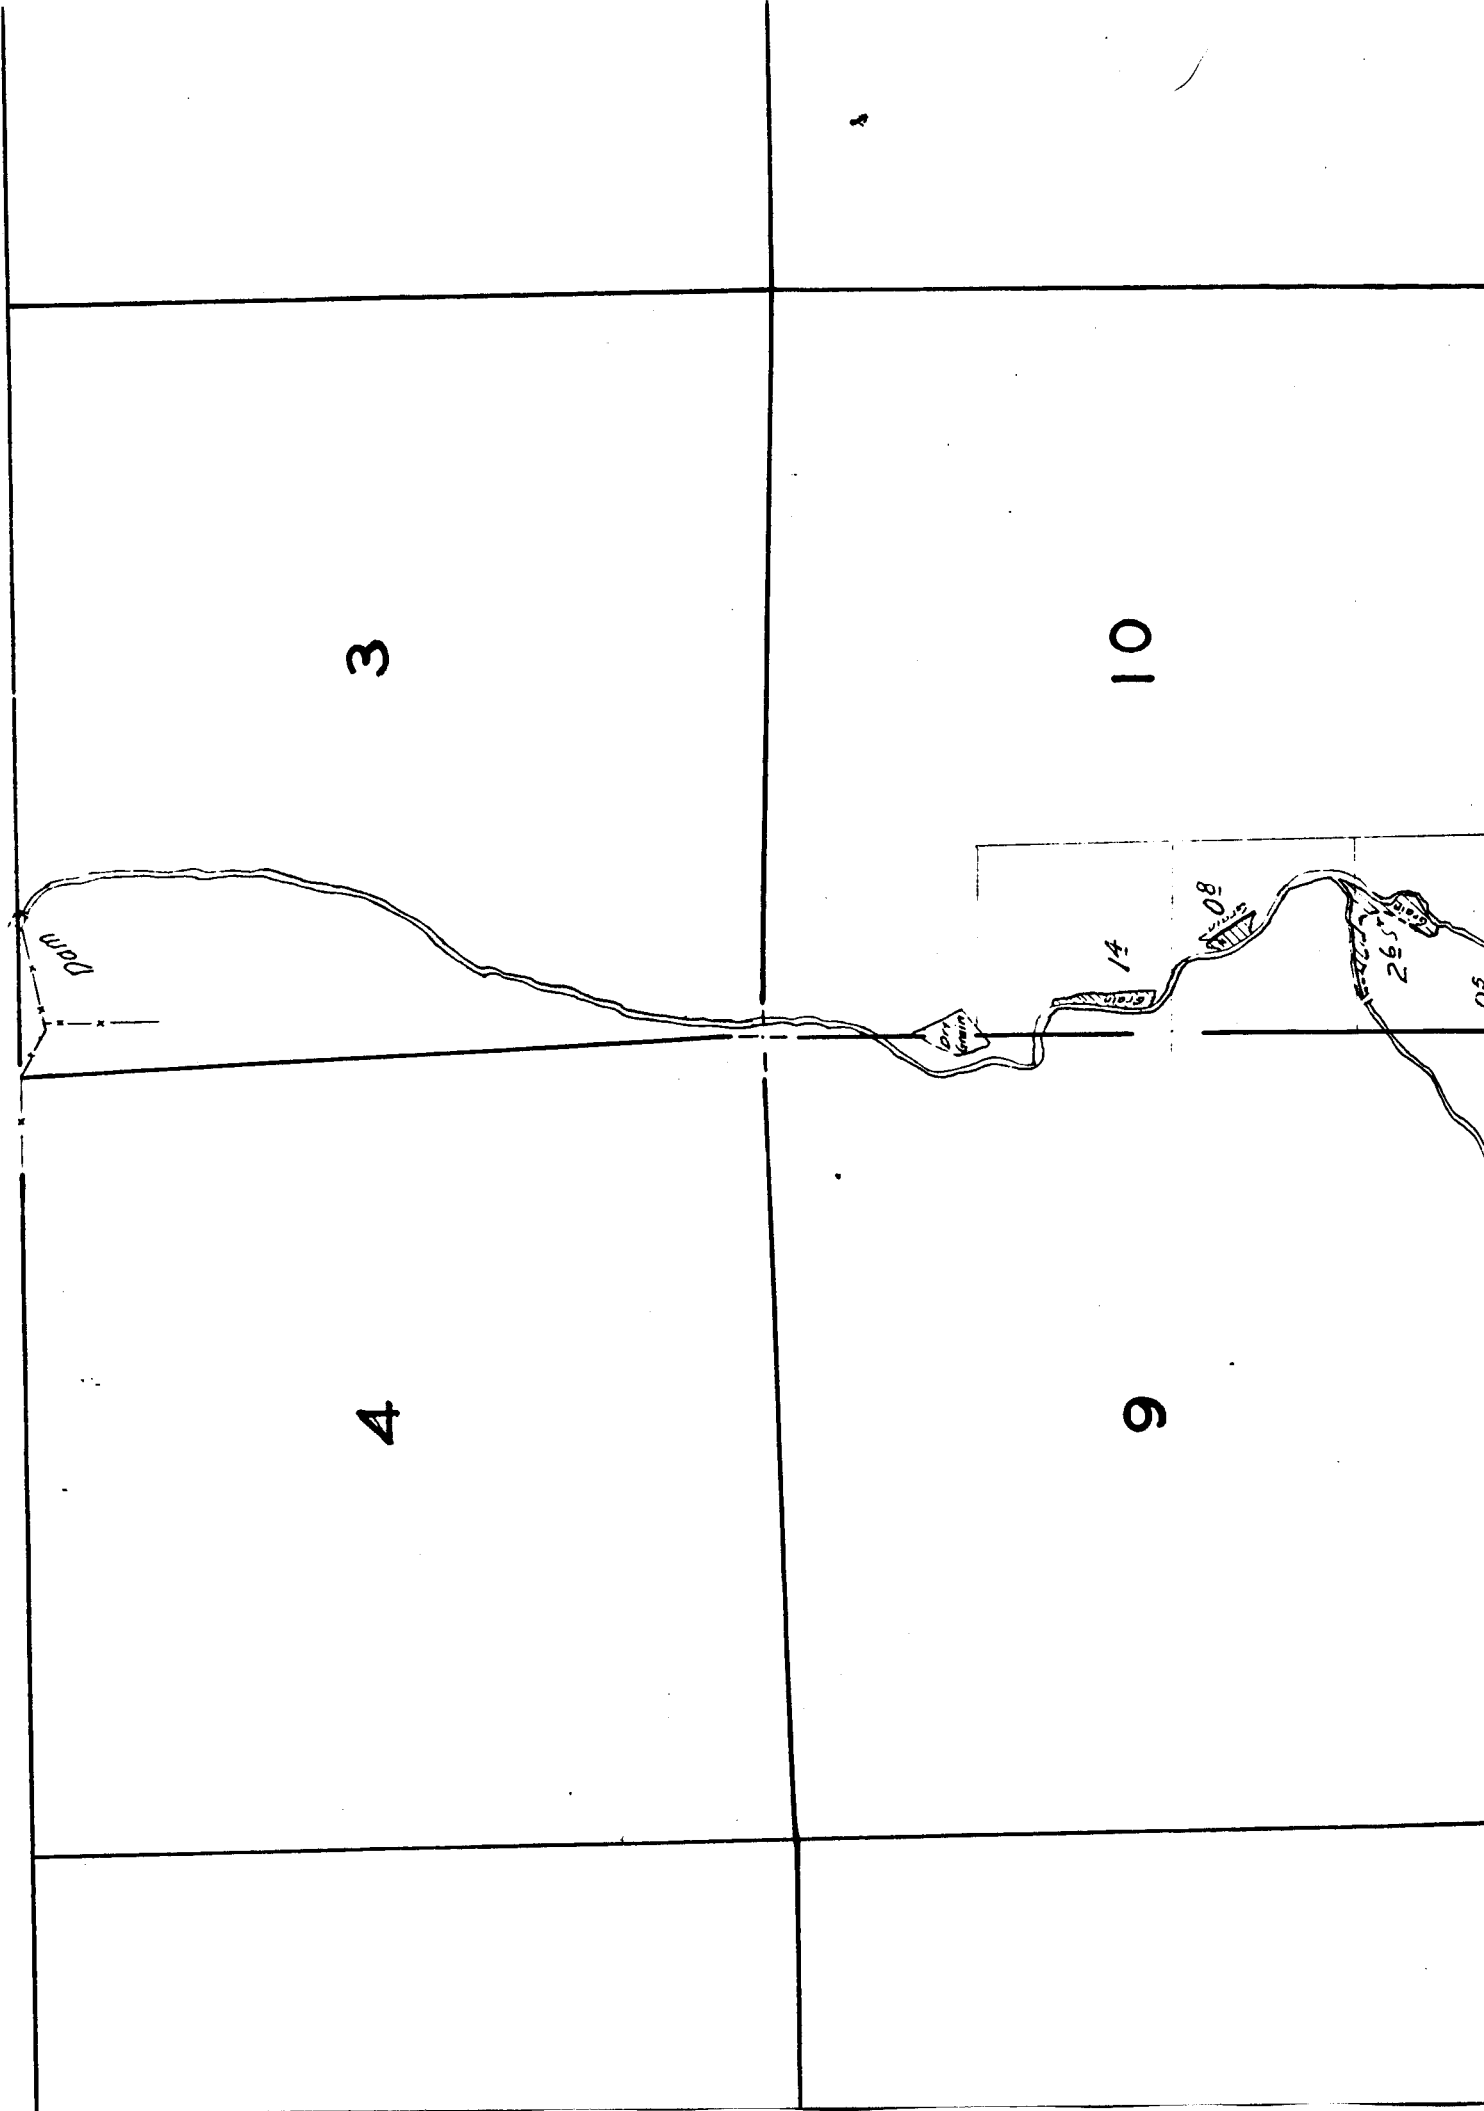

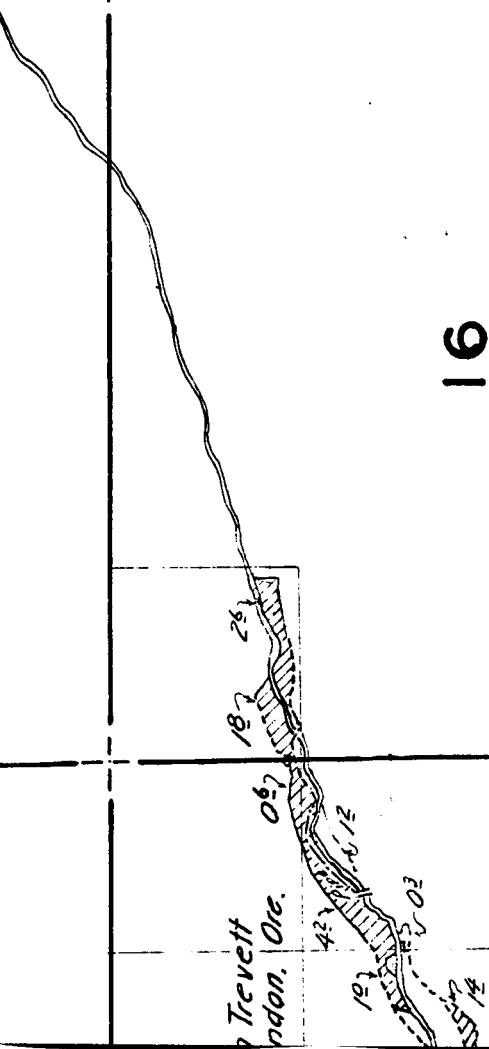

16

Note:
Streams, except in the vicinity
of irrigated land, are sketched
in approximate location.

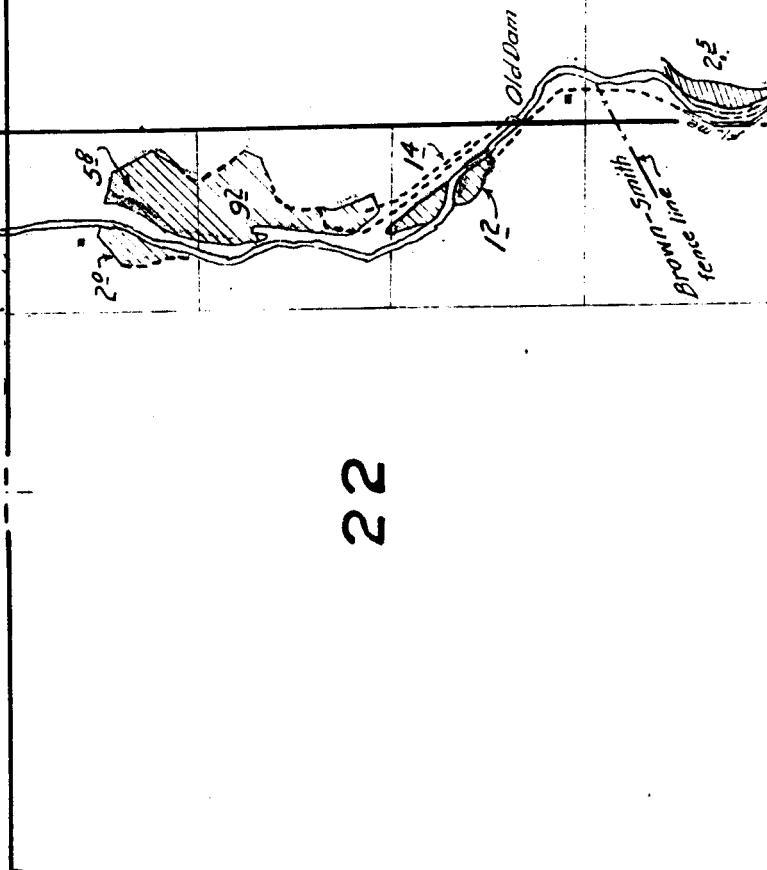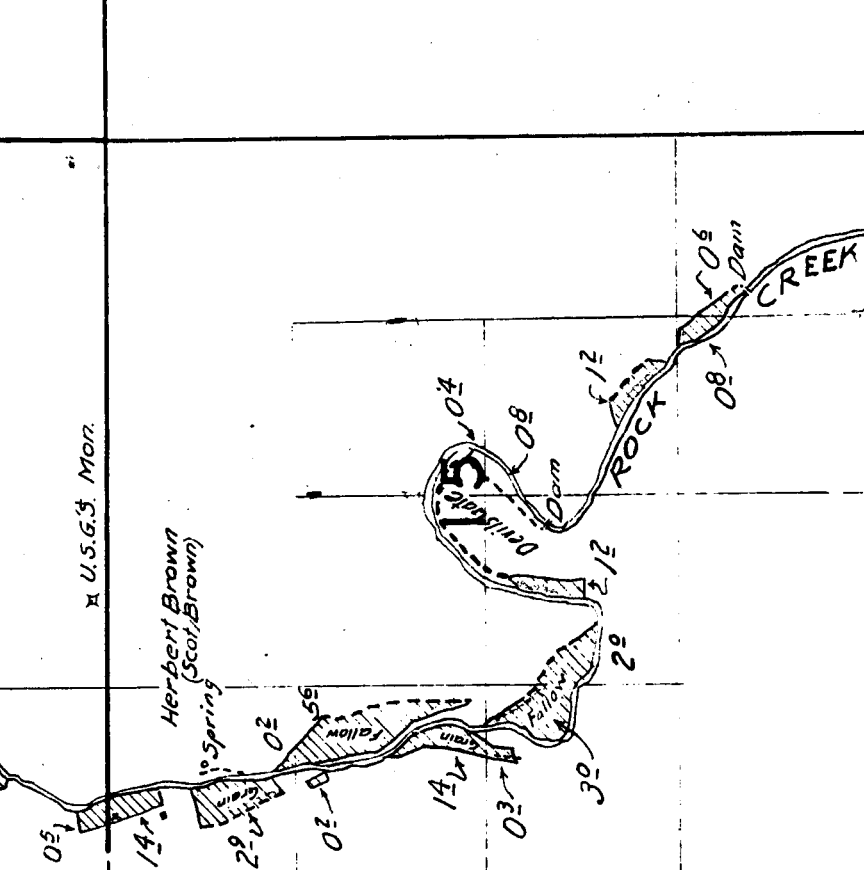

21

Surveyed May 12 and 13, 1925.

22

30

29

28

31

32

33


18

19

20

16

21

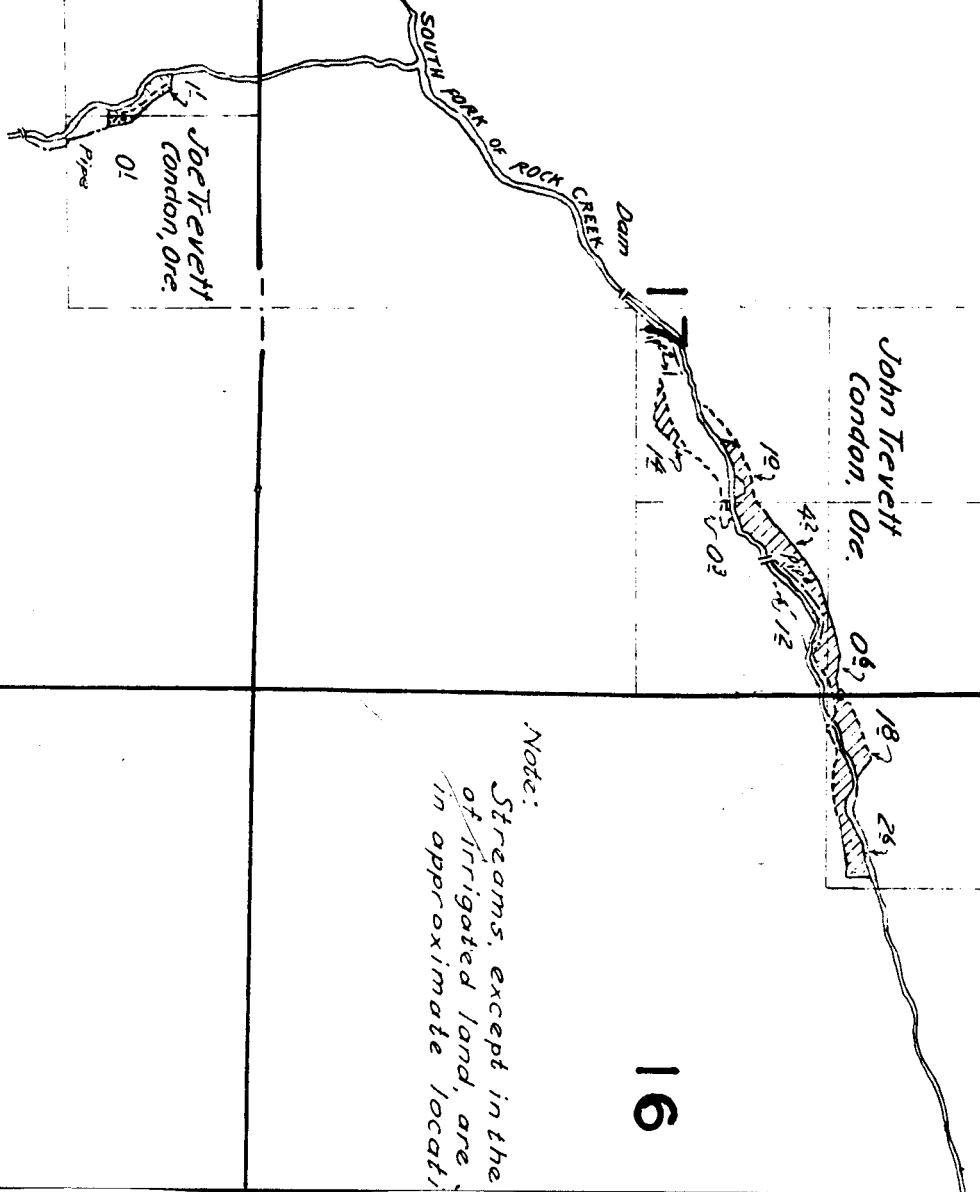

Note:
Streams, except in the
of irrigated land, are
in approximate locati

Surveyed May 12 and 13


27

25


34

35

36

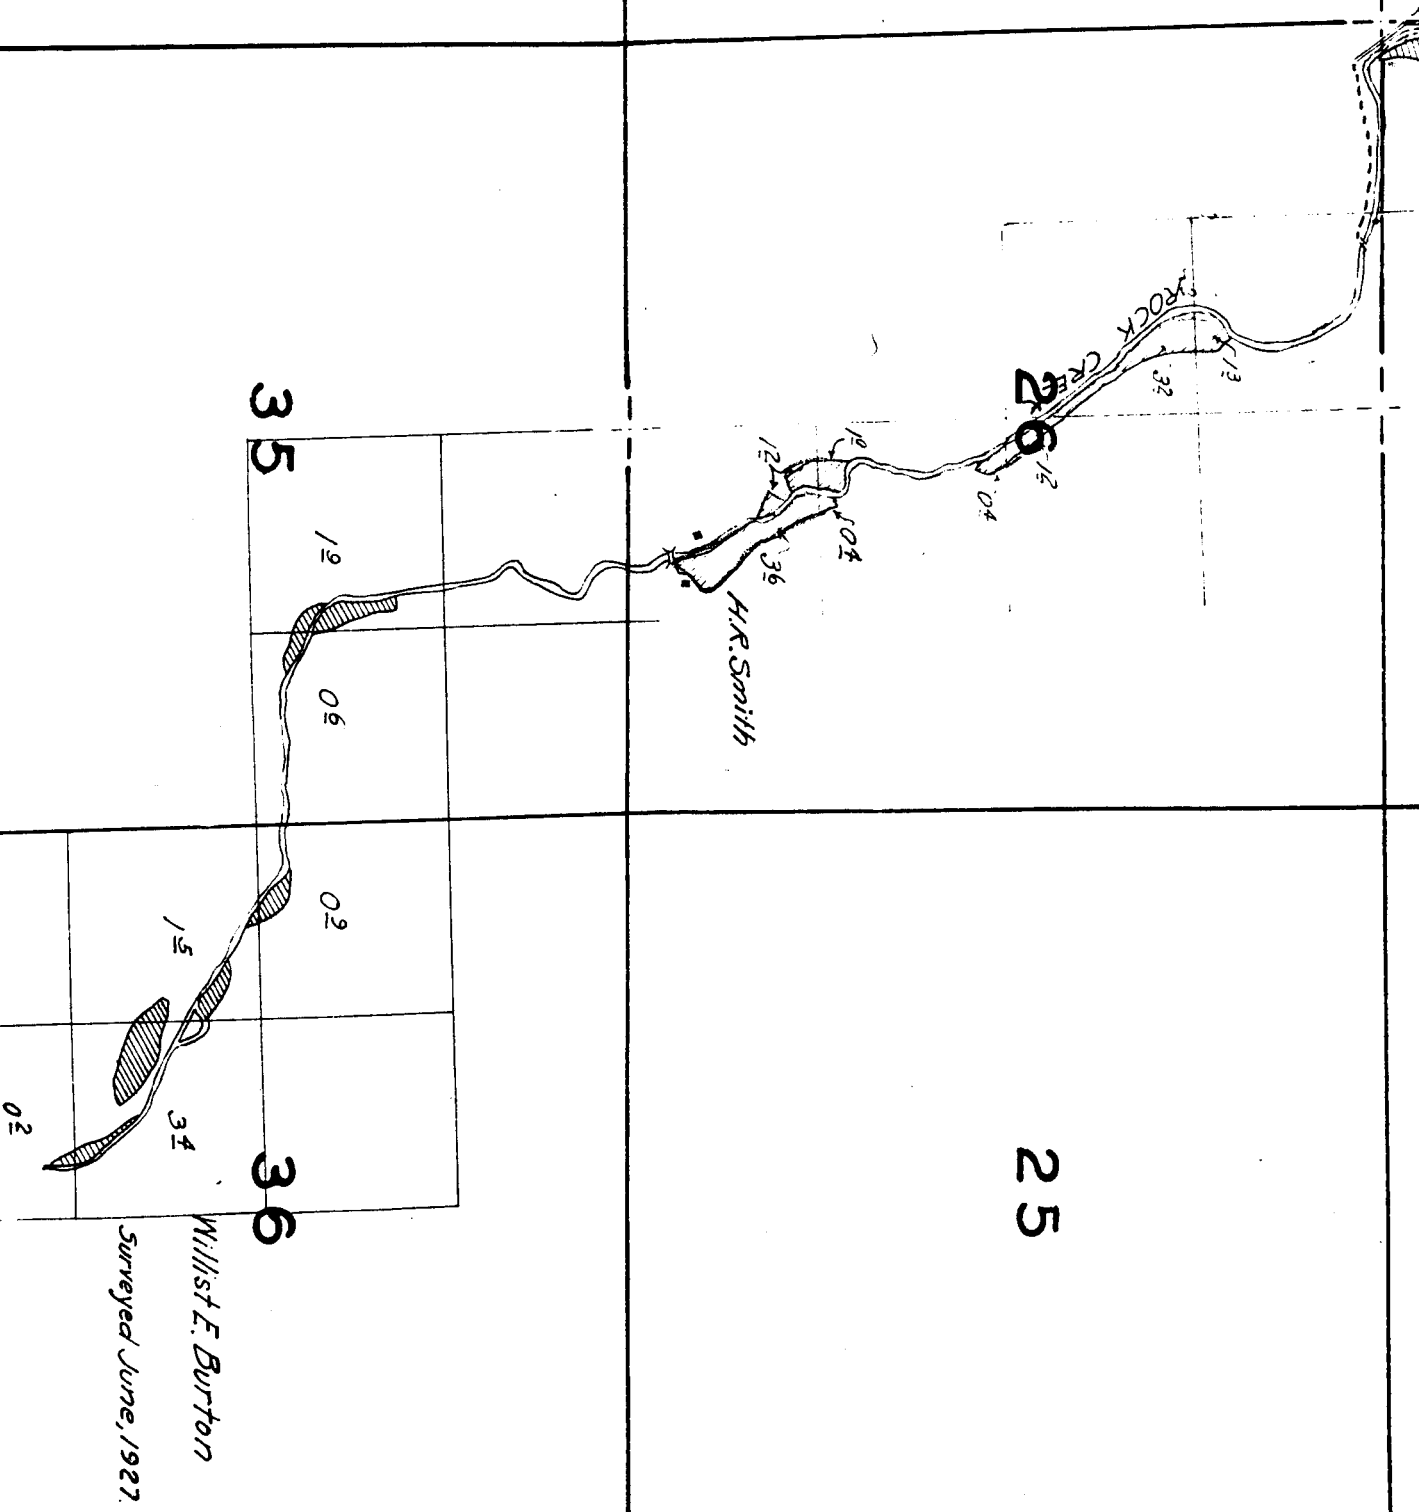

BROWN
(brown)

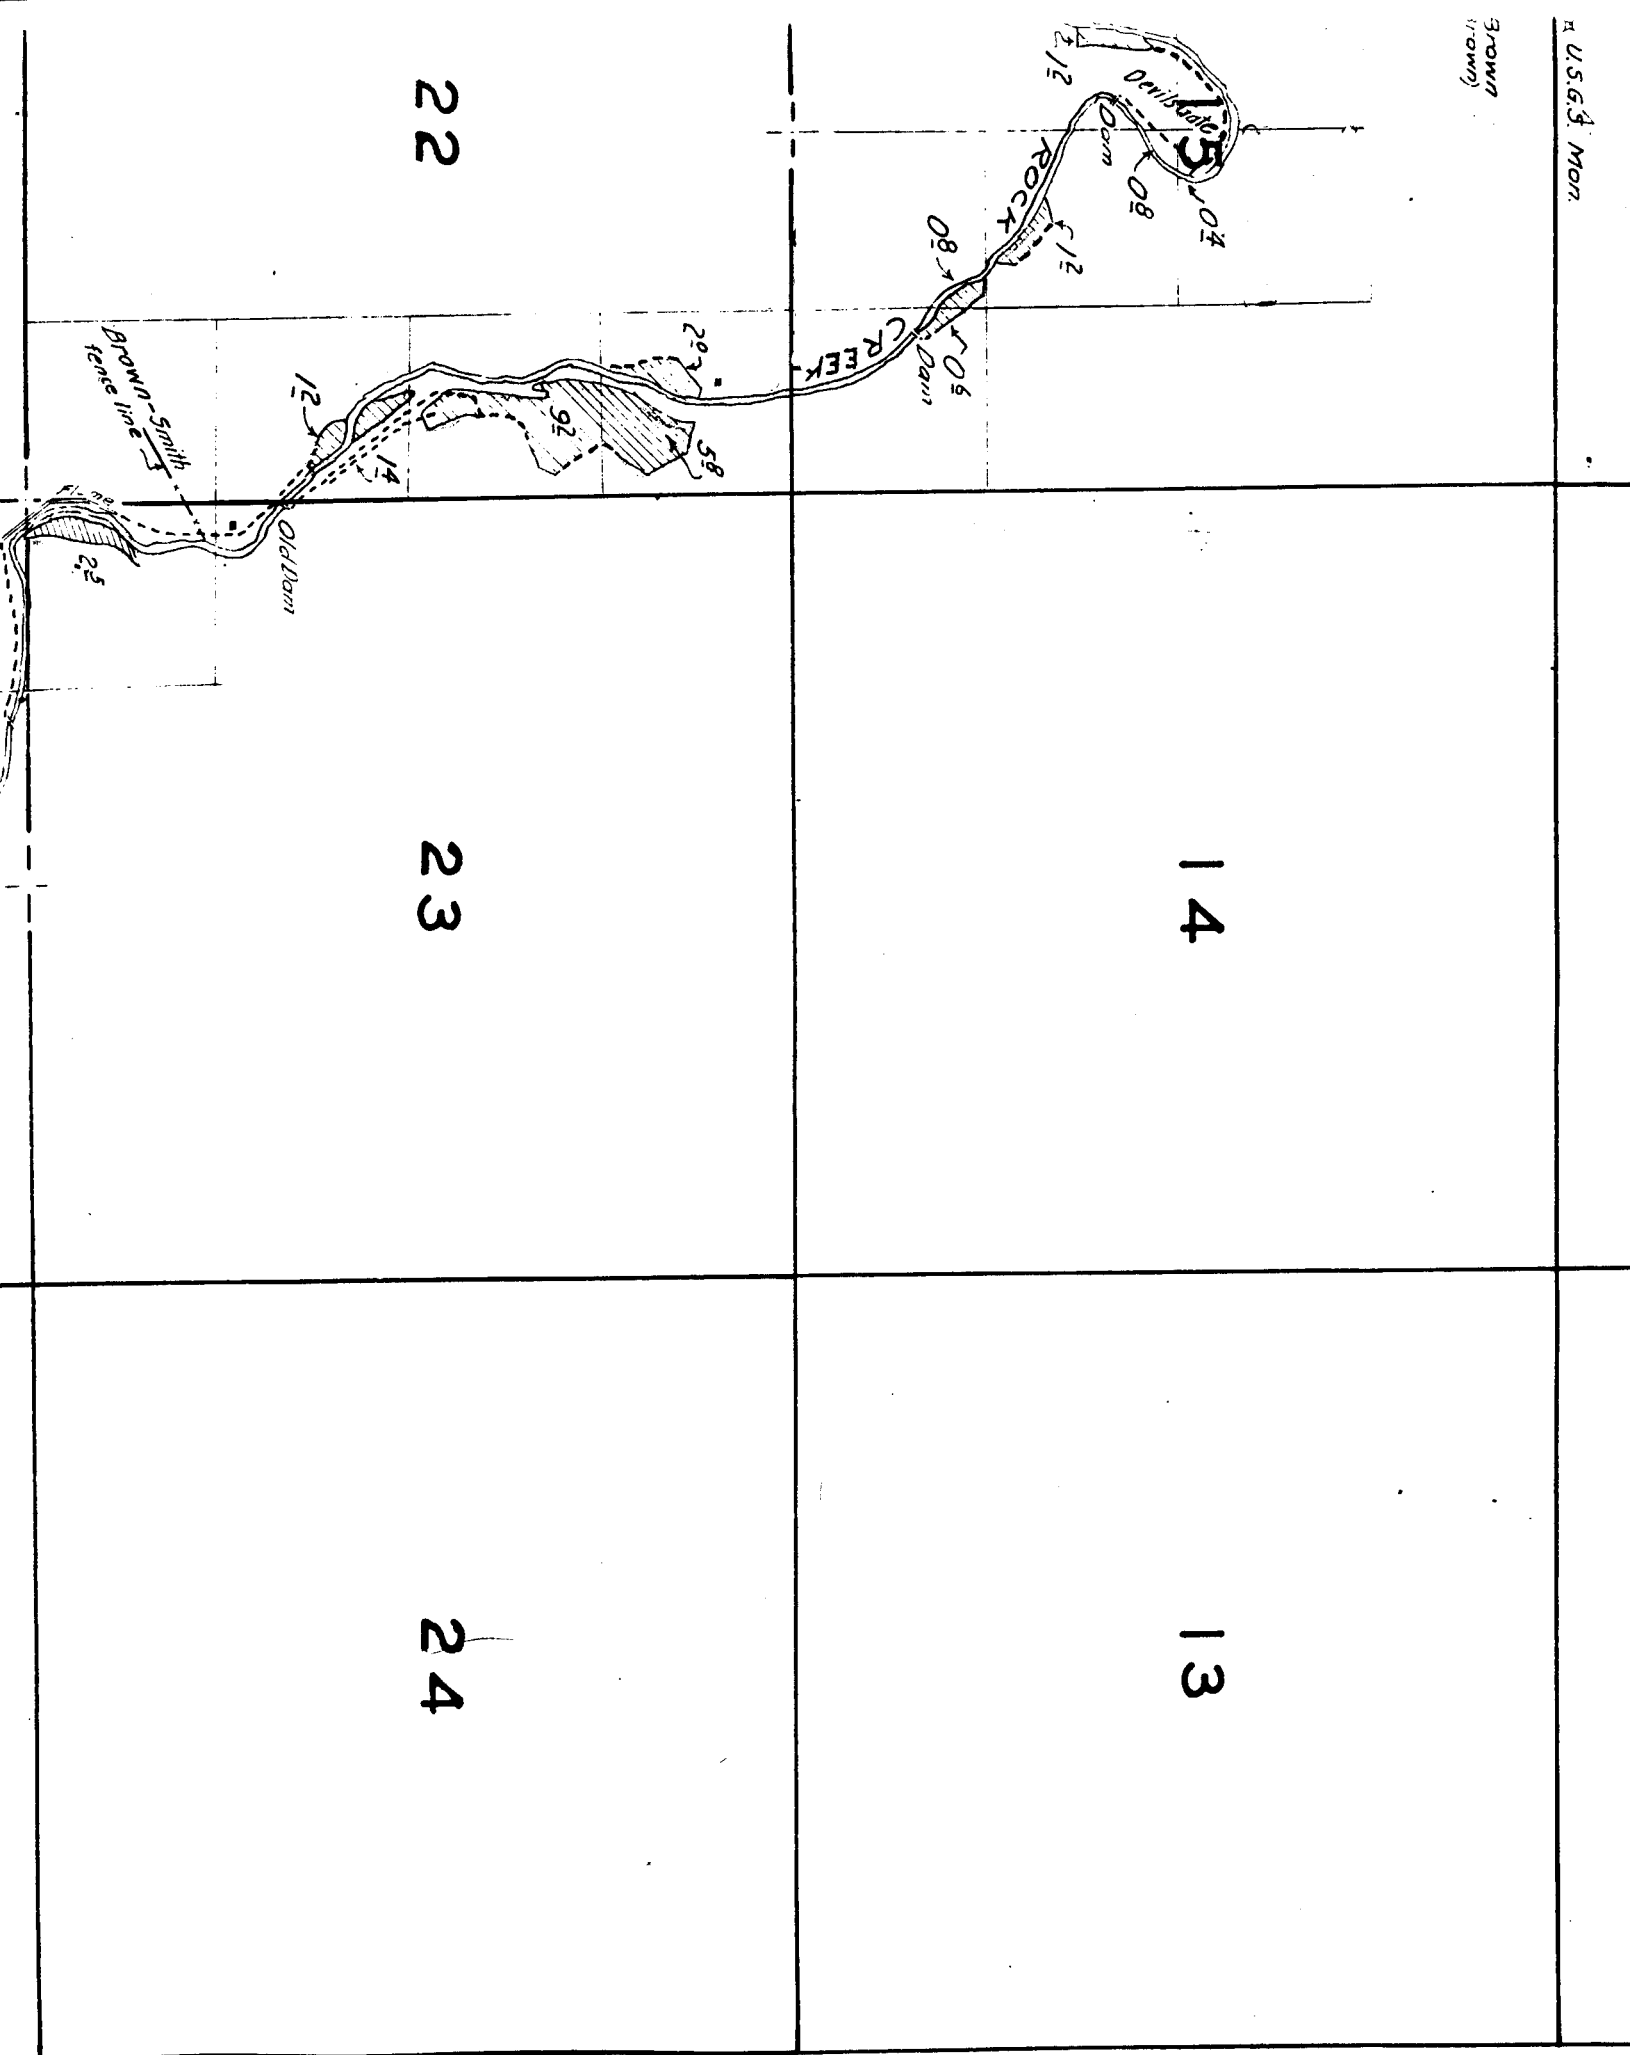

2

1

11

12

14

13