

15


14

22

23

24

Location according
to Mr. Boll

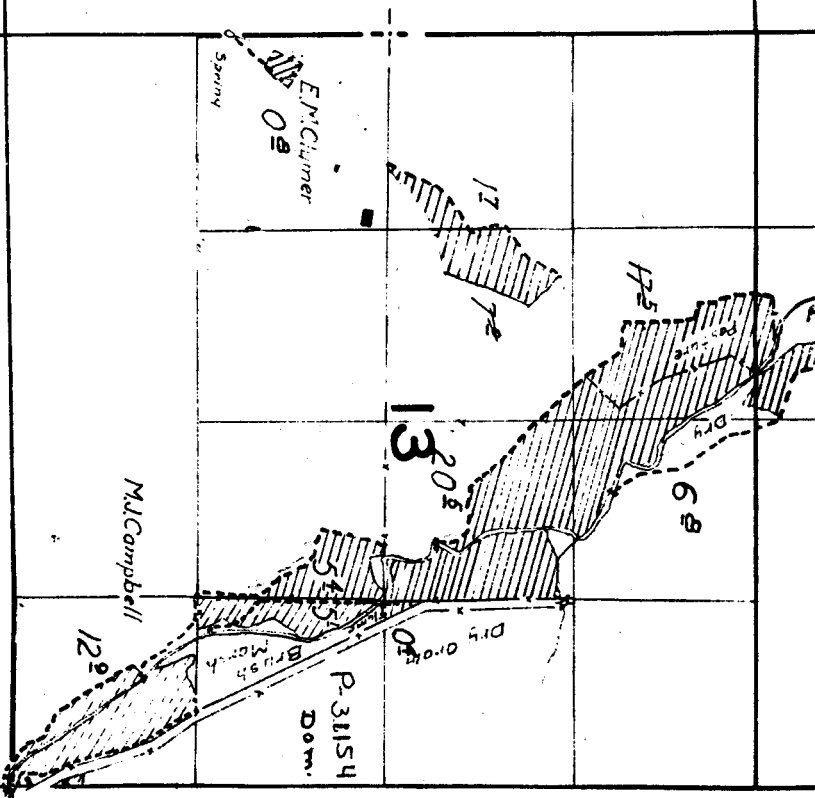

27

26


25

34

35

36

Note: Streams not in the vicinity of irrigated lands sketched in approximate location.

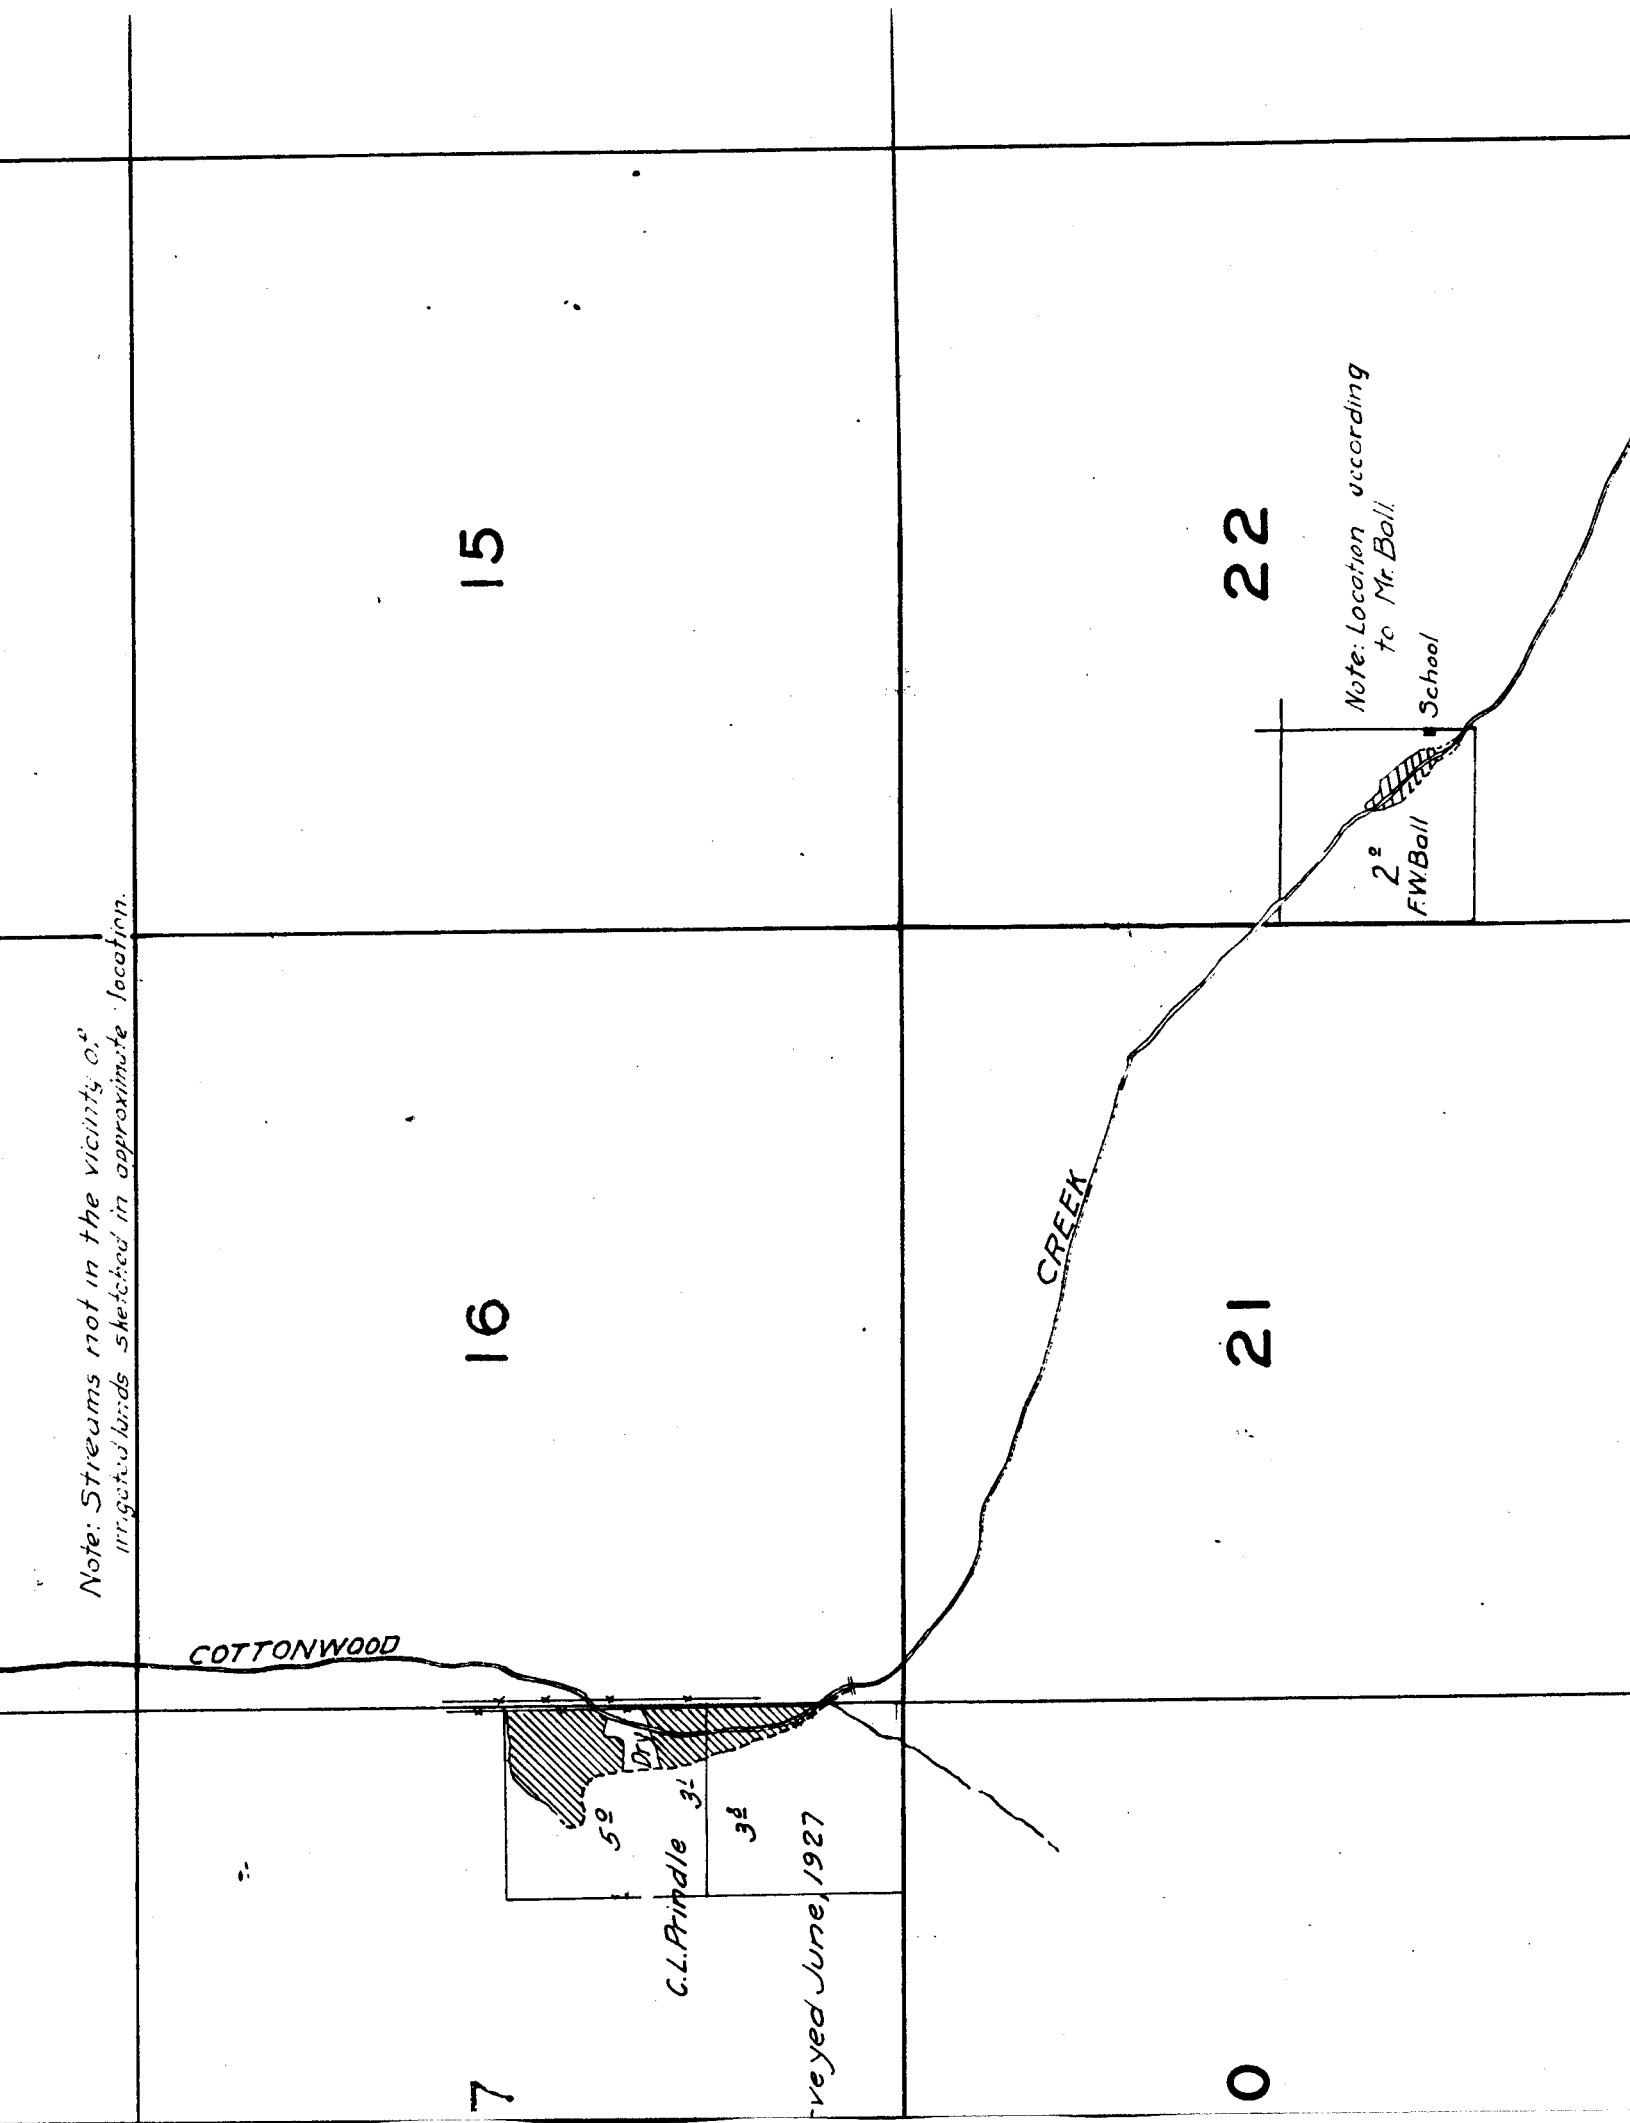


Note: Streams not in th.
irrigated lands sketched.

COTTONWOOD

18

17

16

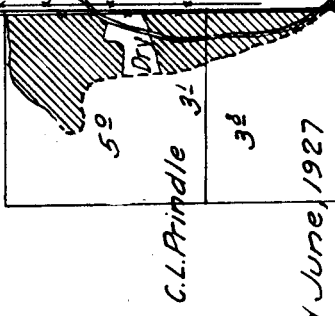

19

20

21

30


29

28

31

32

33

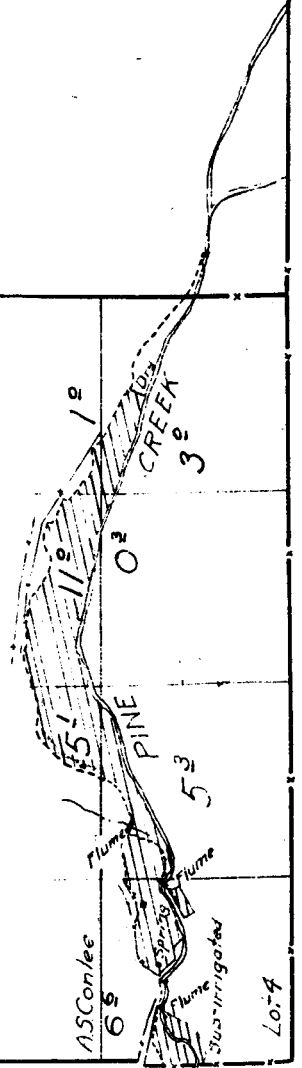

21

22

2²
FWBall

*Note: Location according
to Mr. Ball.*

■ School

28

27

33

34

