



25945
33179

T.36S.R.24E.W.M.

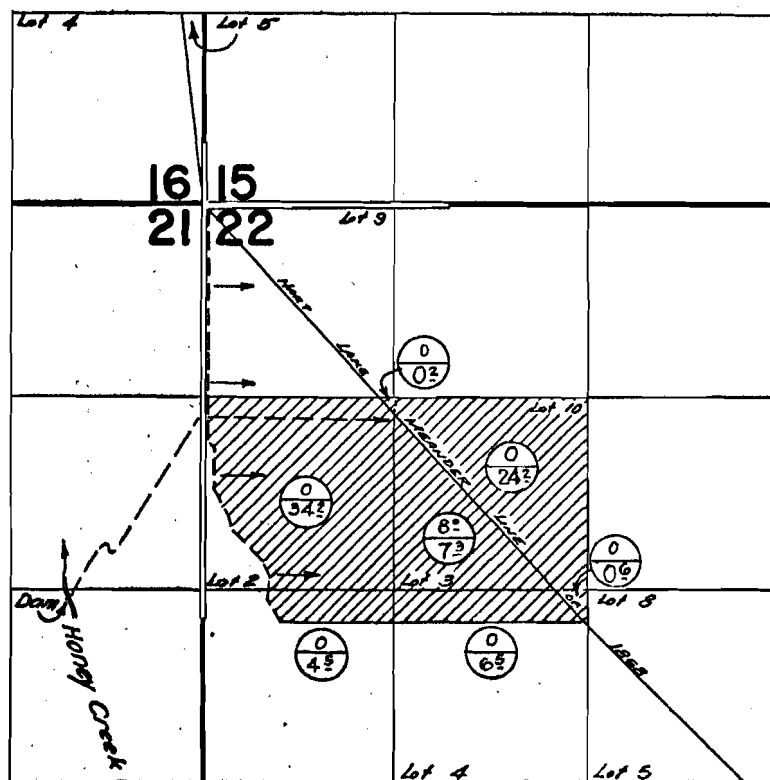

○ Previous rights from Honey Cr.
Acreage, this filing

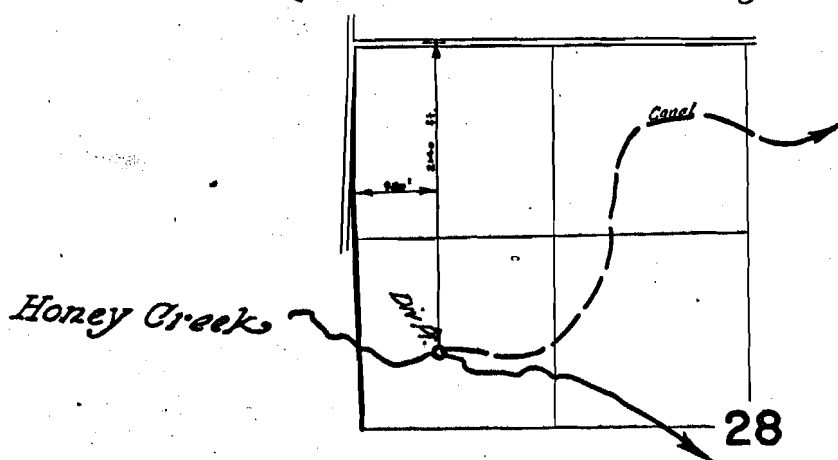

FINAL PROOF SURVEY UNDER

Application No. 32842... Permit No. 25945...
IN NAME OF

Donald J. & Cornelius Fitzgerald Jr.

Surveyed Sept. 14 1962, by *Alphonse*

36-24 ✓