


T. 17 S.R. 12 E.W.M.

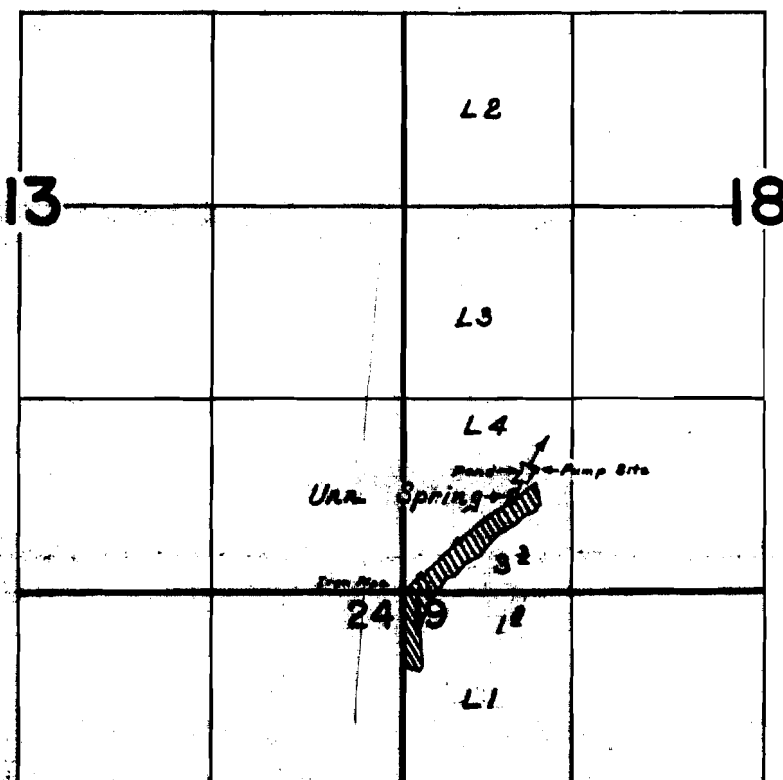

FINAL PROOF SURVEY UNDER

Application No. 32858 Permit No. 26956
IN NAME OF

ROBERT L. COATS

Surveyed Oct. 19 1962, by T.R. Lauer

25956
1962-0