


OWNSHIP 1 N., RANGE 19 E.

4

3

9

10

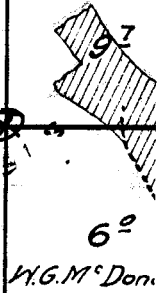

28

27

33

34

16

15

*Note:
Streams and roads, except in the
vicinity of irrigated land, are
sketched in approximate location*

21

22

TOWNSHIP

| | |
|---|---|
| 6 | 5 |
| 7 | 8 |

| |
|---|
| 4 |
|---|

| |
|---|
| 9 |
|---|

18

17

16

19

20

21

23

24

Surveyed May 19, 1925.

12

JOHN DAY RIVER

ditch partly filled with dirt

14

14

69

26

25

34

76

Pump Dam Mind Mill & Pump

35


36

Surveyed May 14, 1925.

JOHN DAY RIVER
Sage 18
Thos. Brady
BIRD ROCK
Flume
116
115
NGE 19 E.

3-2-1

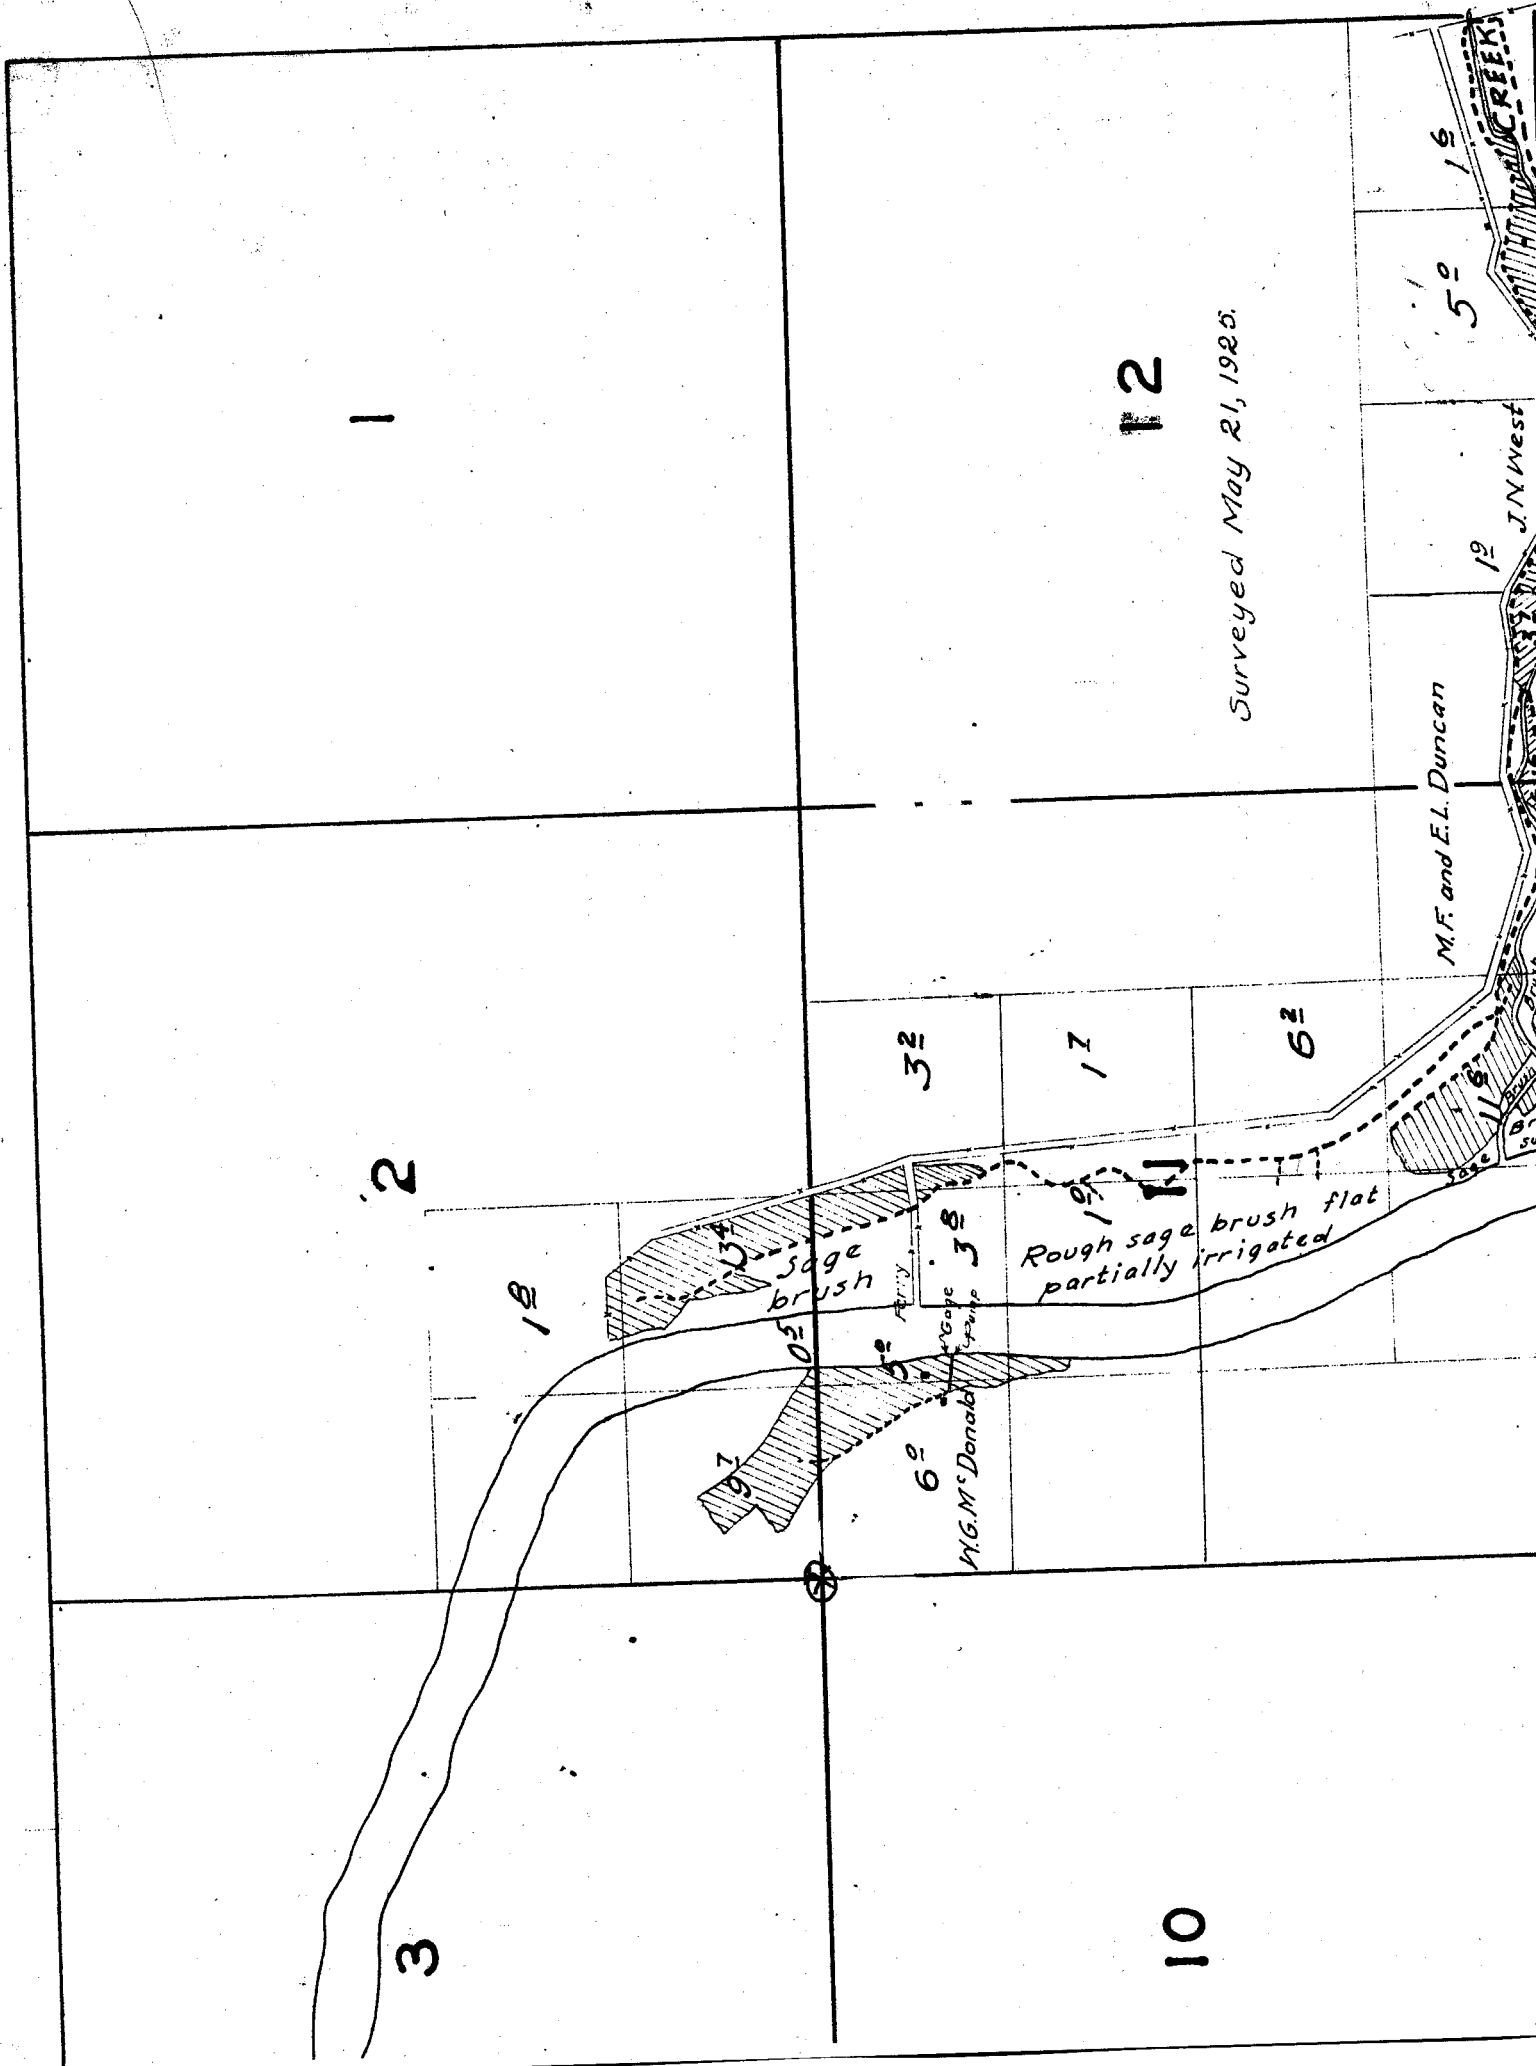

1

2

3

19

7

sage brush

6

3


3

Rough sage brush flat partially irrigated

7

12

10

6

Surveyed May 21, 1925.


M.F. and E.L. Duncan

J.N. West

19

5

CREEK

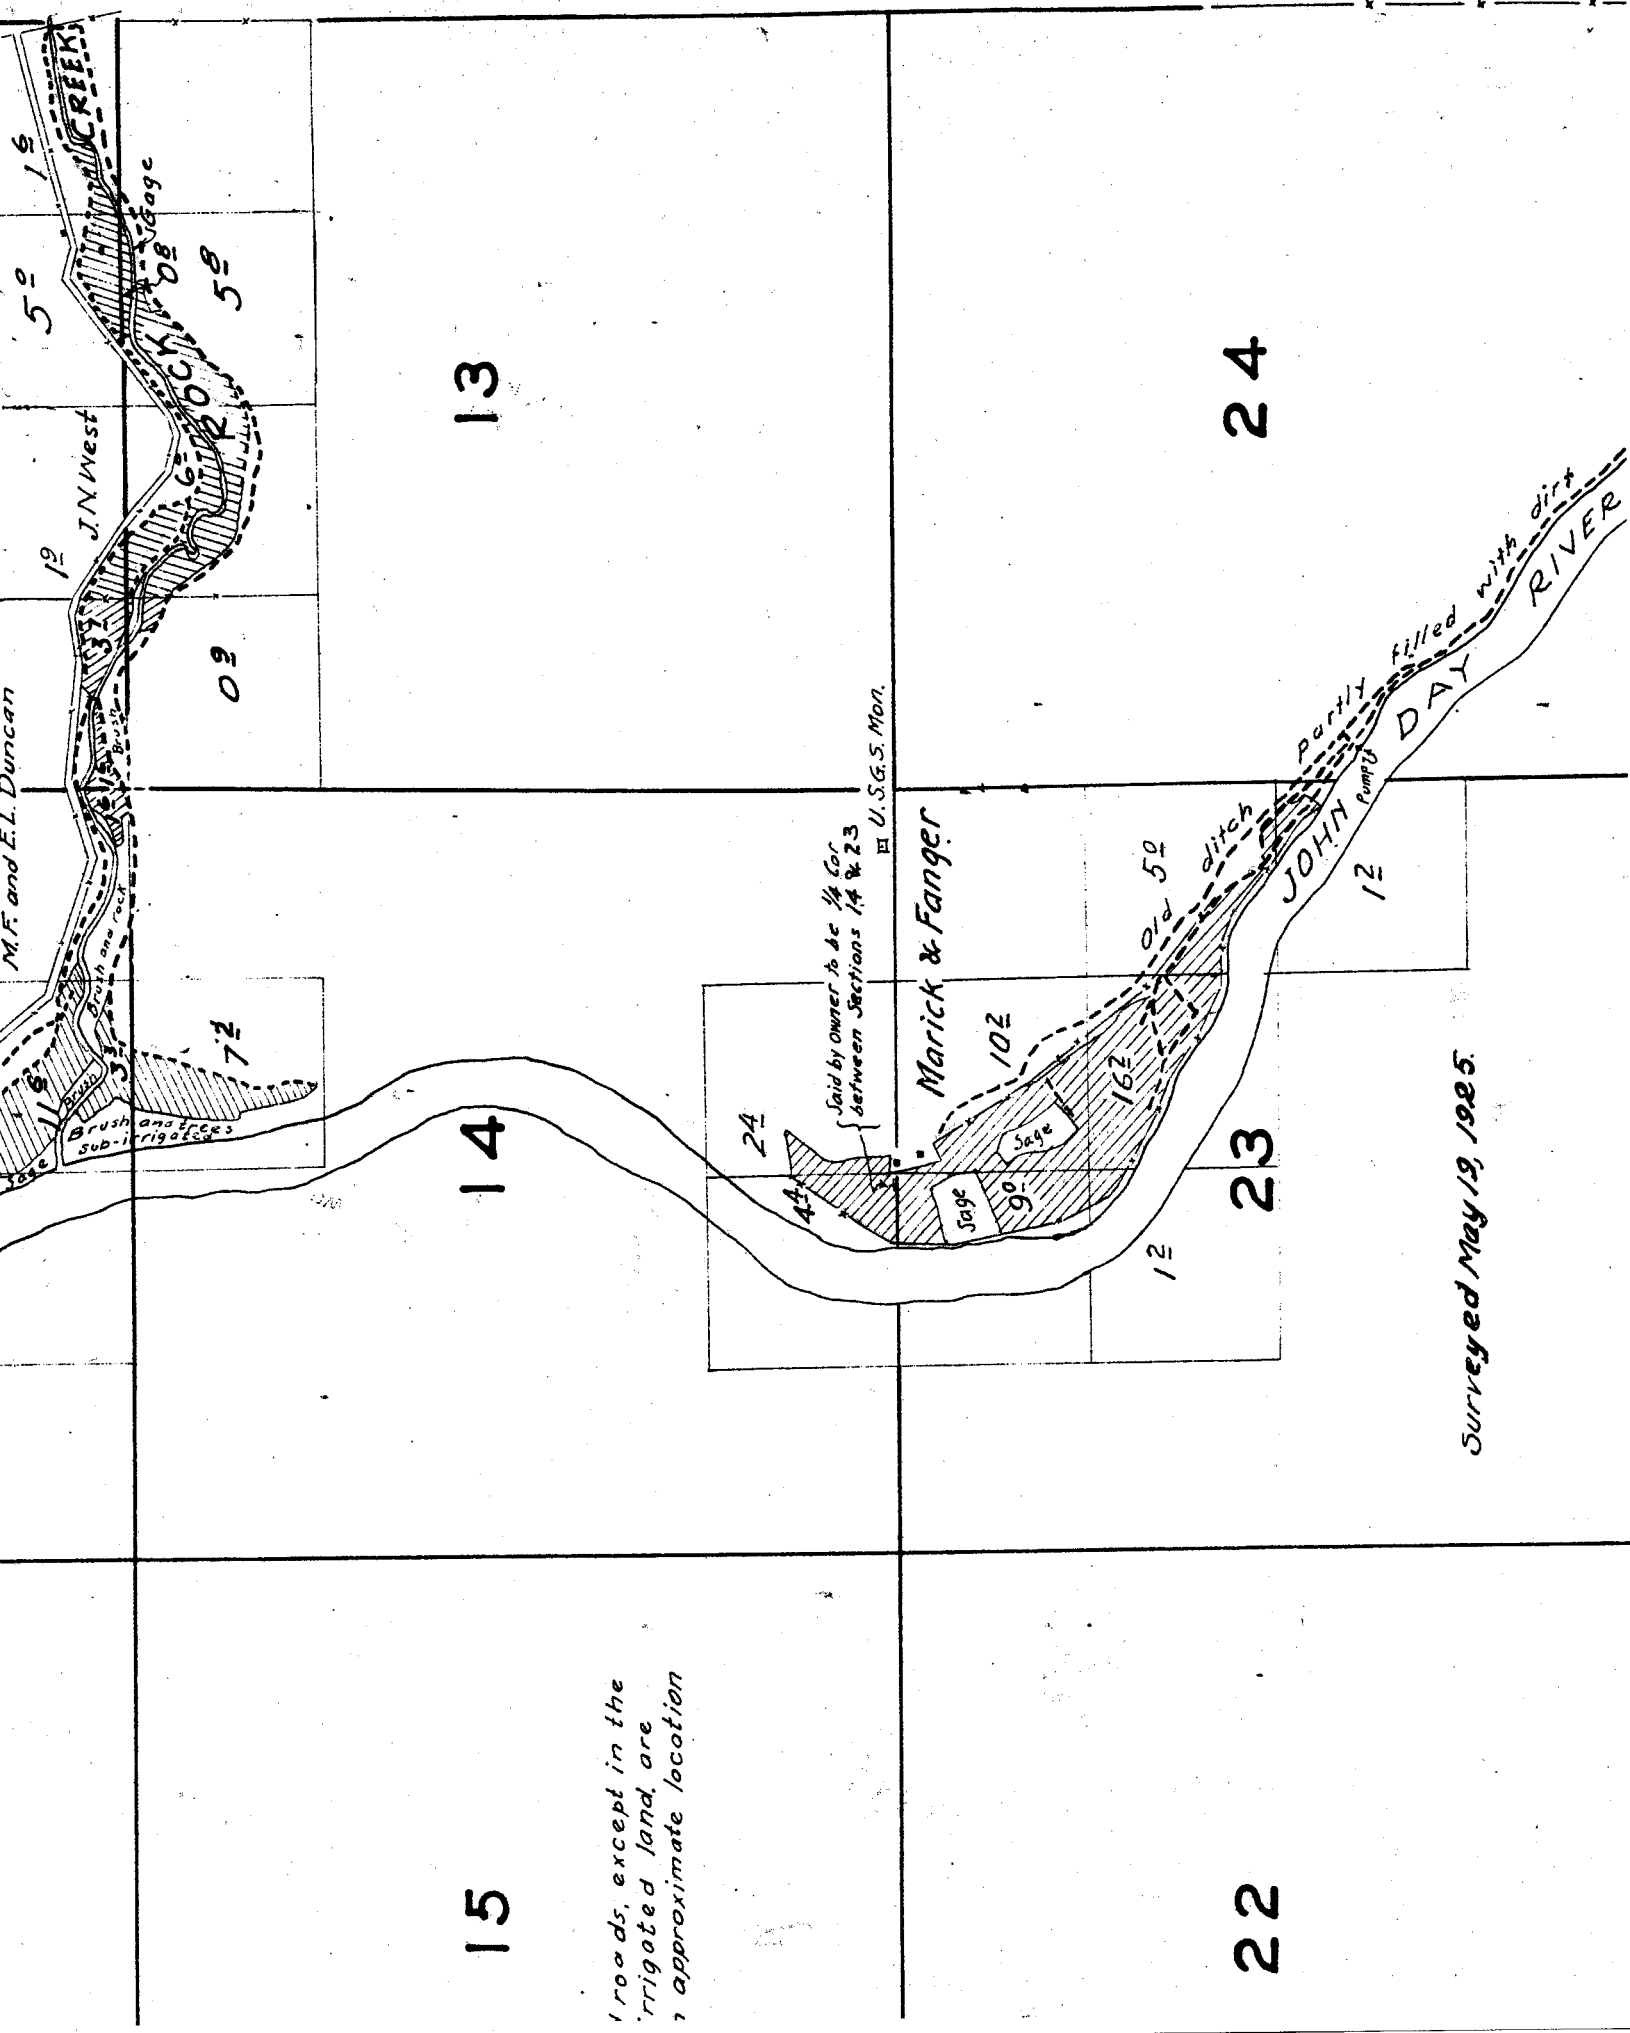

Roads, except in the irrigated land, are approximate location

Surveyed May 19, 1925.

19

20

30

29

31

32