



TOWNSHIP 7 S., RANGE 21 E.

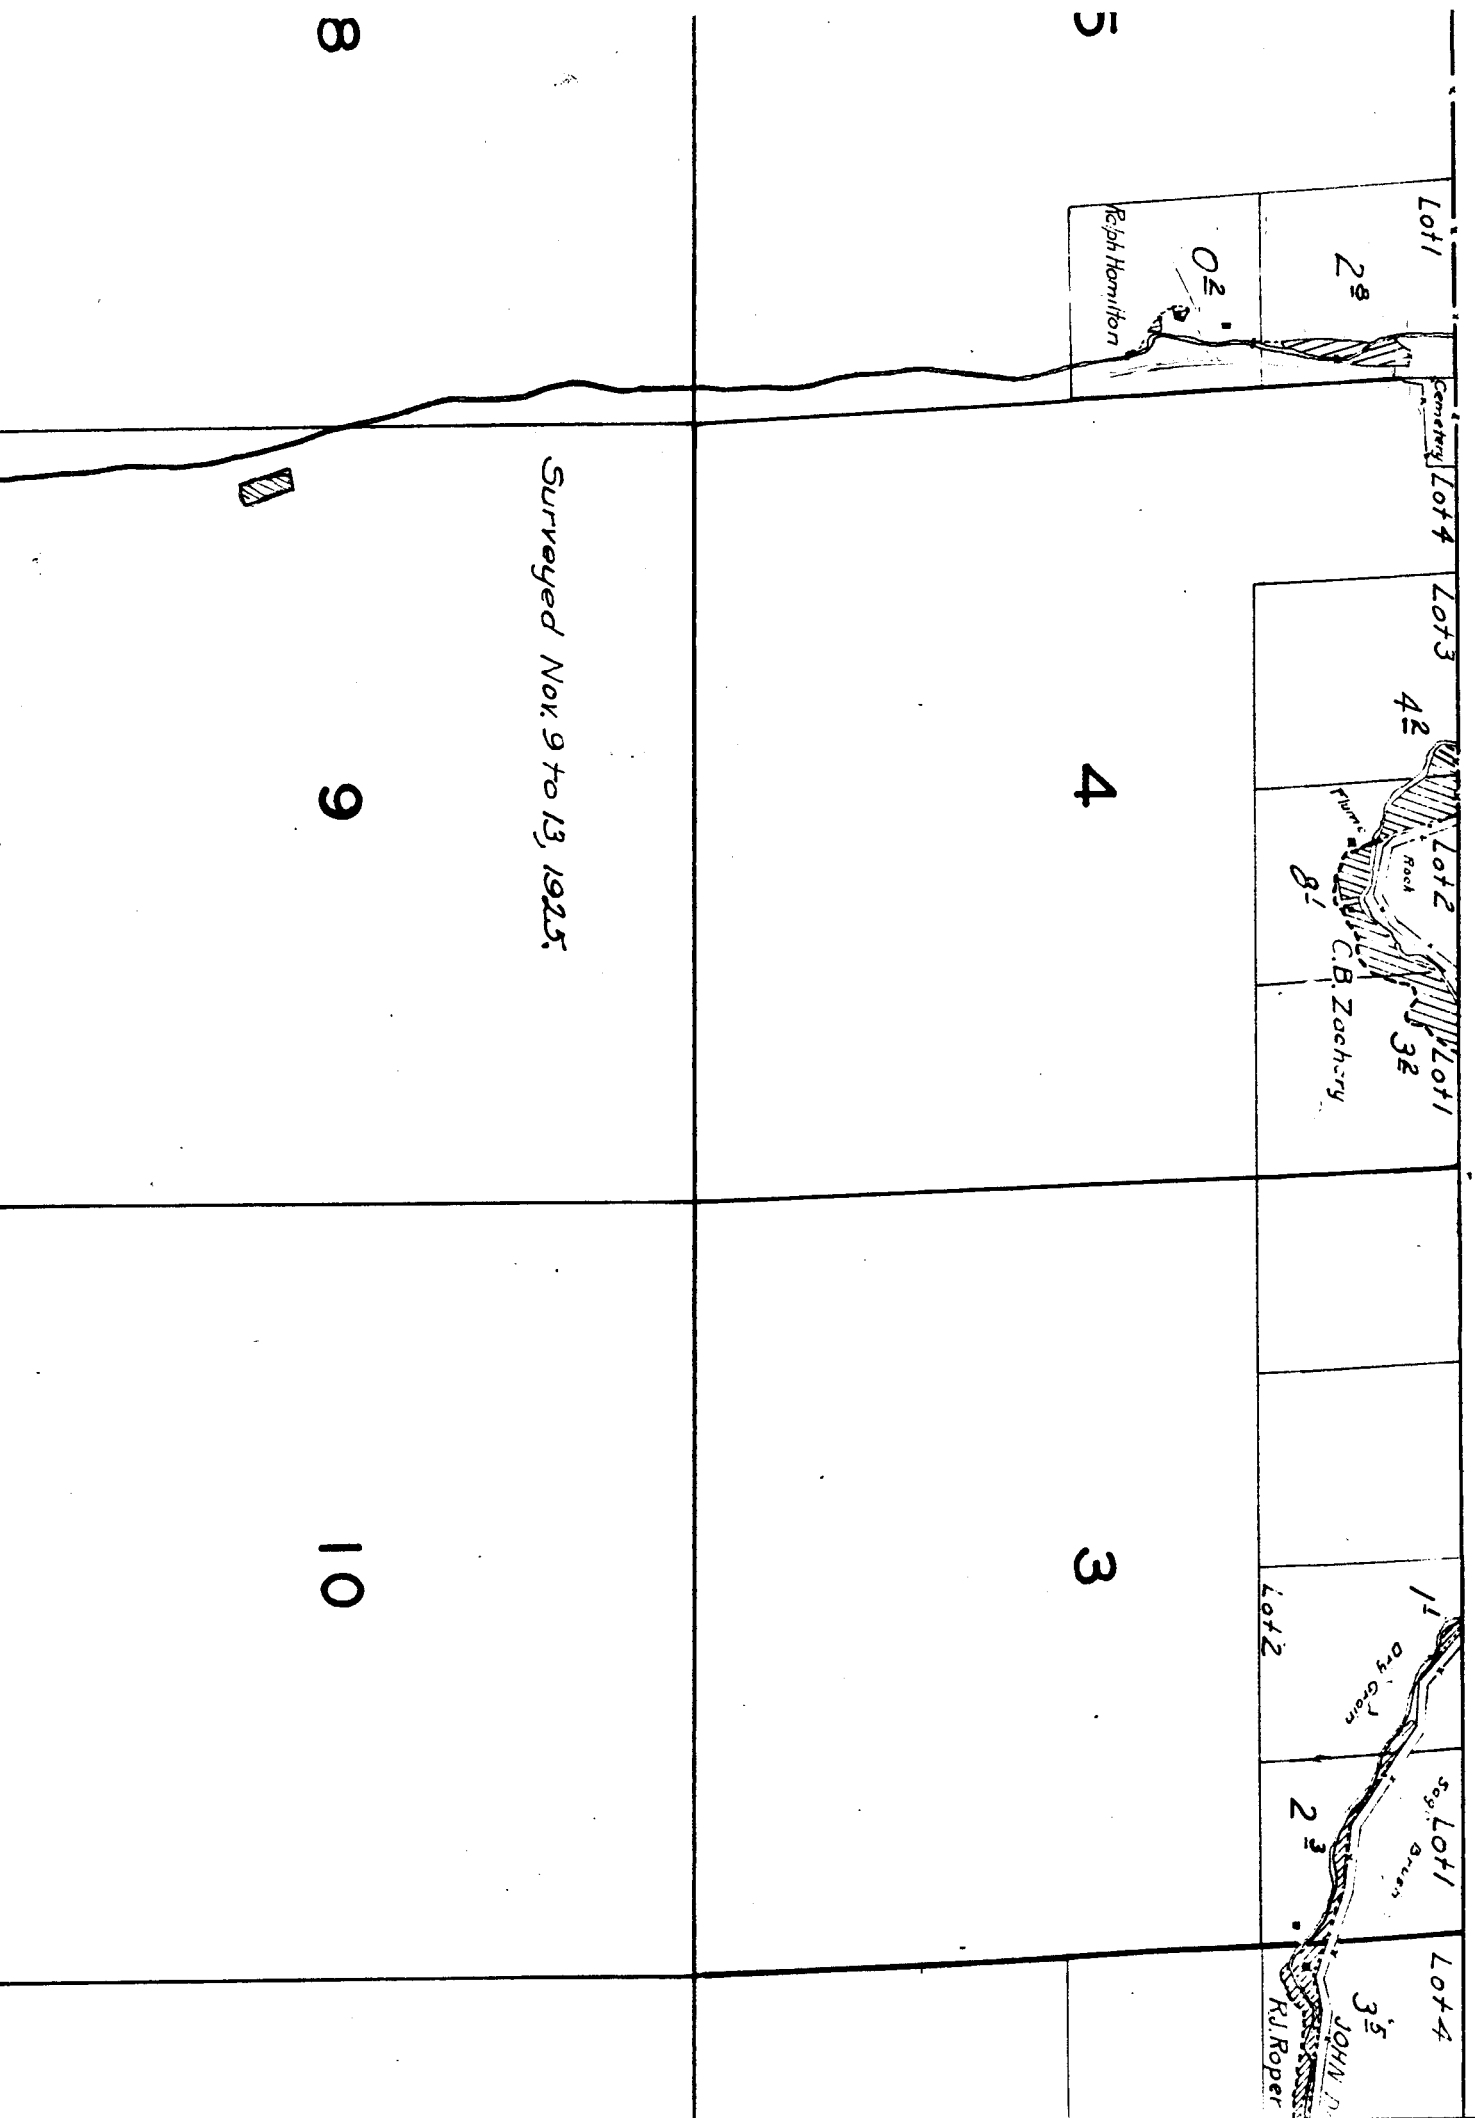

Note: Streams not in the vicinity of irrigated lands sketched in approximate location.

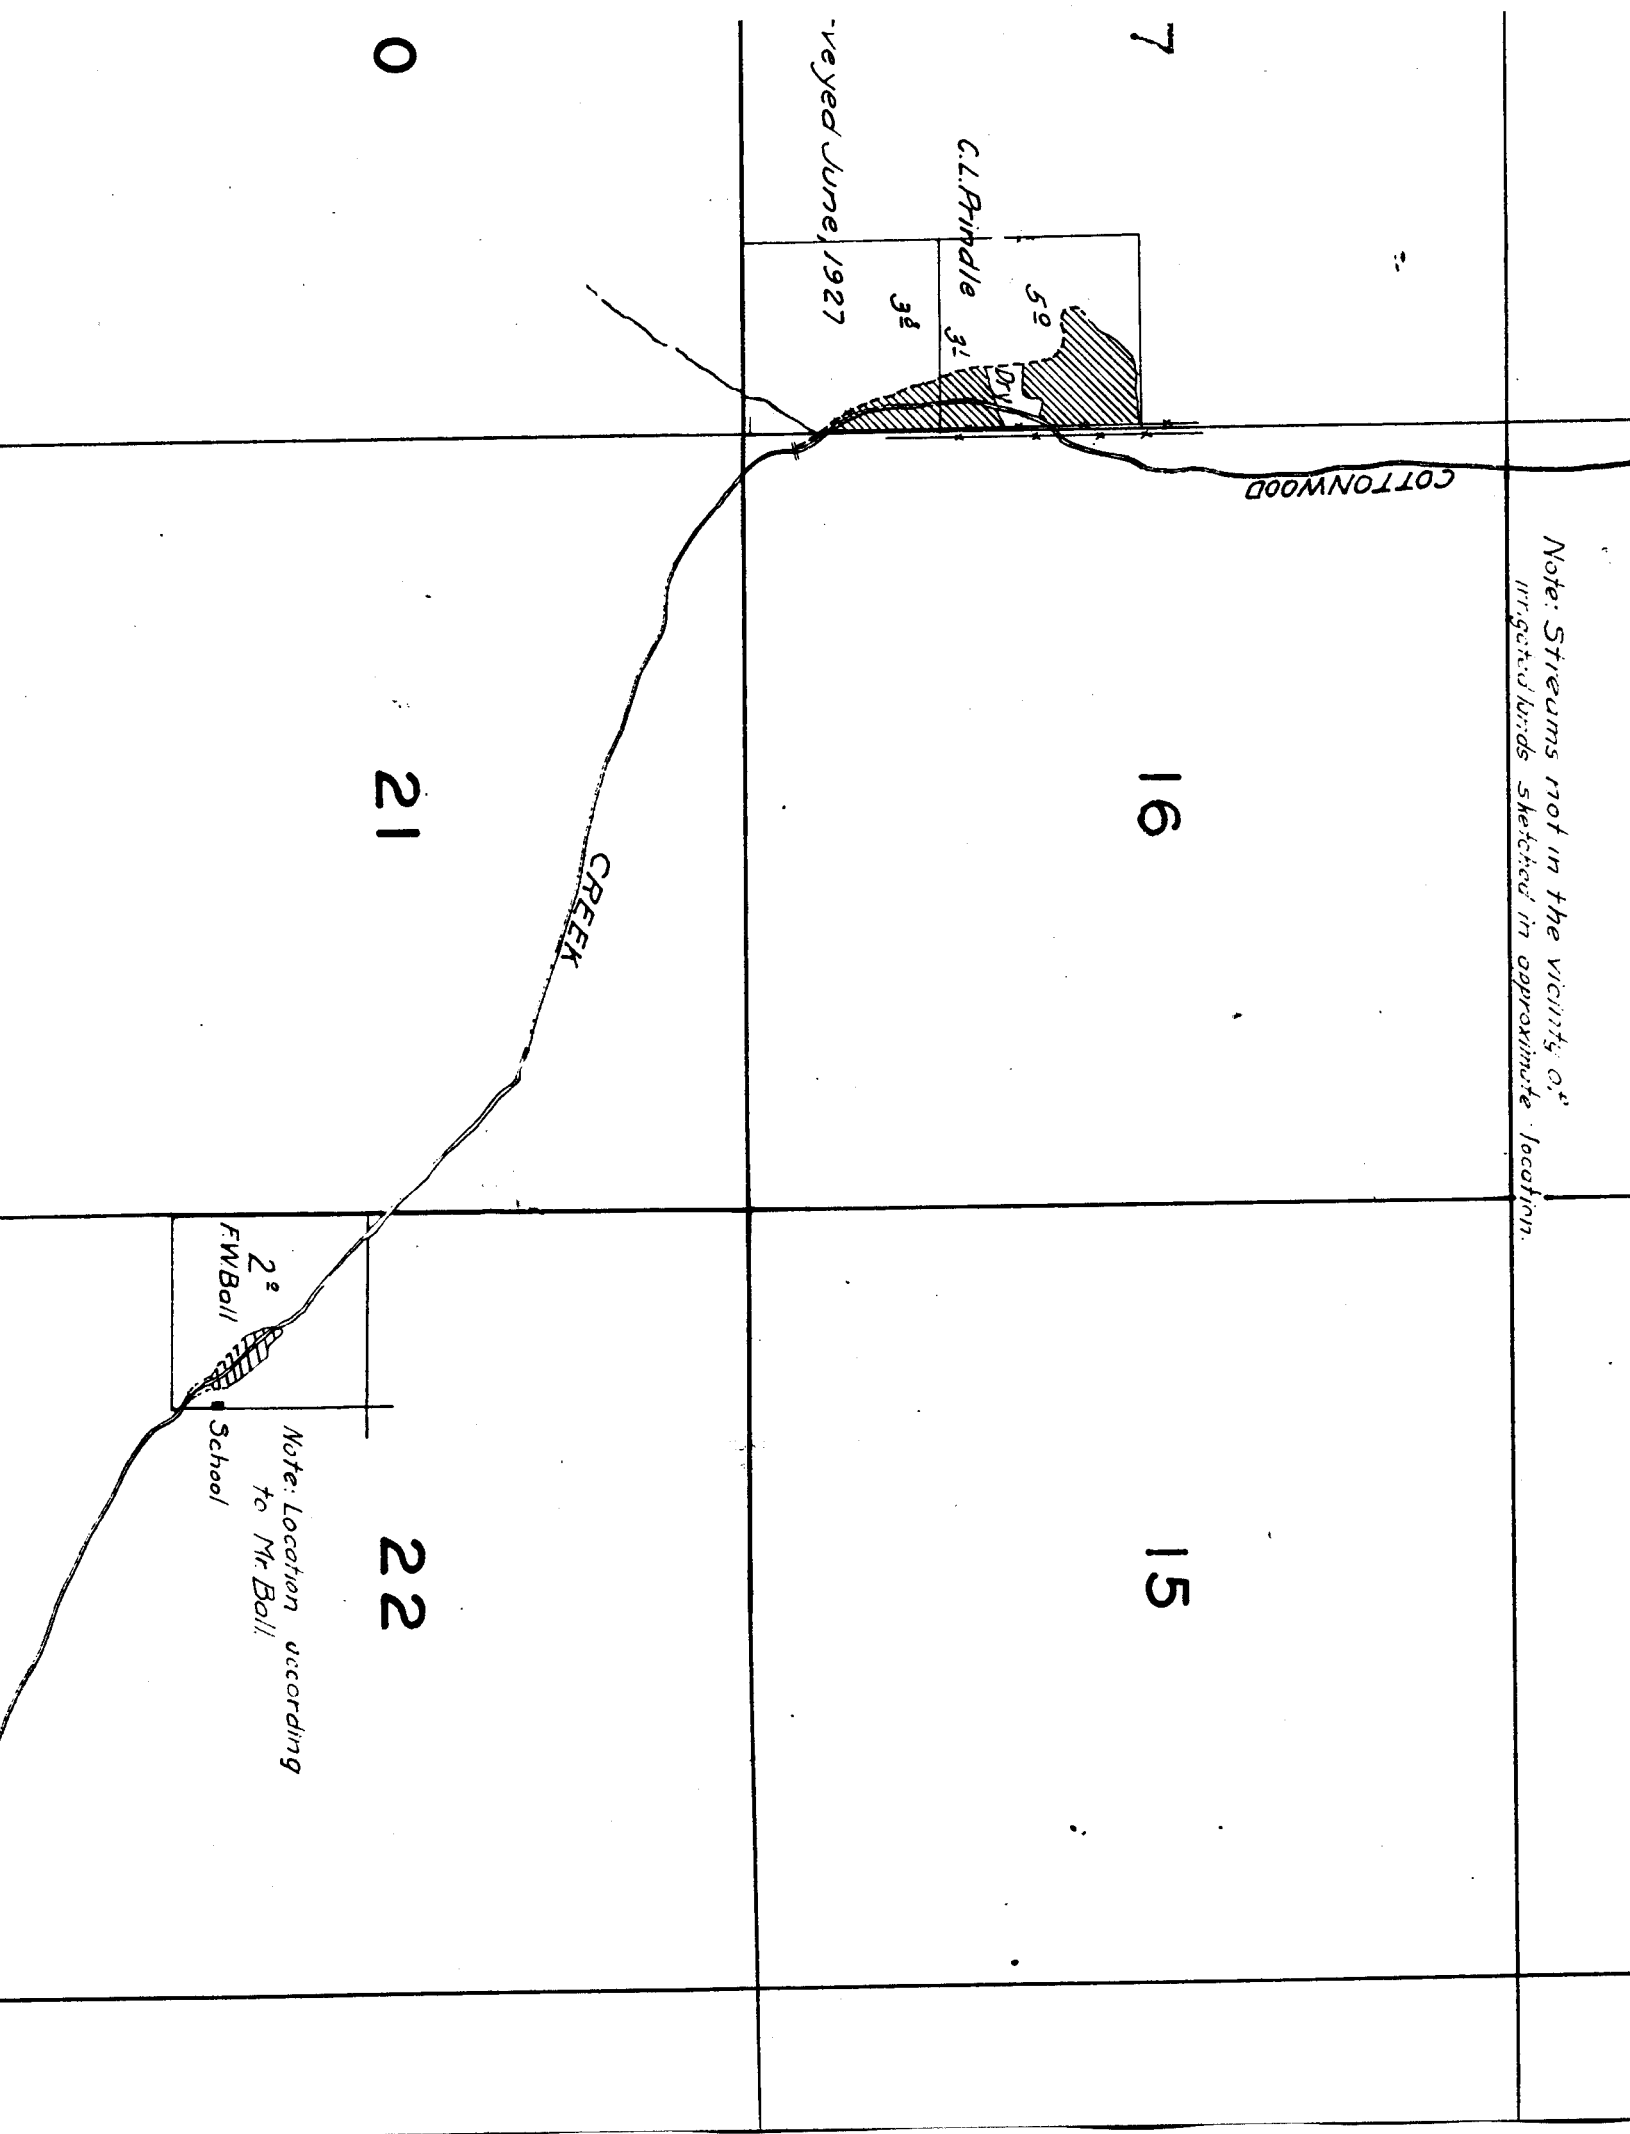

21

22

2^d
FWBall

*Note: Location according
to Mr. Ball.*


School


28

27


33

34

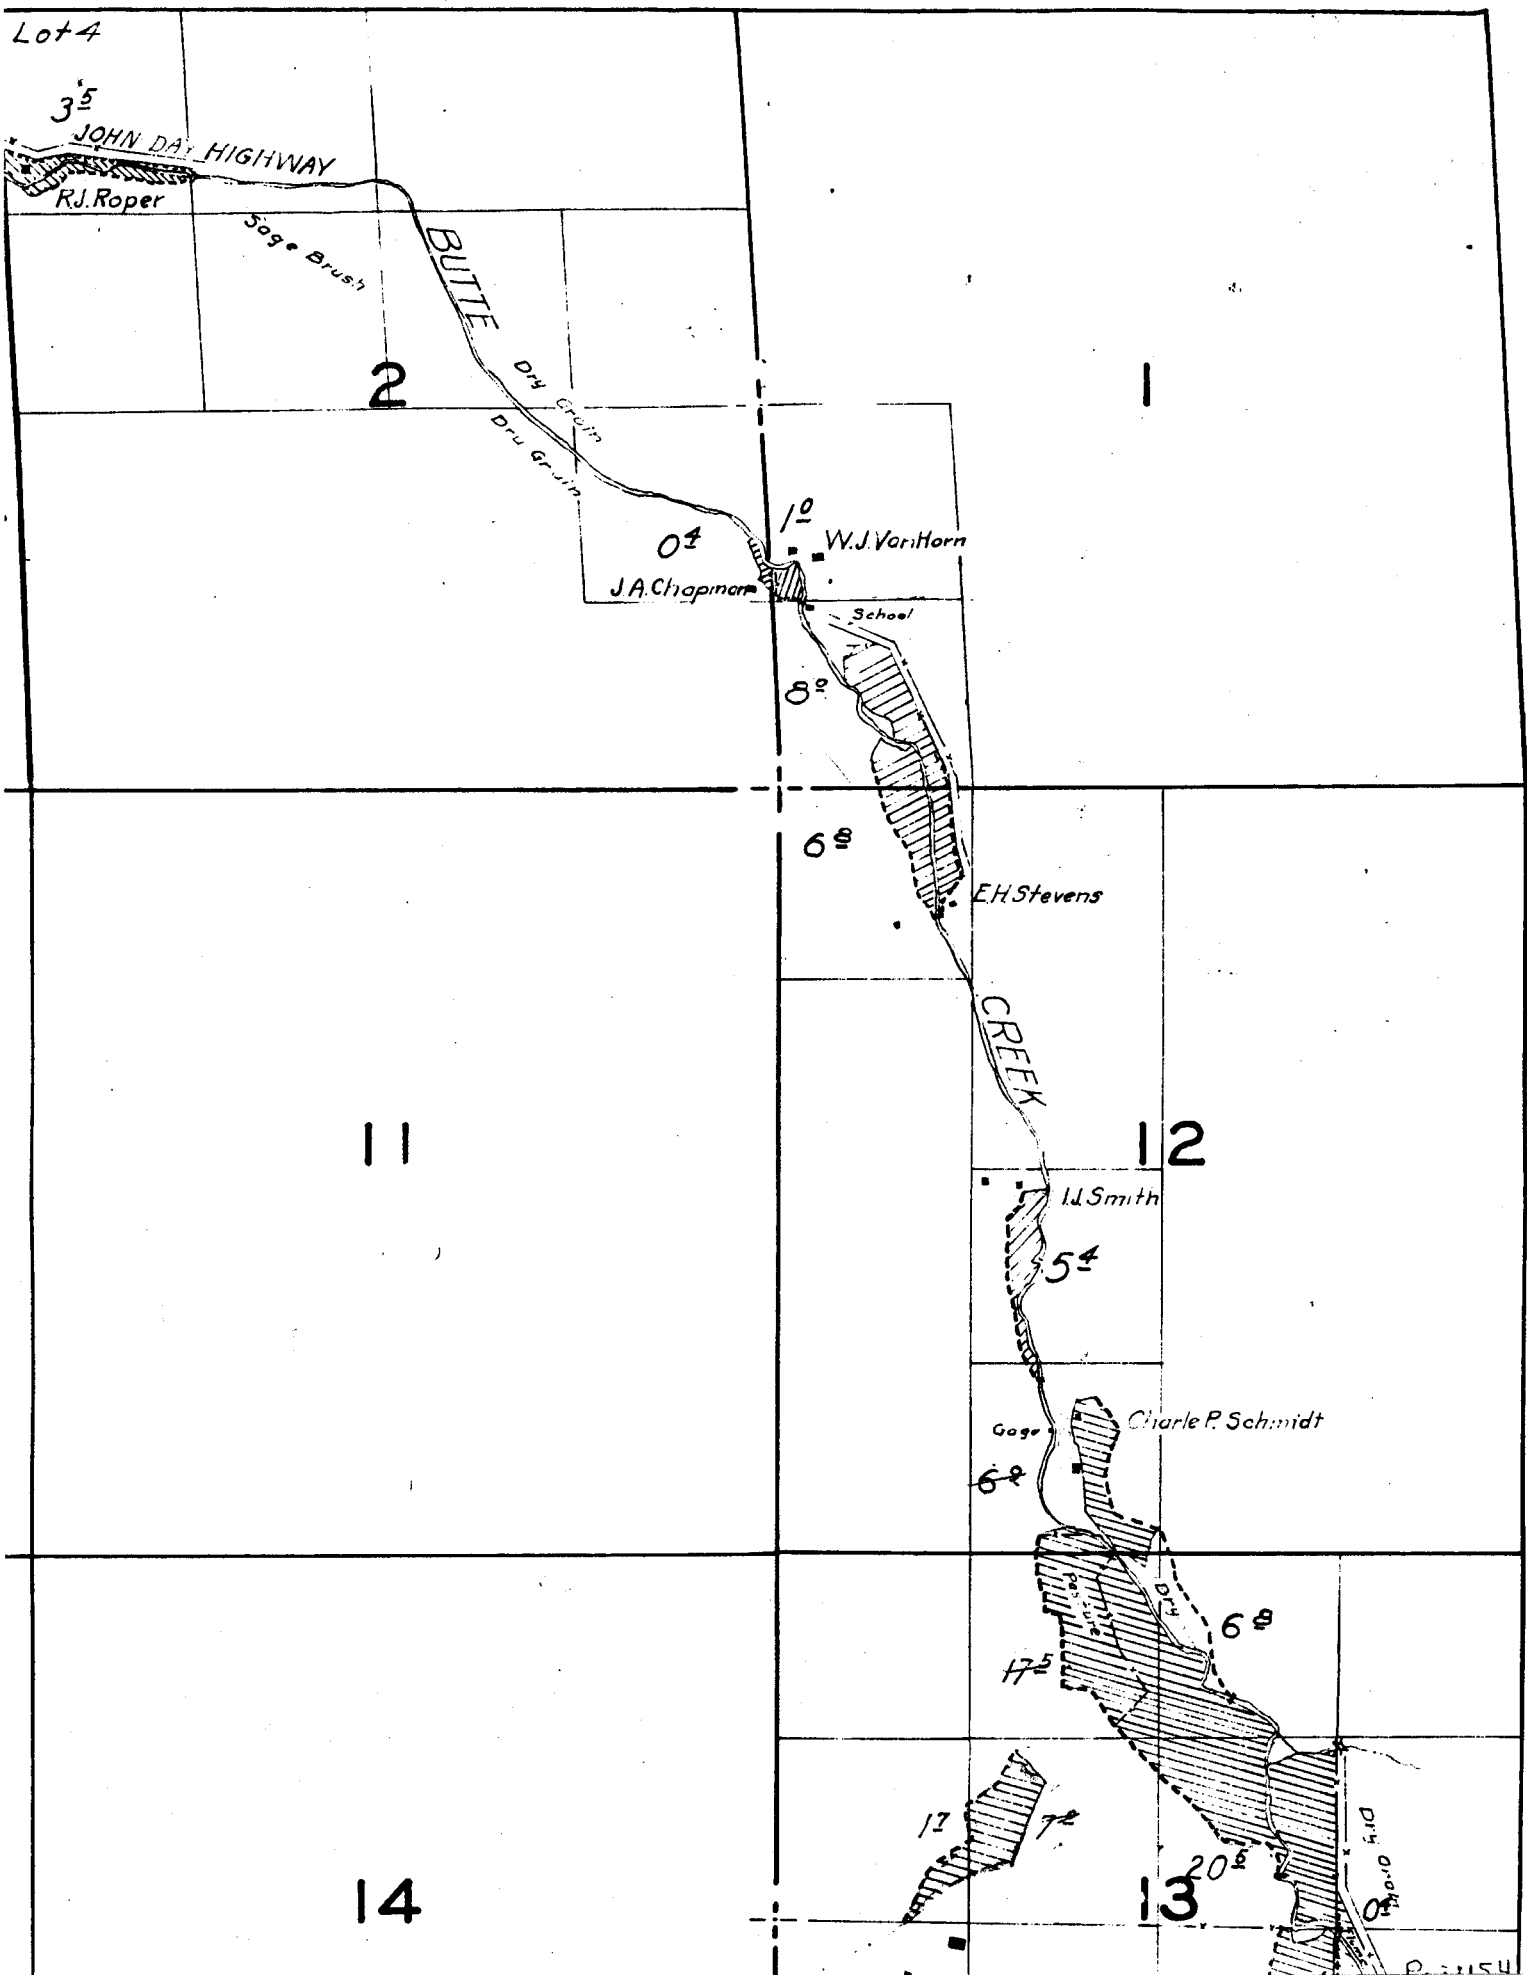

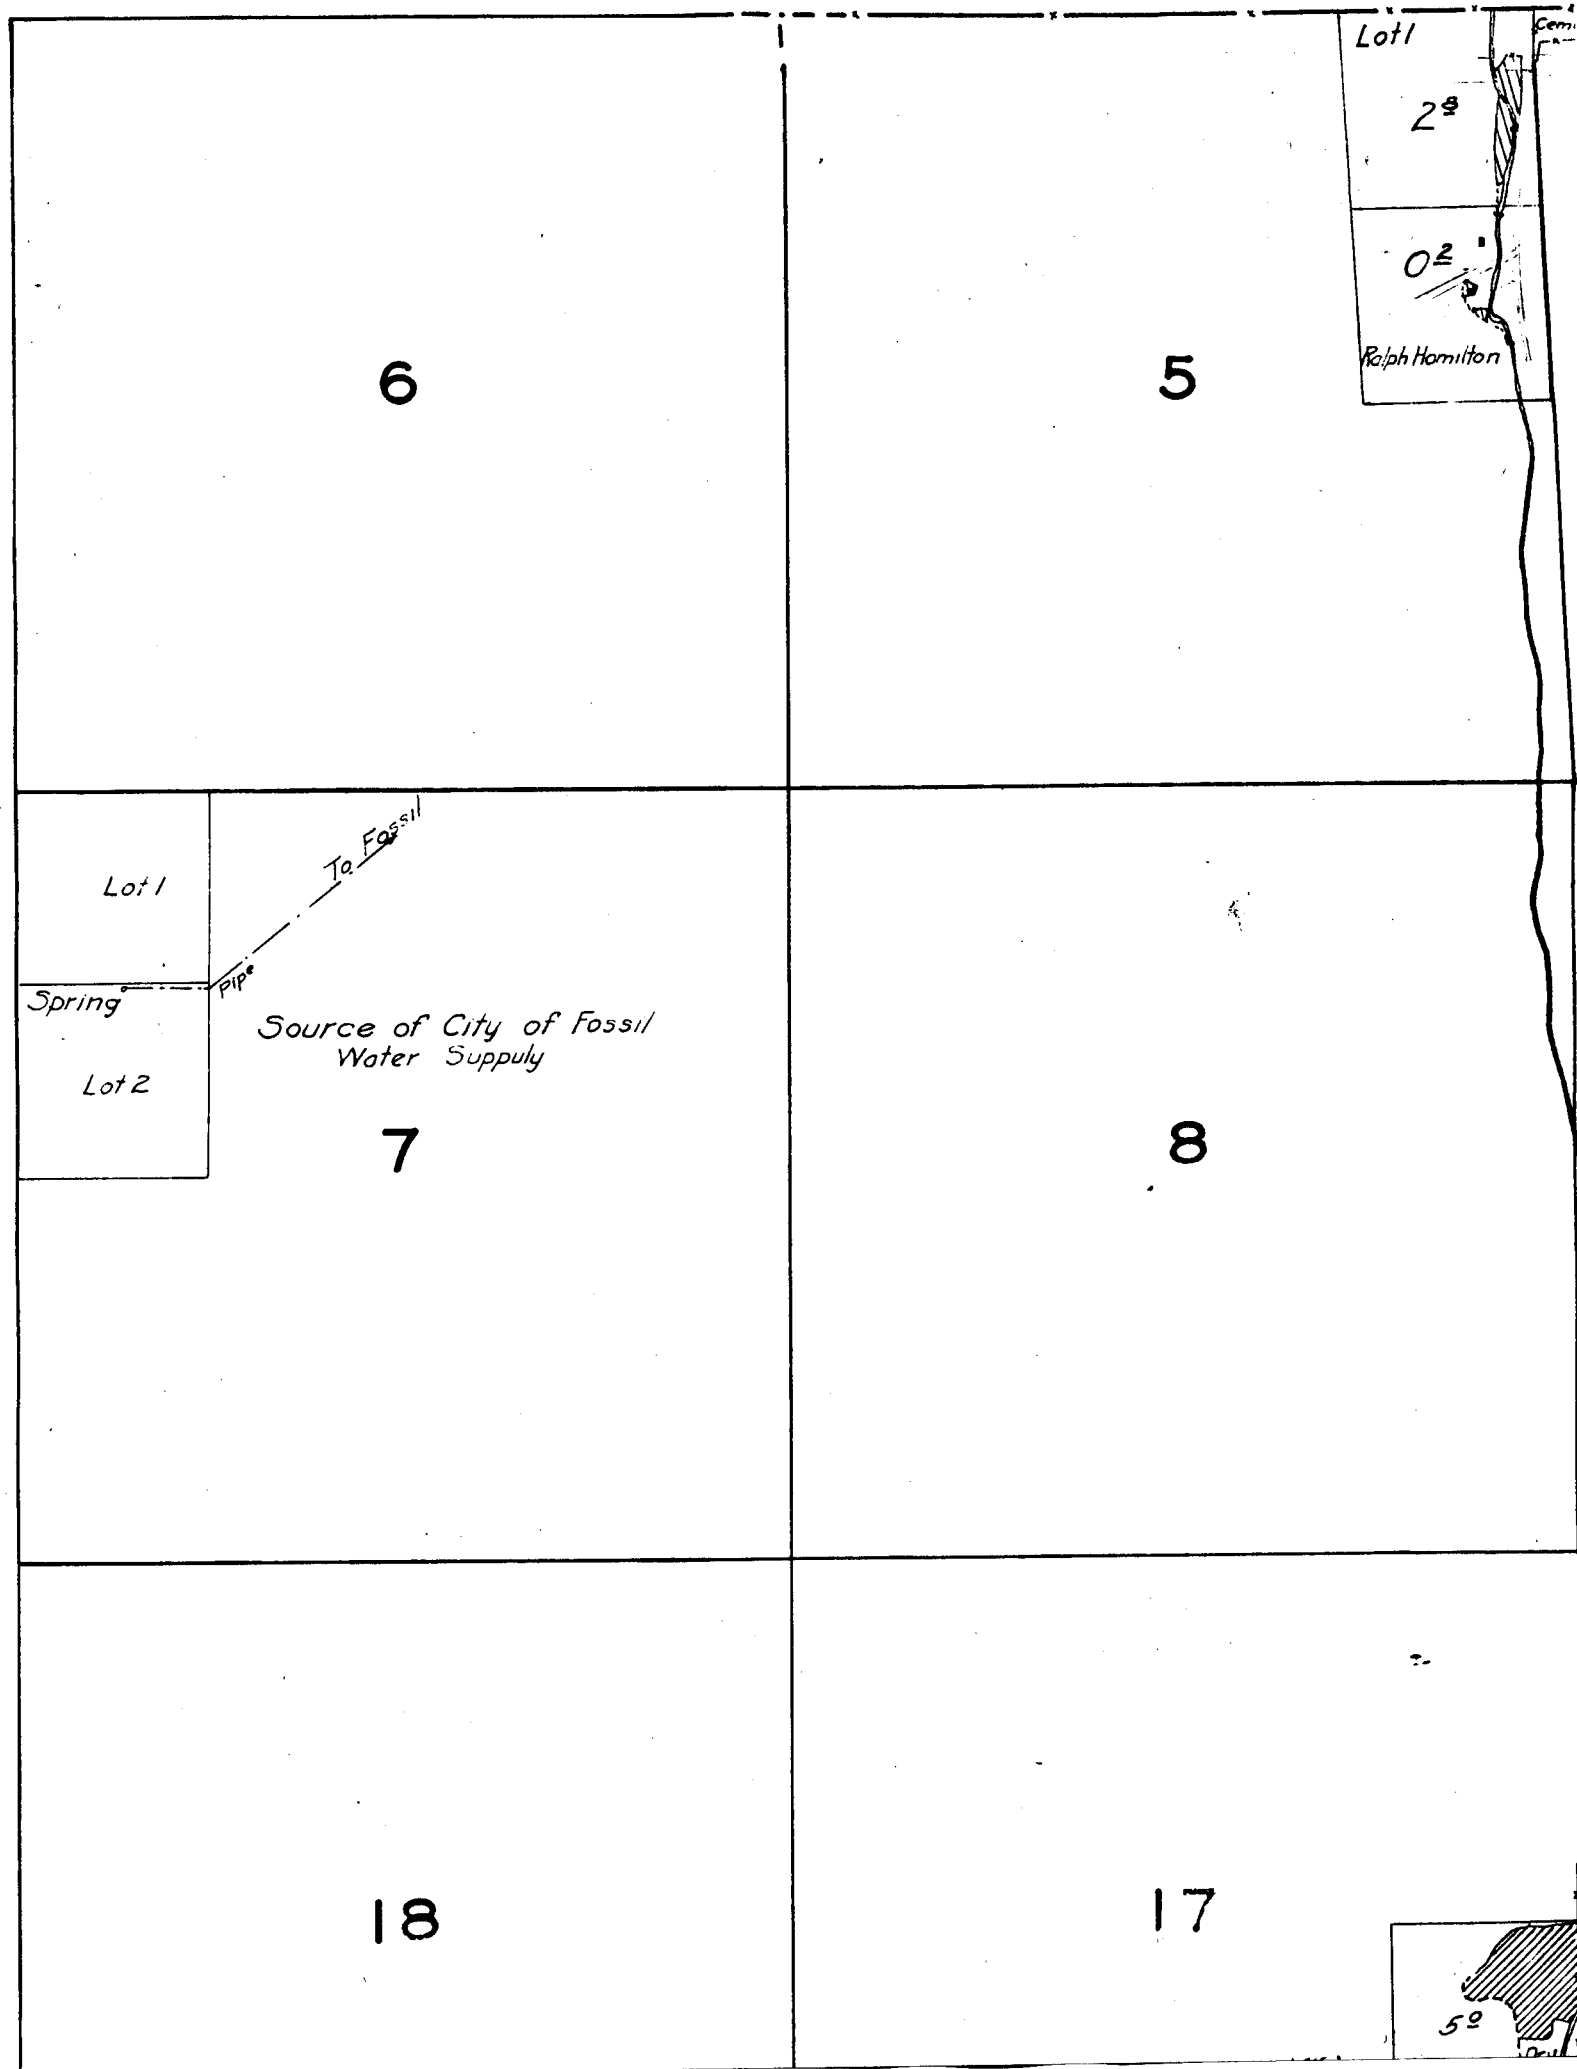

Note: Streams not in th.
irrigated lands sketched.

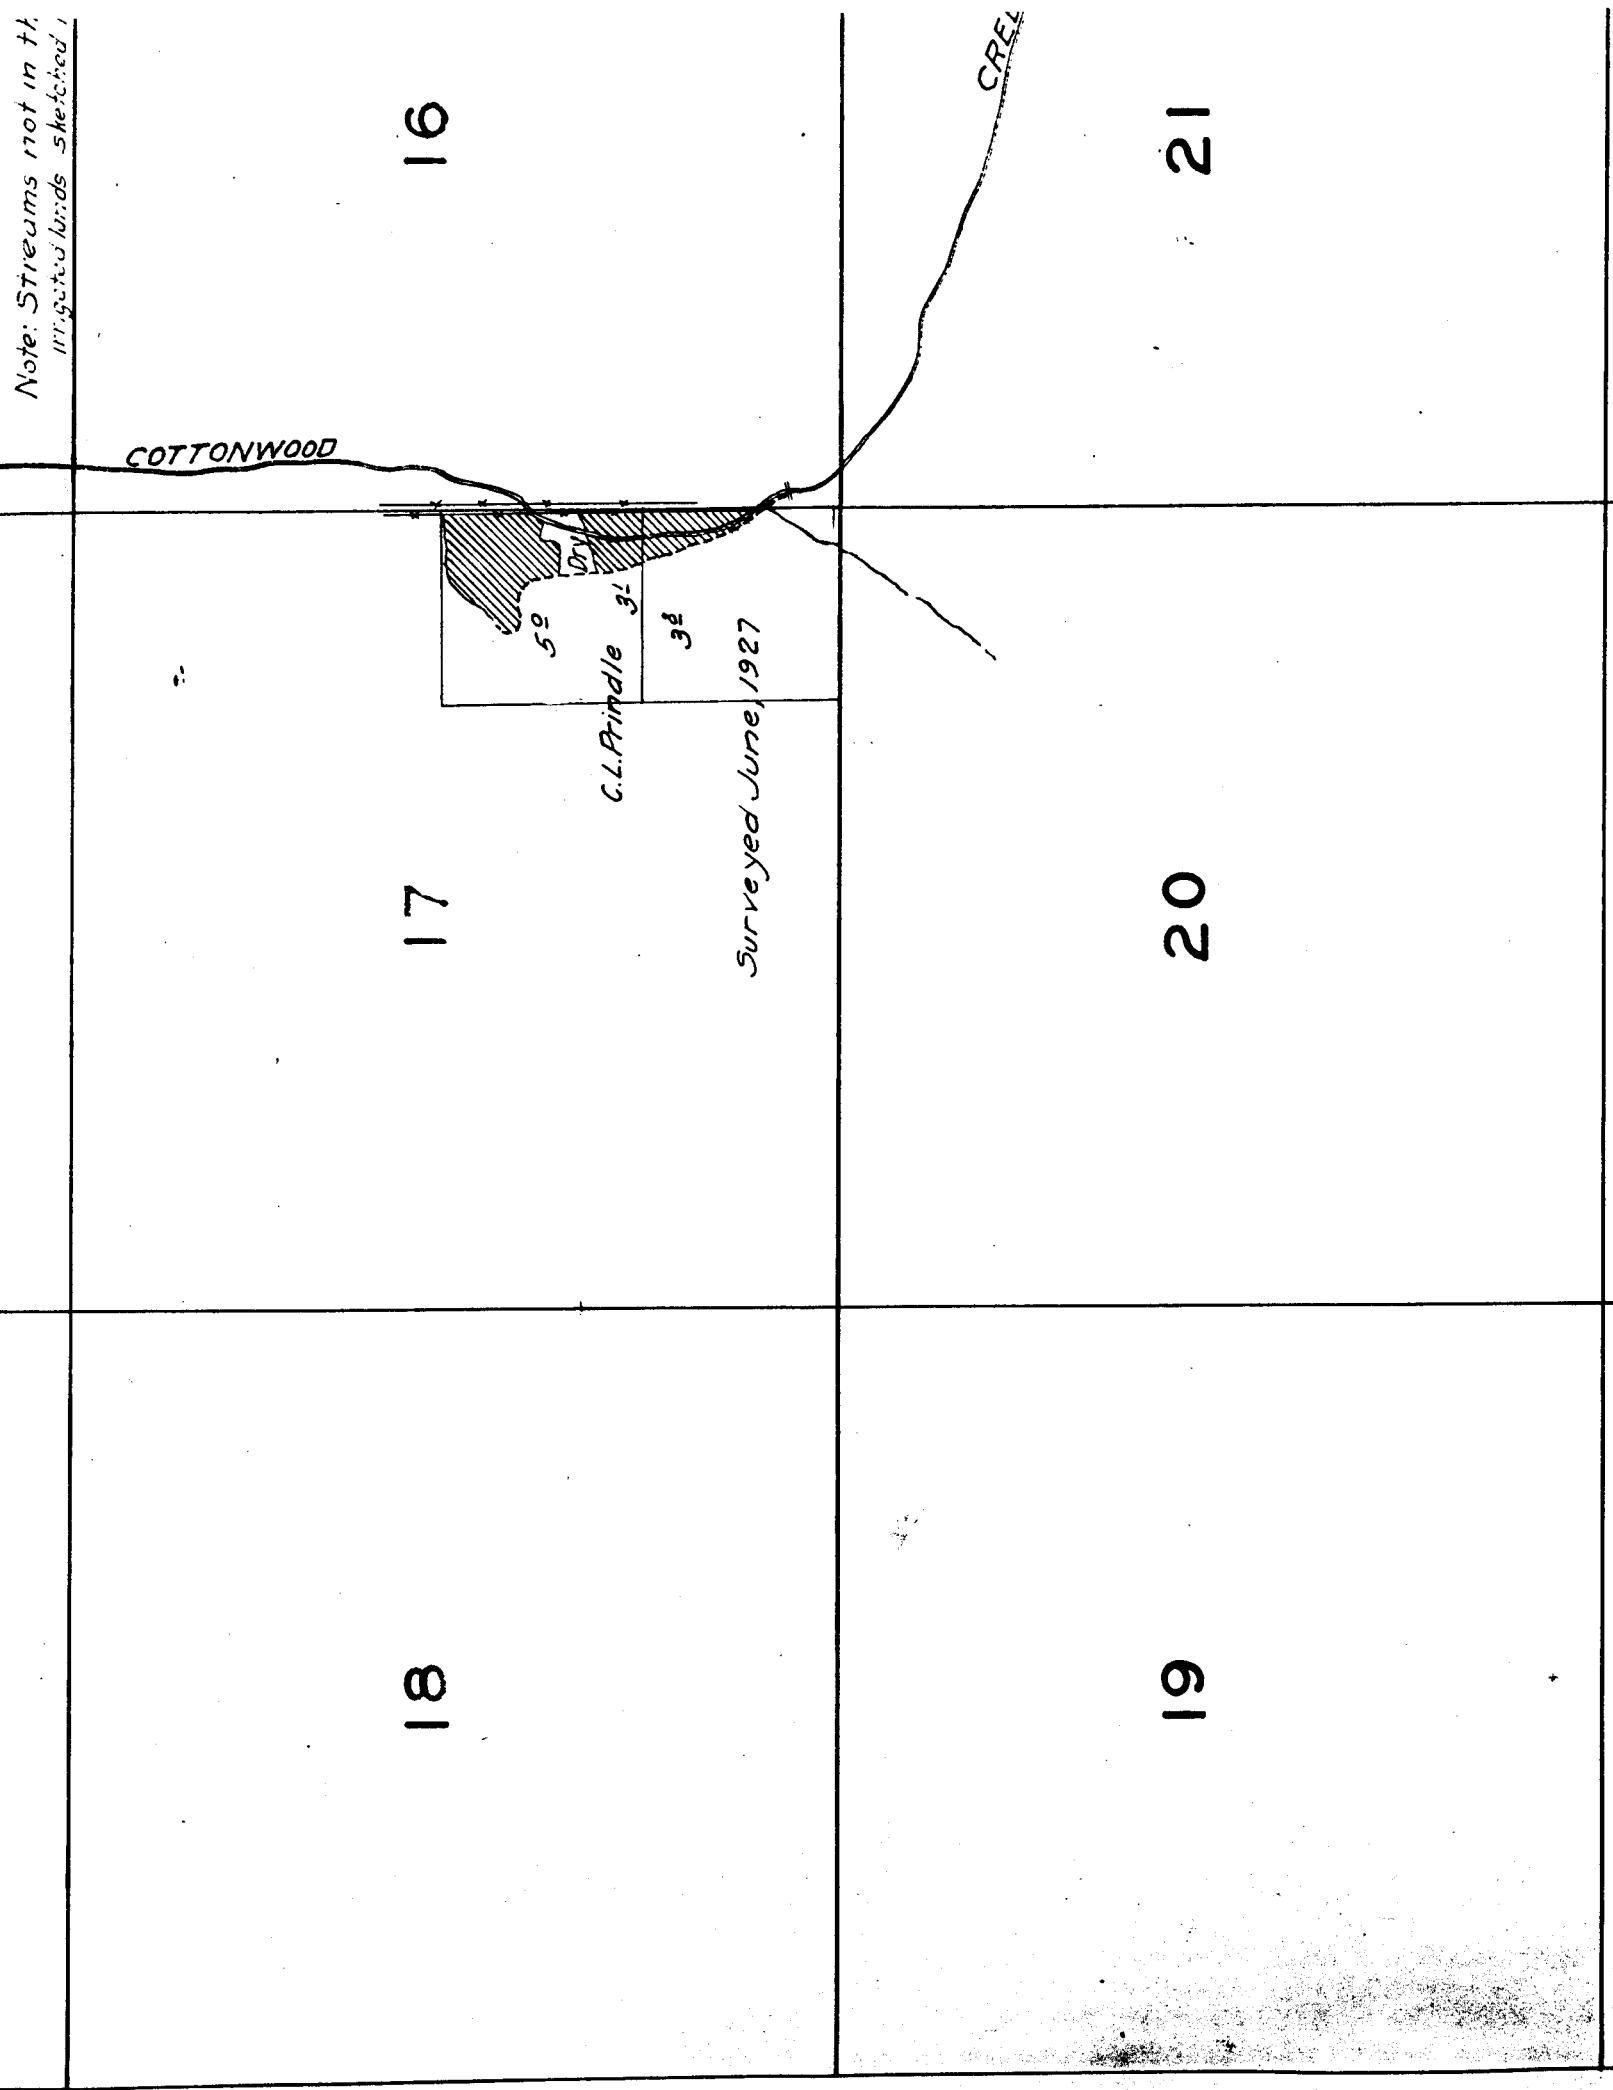

28


29

30

33

32

31

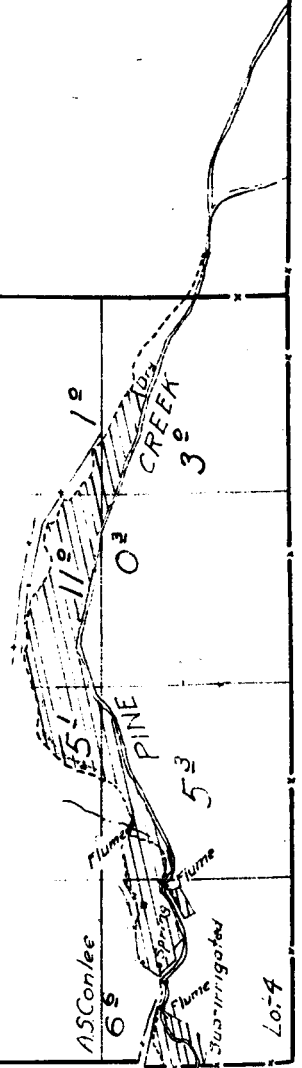

27


26

25

34

35

36

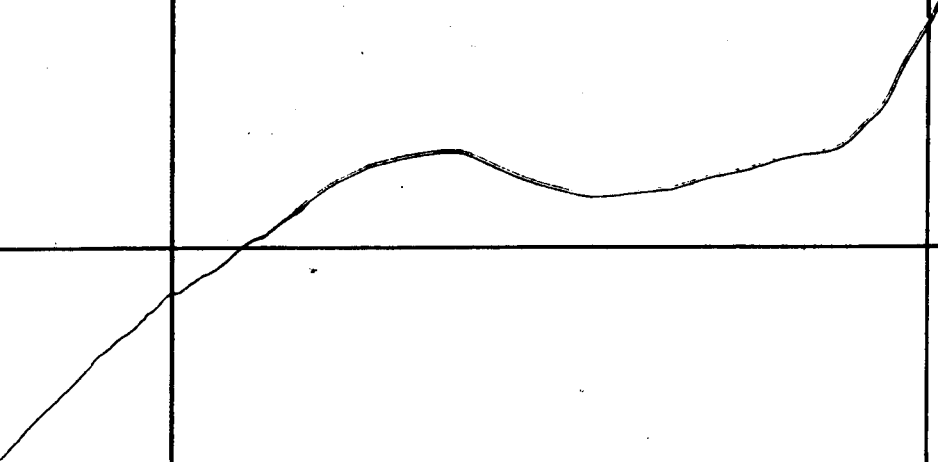

[illegible]

15	
14	

22

Location according
to Mr. Ball.

23

24

