

30

Note: Streams and Rivers except in the vicinity of irrigated land, sketched in approximate location.

29


28

MATHIS
31

Surveyed Oct 29, 1925

Mrs Mary Adams
10

0-

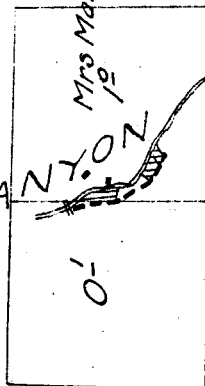

32

33

Spring

Baugh.

16

21

17

20

18

19

21

22

28

27

Surveyed Sept. 24 and 30, 1925.

33

34

Baughn

0³

6²

pump

Snable

JOHN DAY RIVER

TOWNSHIP 8 S., RANGE 24 E.

	4	3	Surveyed.
1925.	9	10	

50

15

22

16

21

27

26

25

Sept. 24 and 30, 1925

34

35

36

JOHN DAY RIVER

Frank Wright

HAHLER CREEK

Avary Shown

CREEK

F.R. Davenport

Avary Shown

Warren Davenport

SPRAY

W. Fisher

Sam. Winslow

CC + LOU MORRIS

City Hall

5/c


Surveyed October 15 and 16, 1928


15

14

22

23

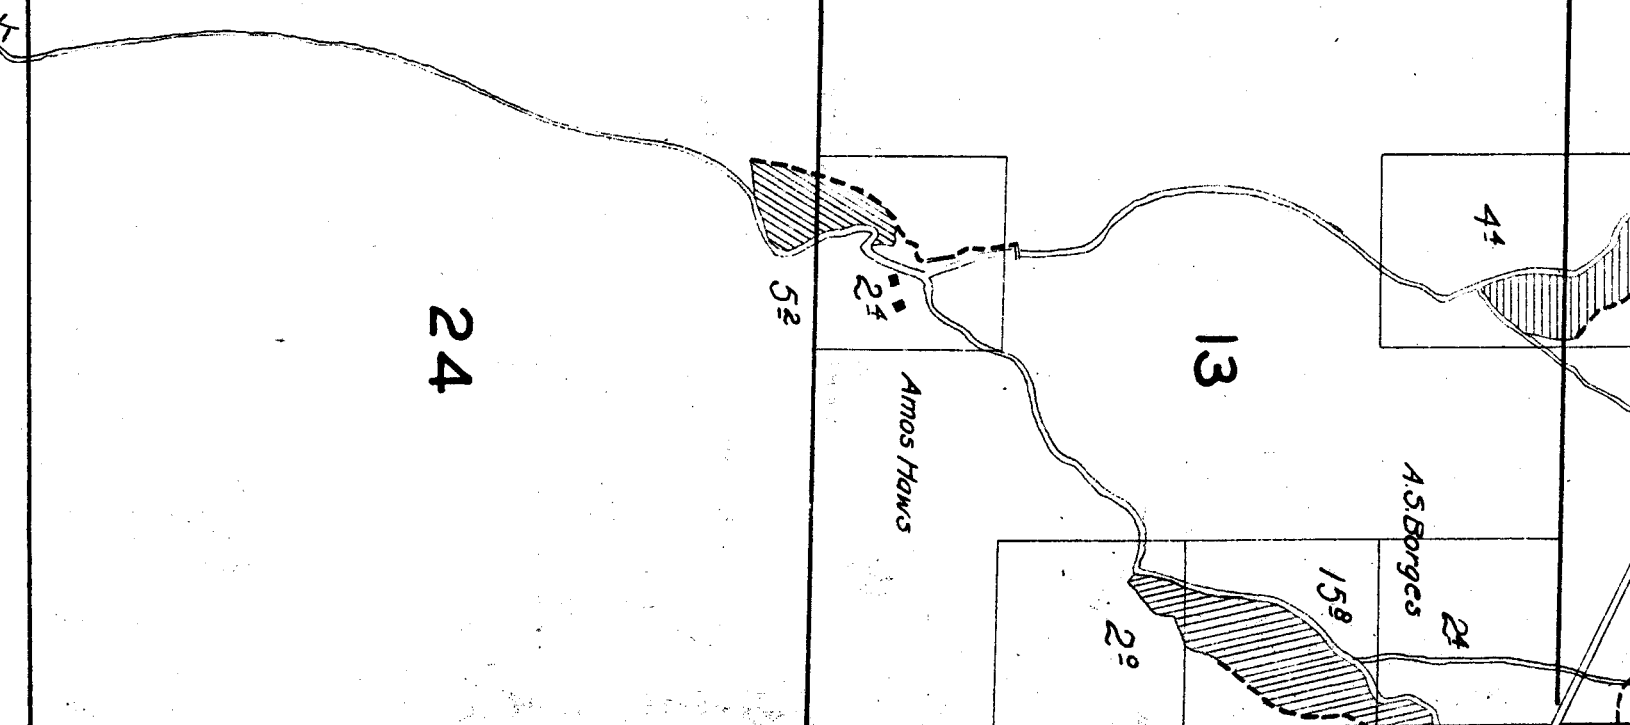

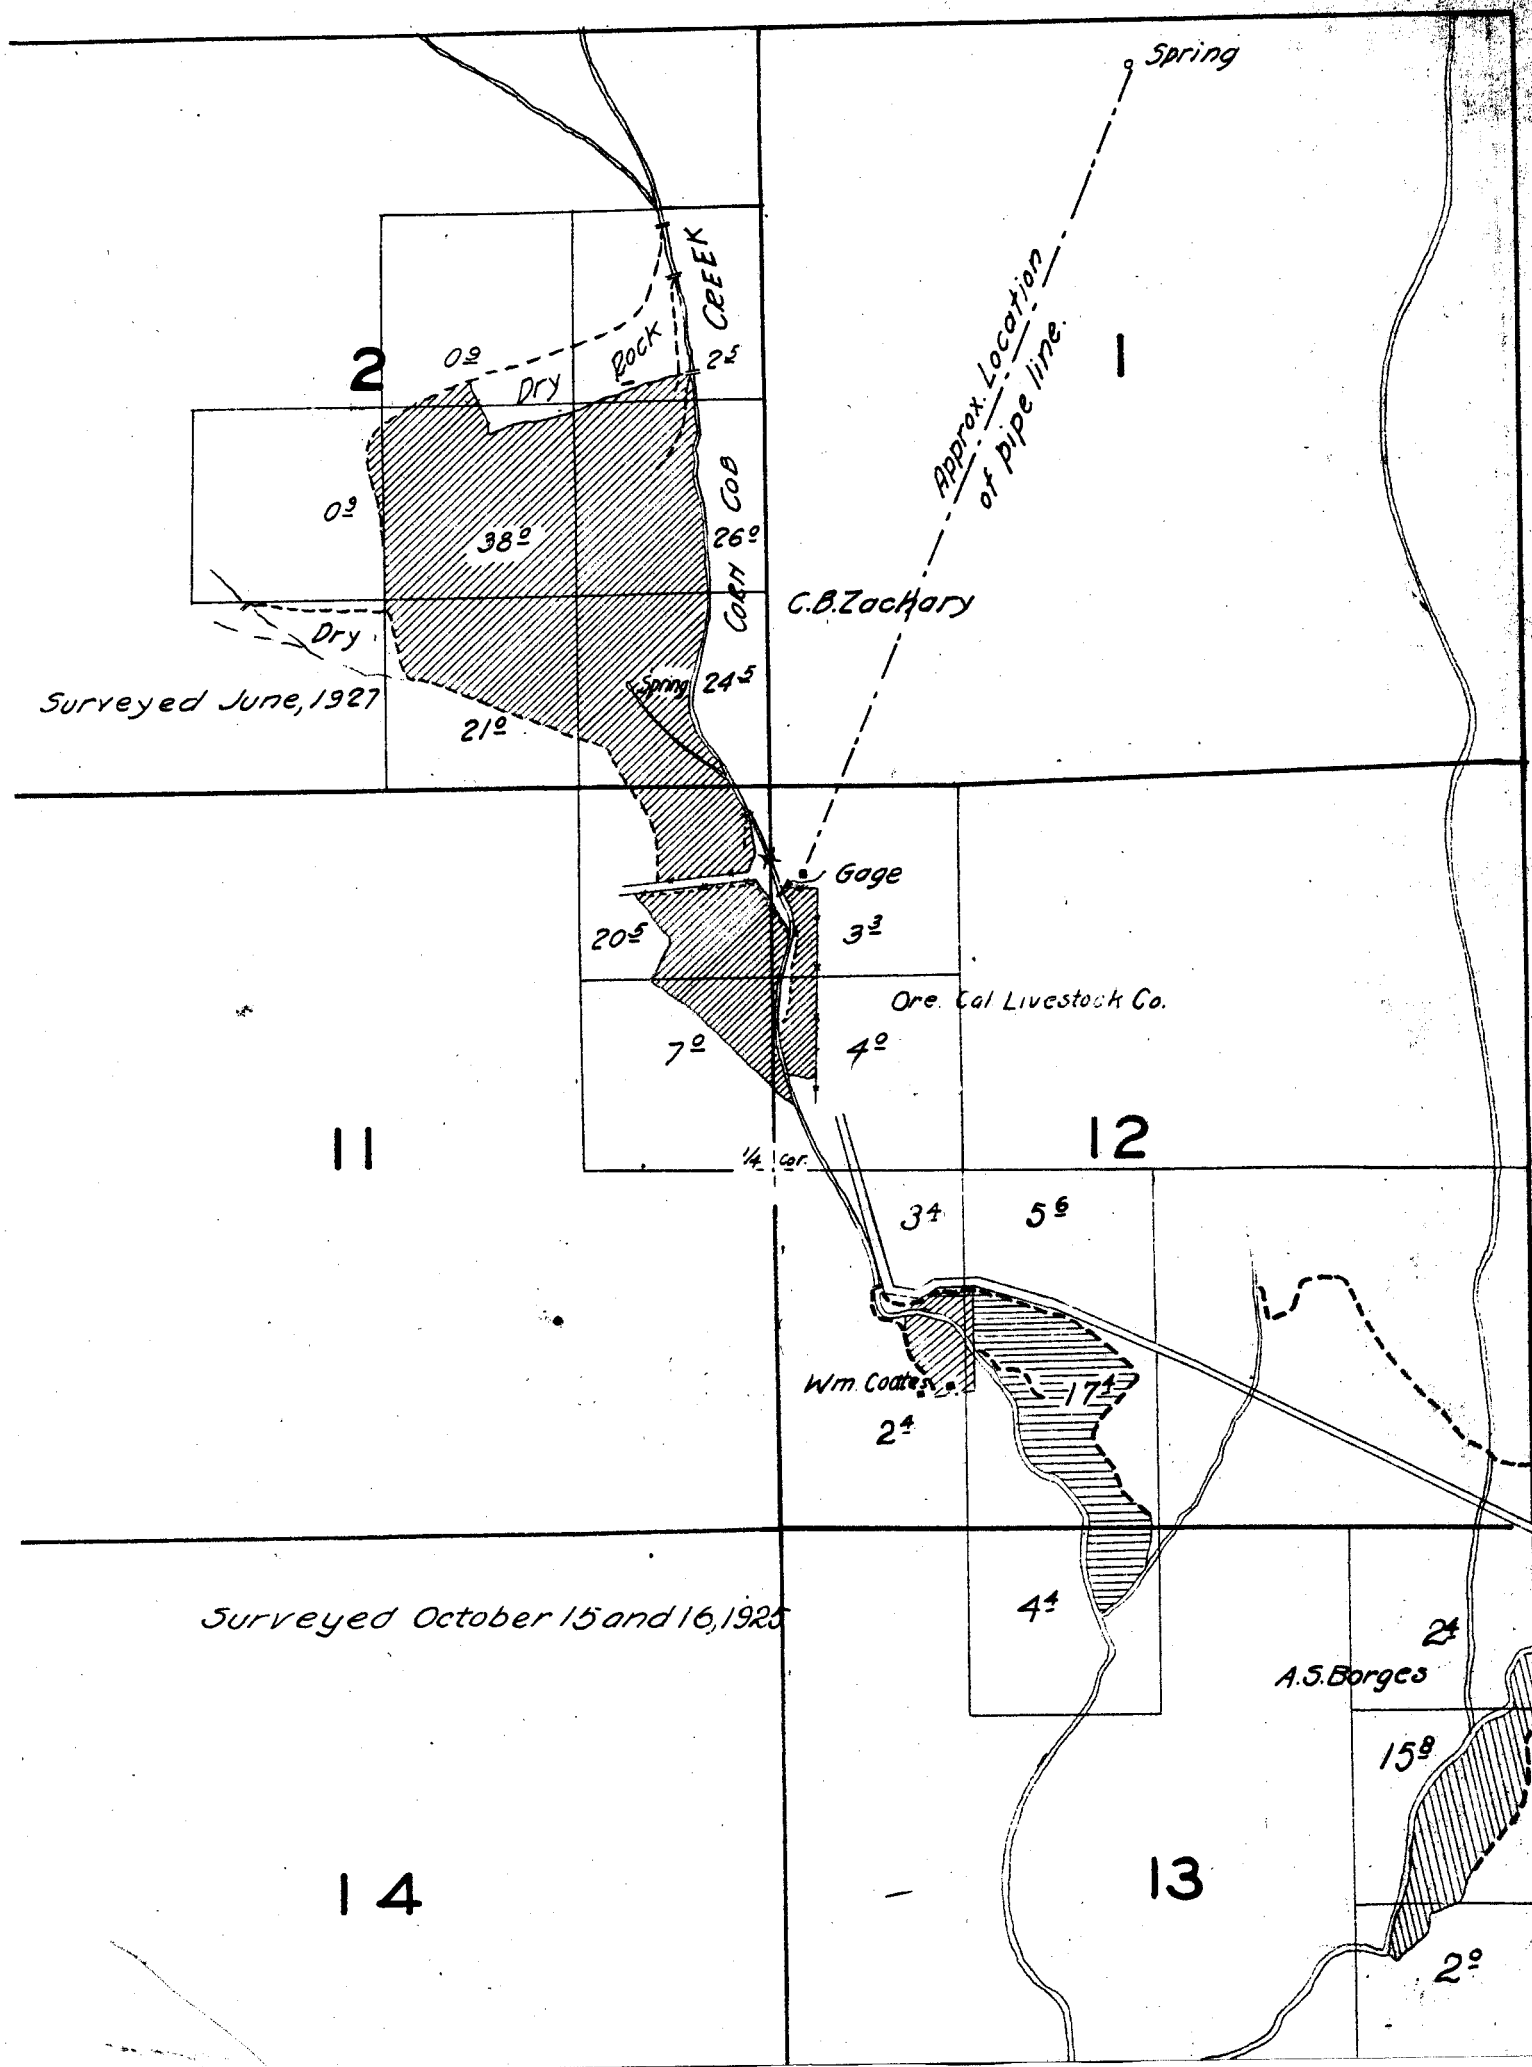

Elmer McQuinn

Lot 4.

20'

3'

6

5

CREEK

Spring

24'

Mrs Elmer McQuinn

2'

1'

32'

Lot 1.

1'

ALDER

Lot 2.

04'

46'

09'

7

Lot 3.

139'

49'

Lot 4.

Surveyed October 16, 1925.

8

18

17