


TOWNSHIP 8 S., RANGE 25 E.

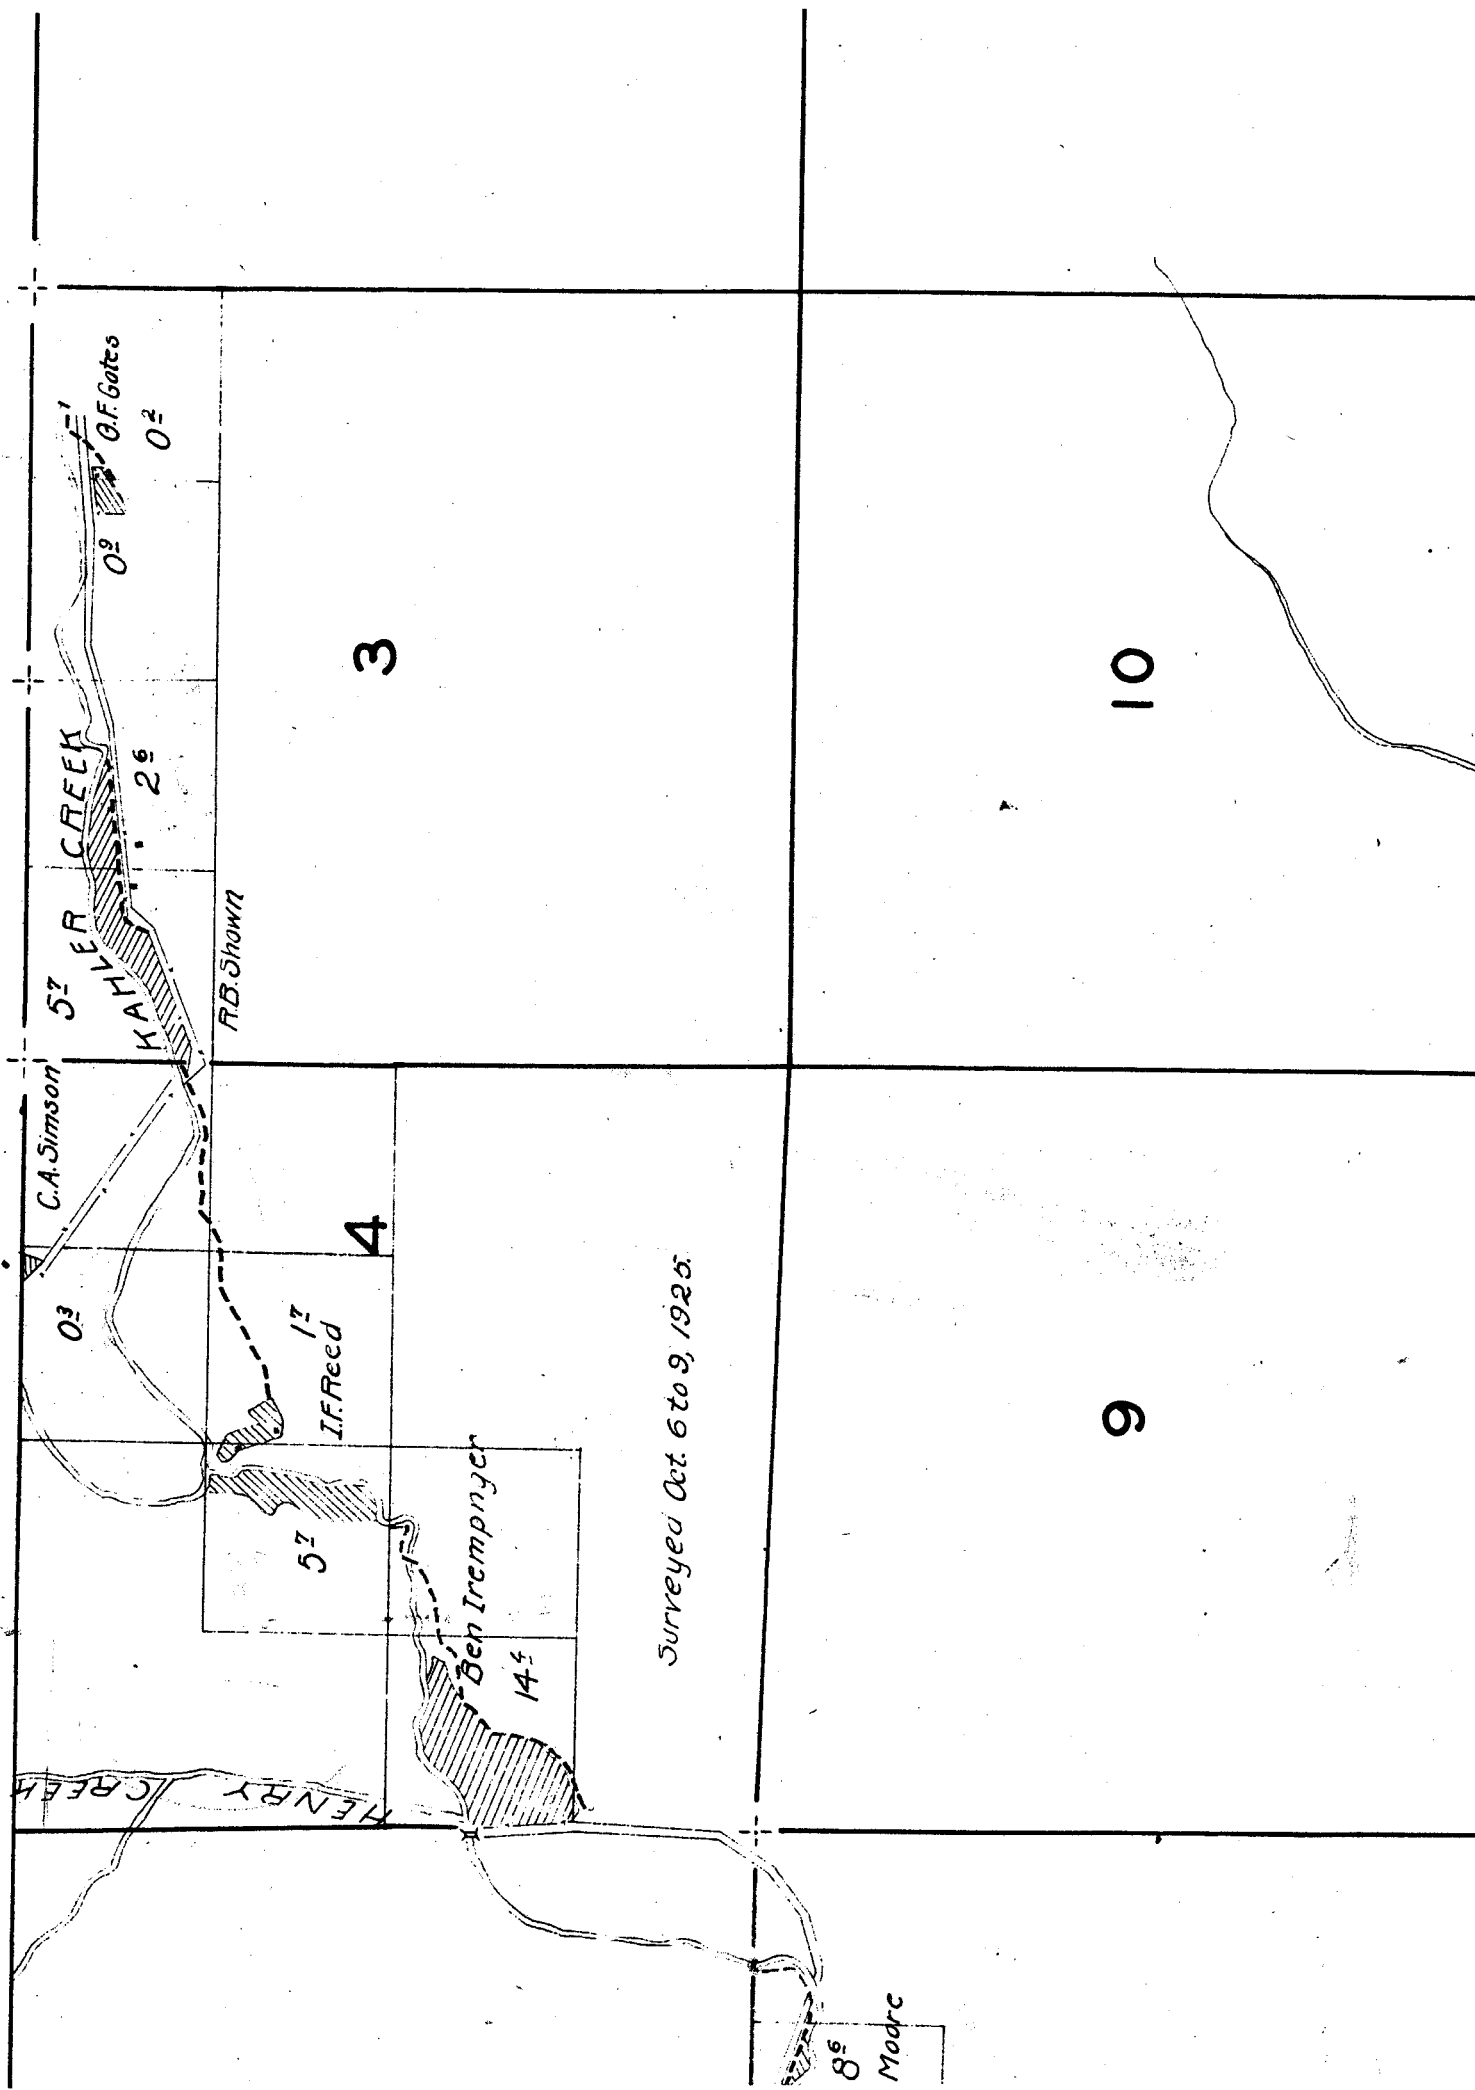


15

22

16

21

L.H. Donavan

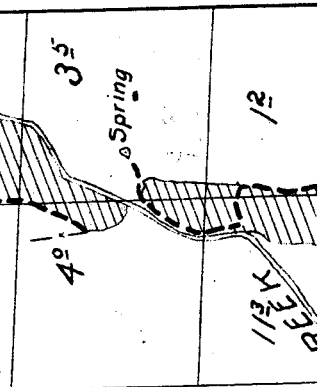

do, except
nd, is
ation.

21

22

4°

7°

3°

Spring

L.H. Donovan

1 1/2
CREEK

1/2

17°

4°

Bob Wright

HAYSTACK

J.F. Asher

28

27

Spring

17°

Surveyed Sept. 19 to 23, 1926

Steinwer

5°

C.W. Wallis

1°

A.E. Cress

1/2

33

34

13°

40°

Now C-35285

27°

0°

12°

21°

3°

Pump

B.H. Jenkins

6

5

7

13

03

8

page 8⁶
E.R. Modoc

07

A.S. Borges

4⁹

18

17

30

29

31



32

L.L. Steiner

Can Wagner

96

263

26°

20°


34


16




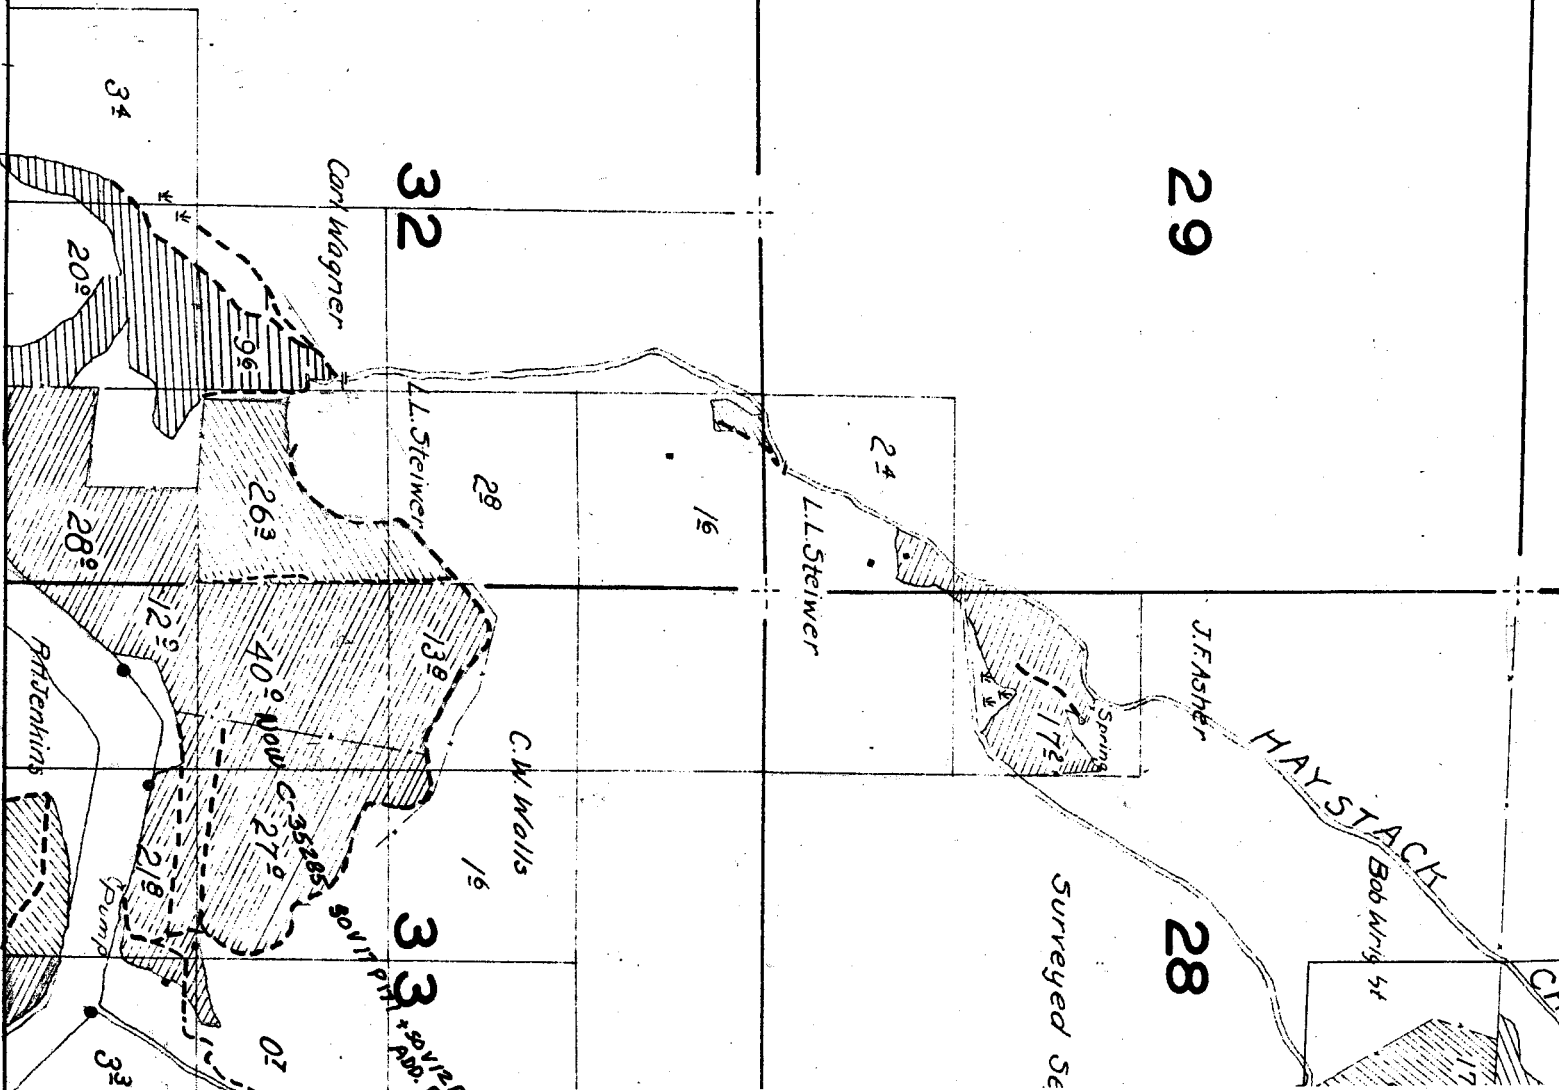

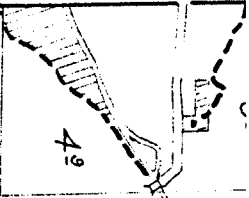

ASBorges

18

17


16

19

20

21

Note: Location of streams and roads, except in the vicinity of irrigated land, is sketched in approximate location.

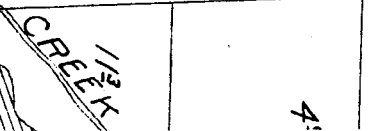

2

1

11

12

14

13

Surveyed Sept. 29, 1925.

Palm Cr.

27

26

25

34

35

36

15

14

13

22

23

24

IVE CREEK

02

62

RI Carner

17

05

