


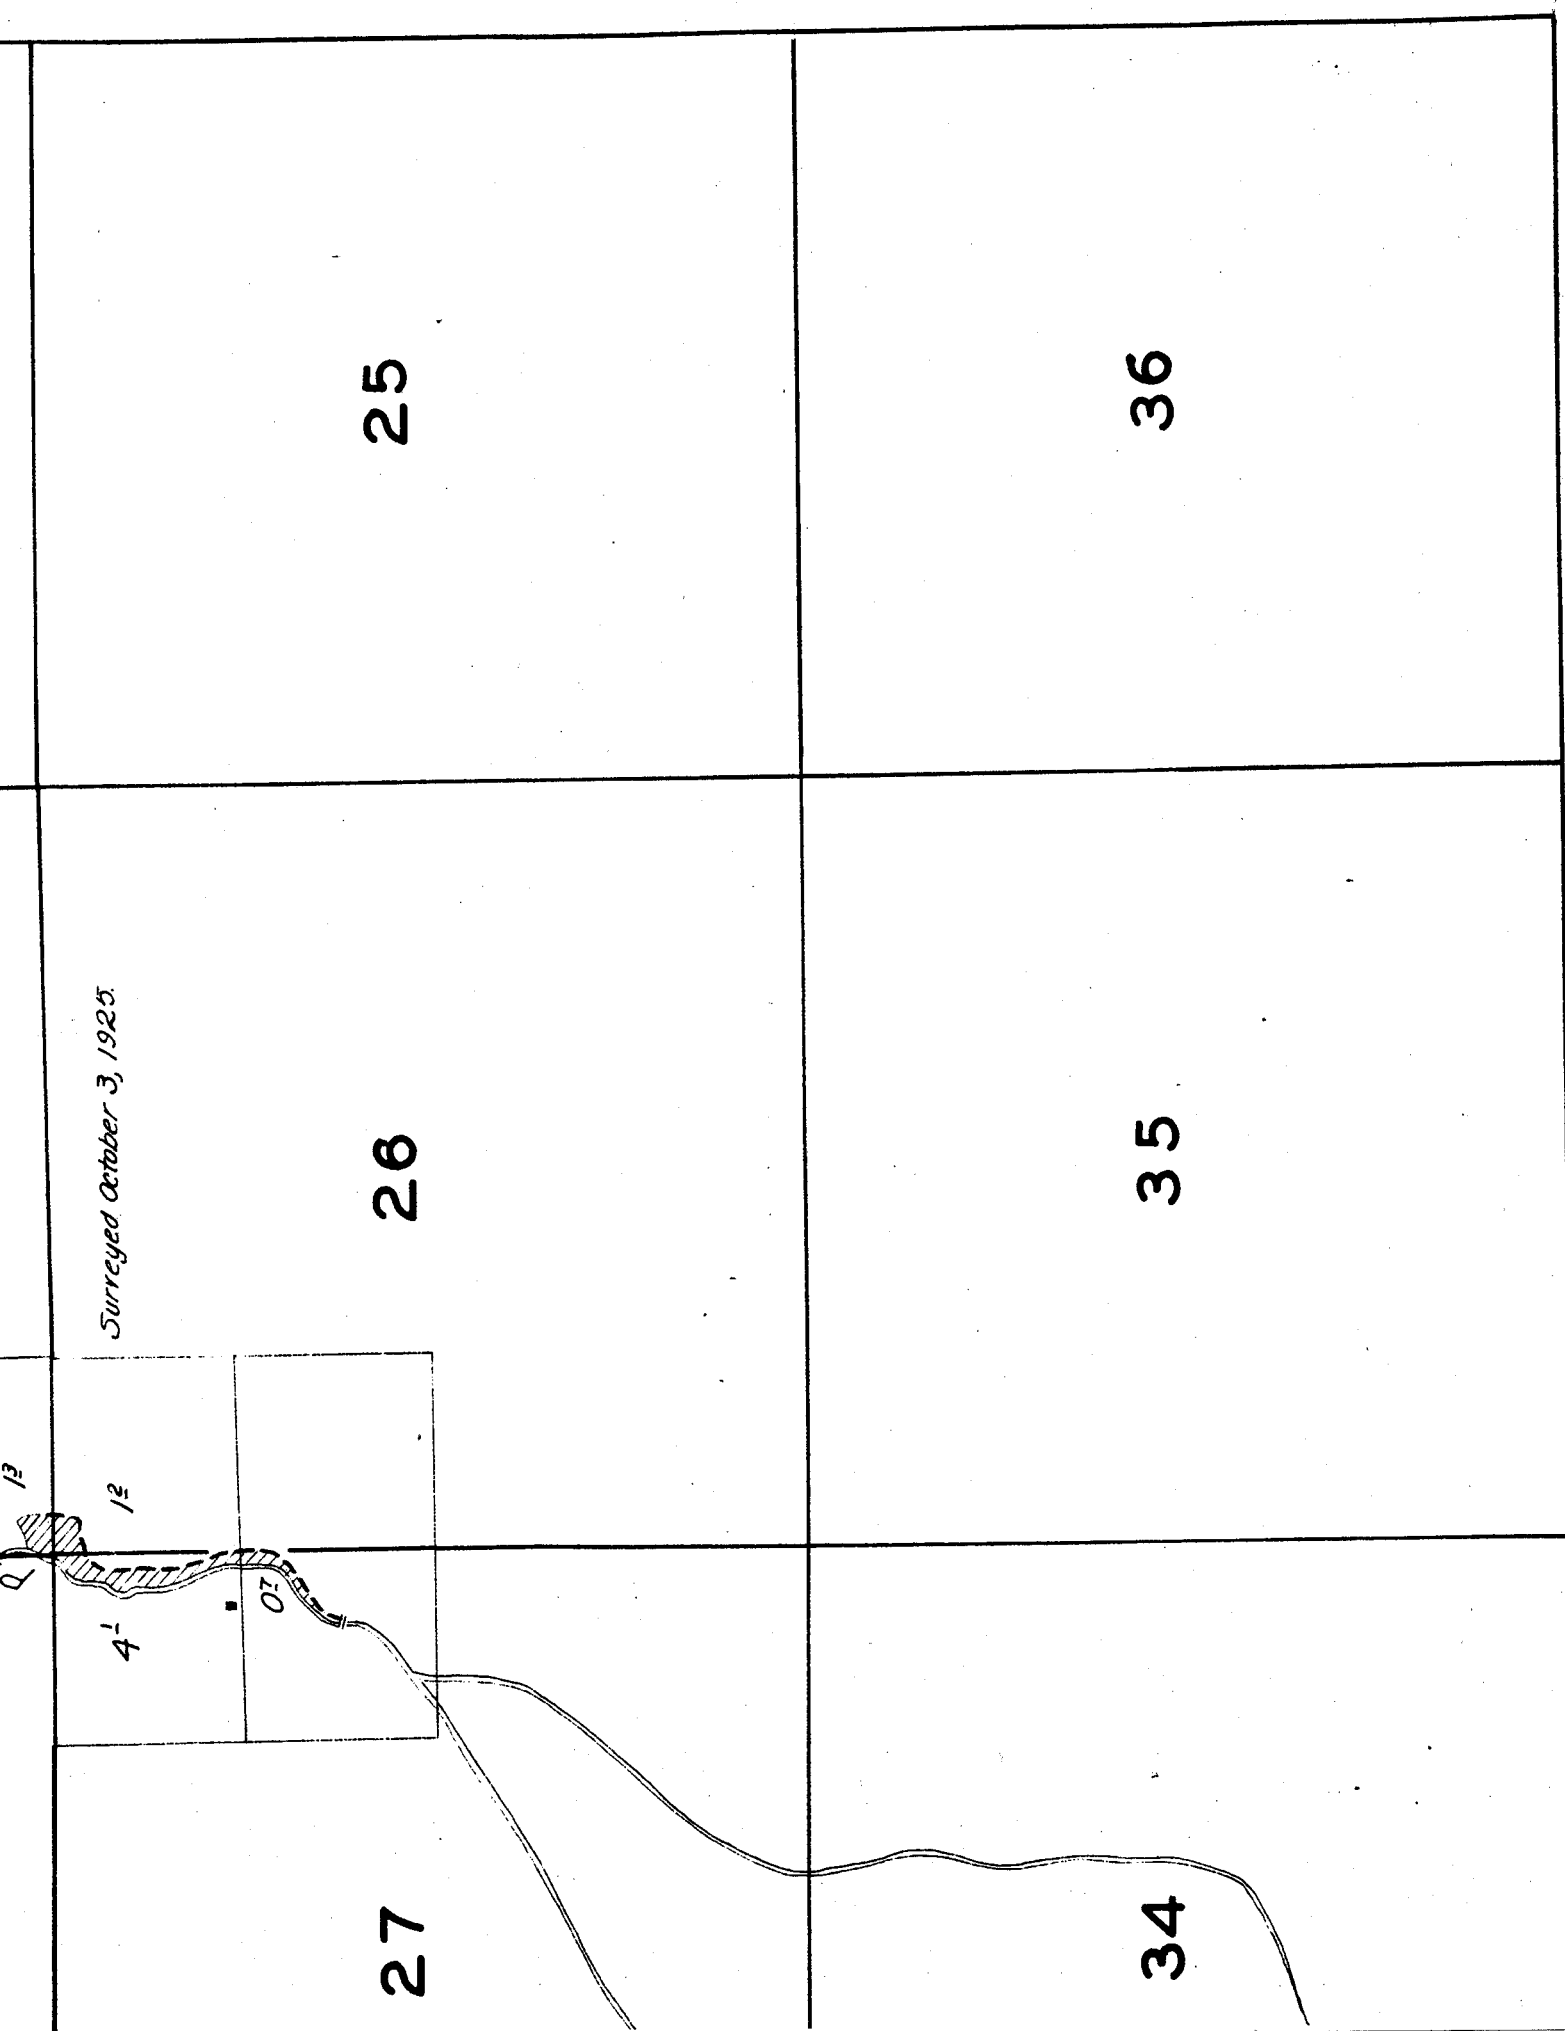

15

14

13

22

23


24


Robert Wright

PARISH CREEK

42

12

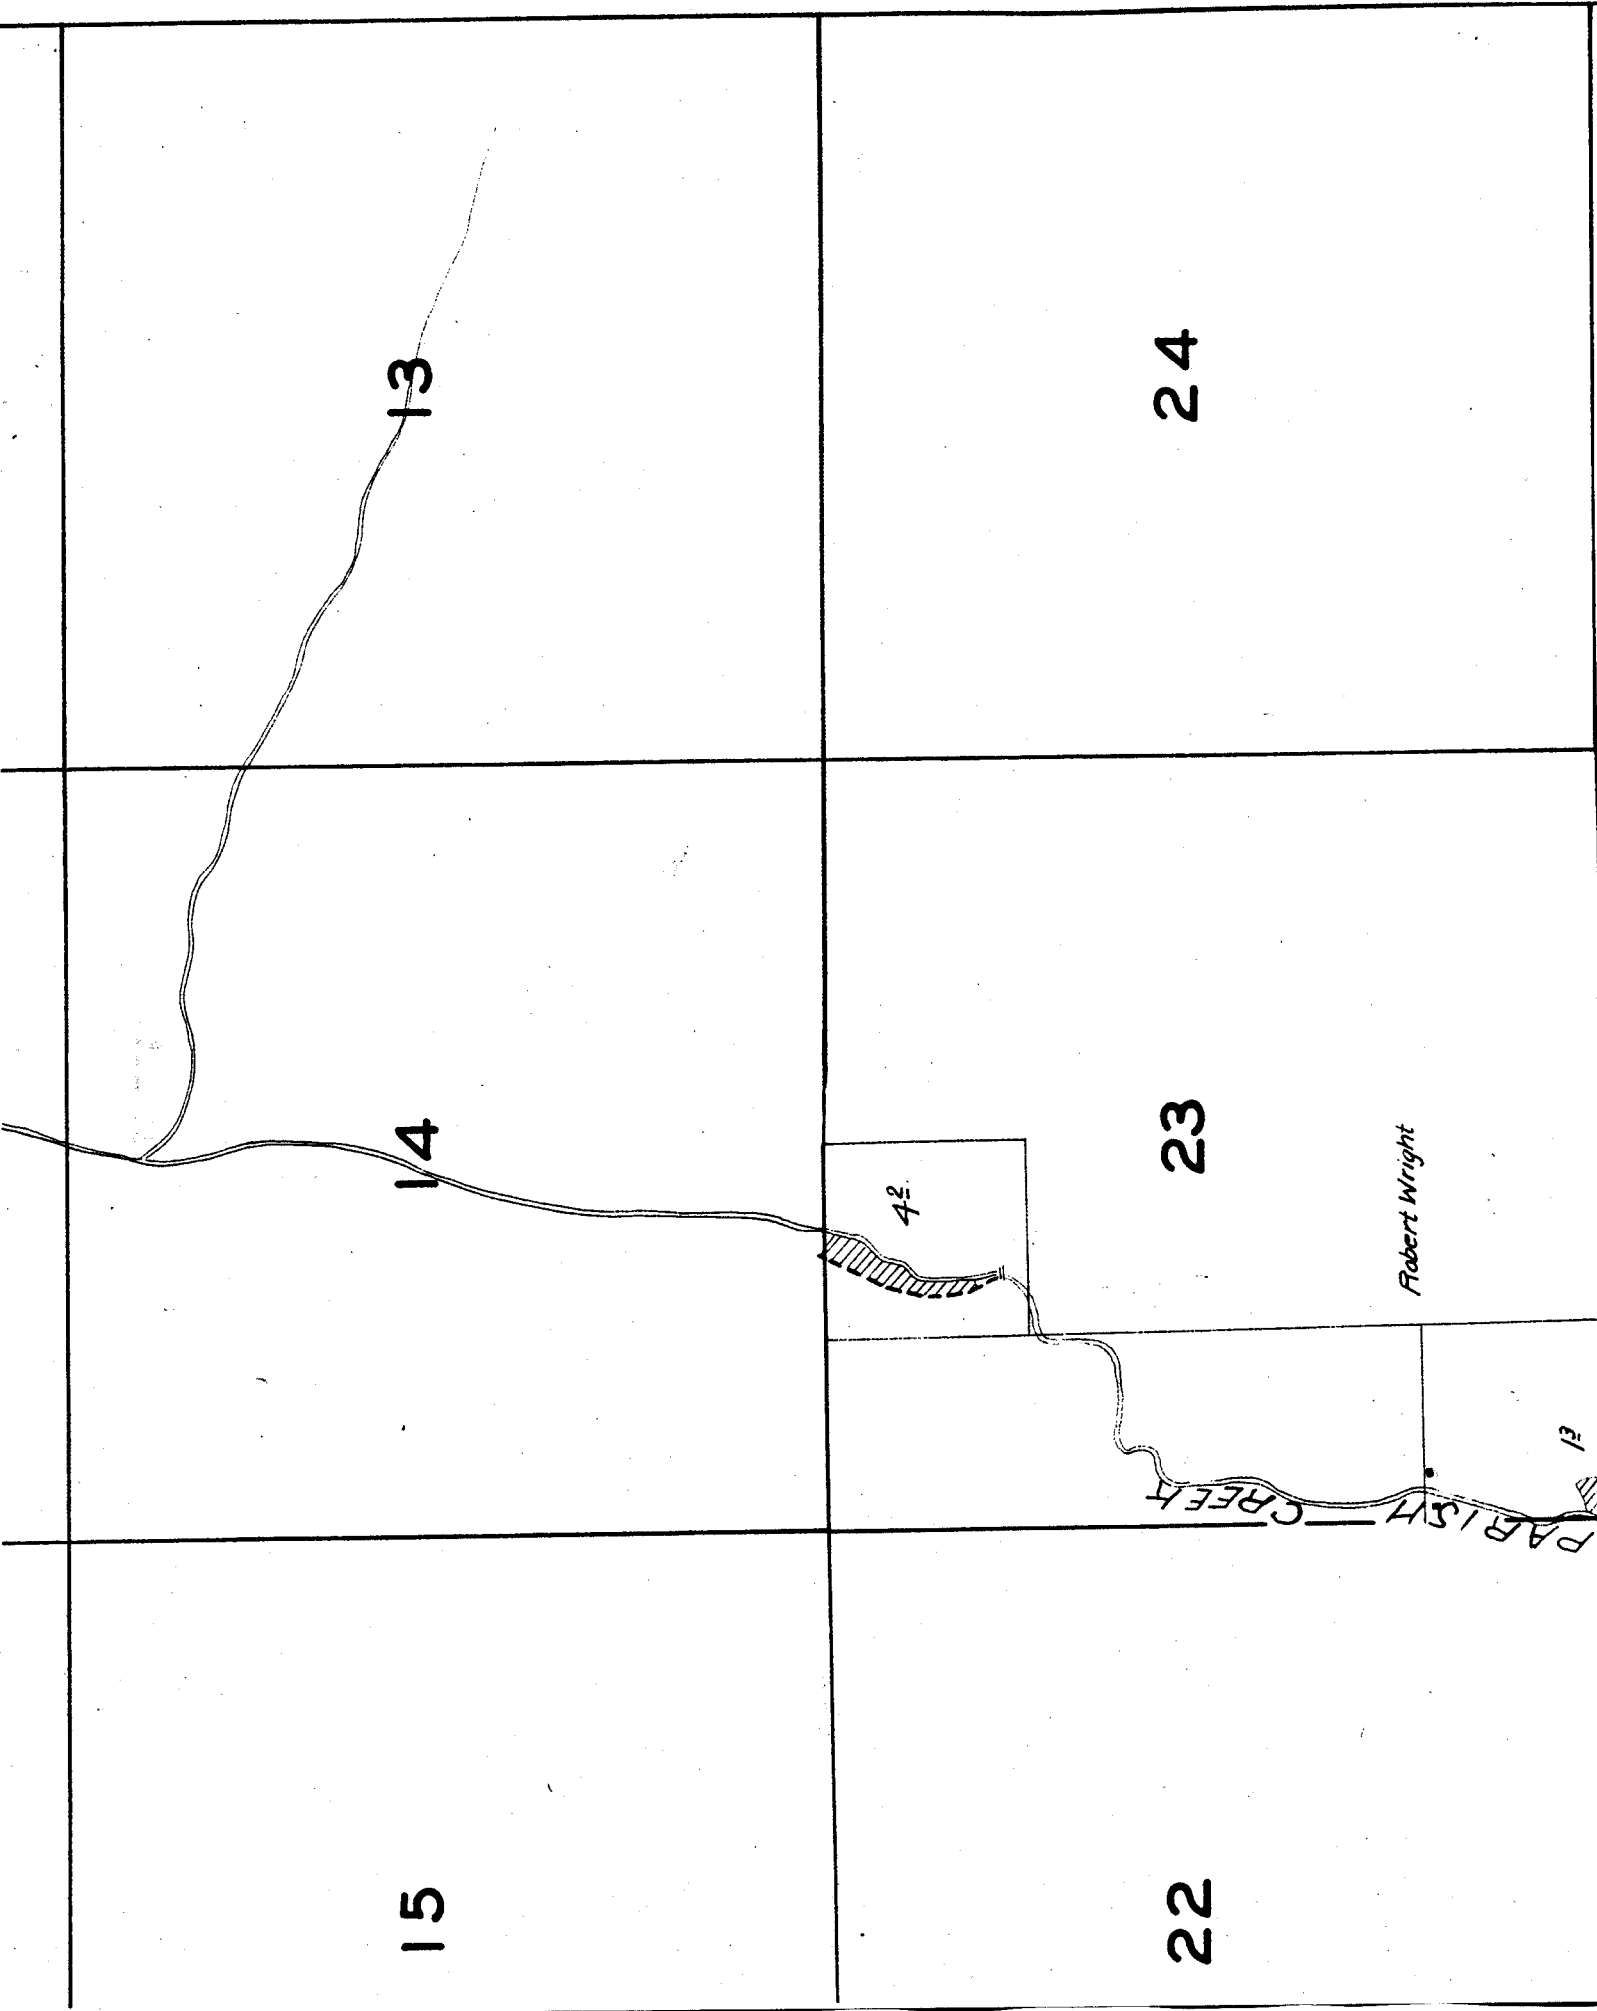

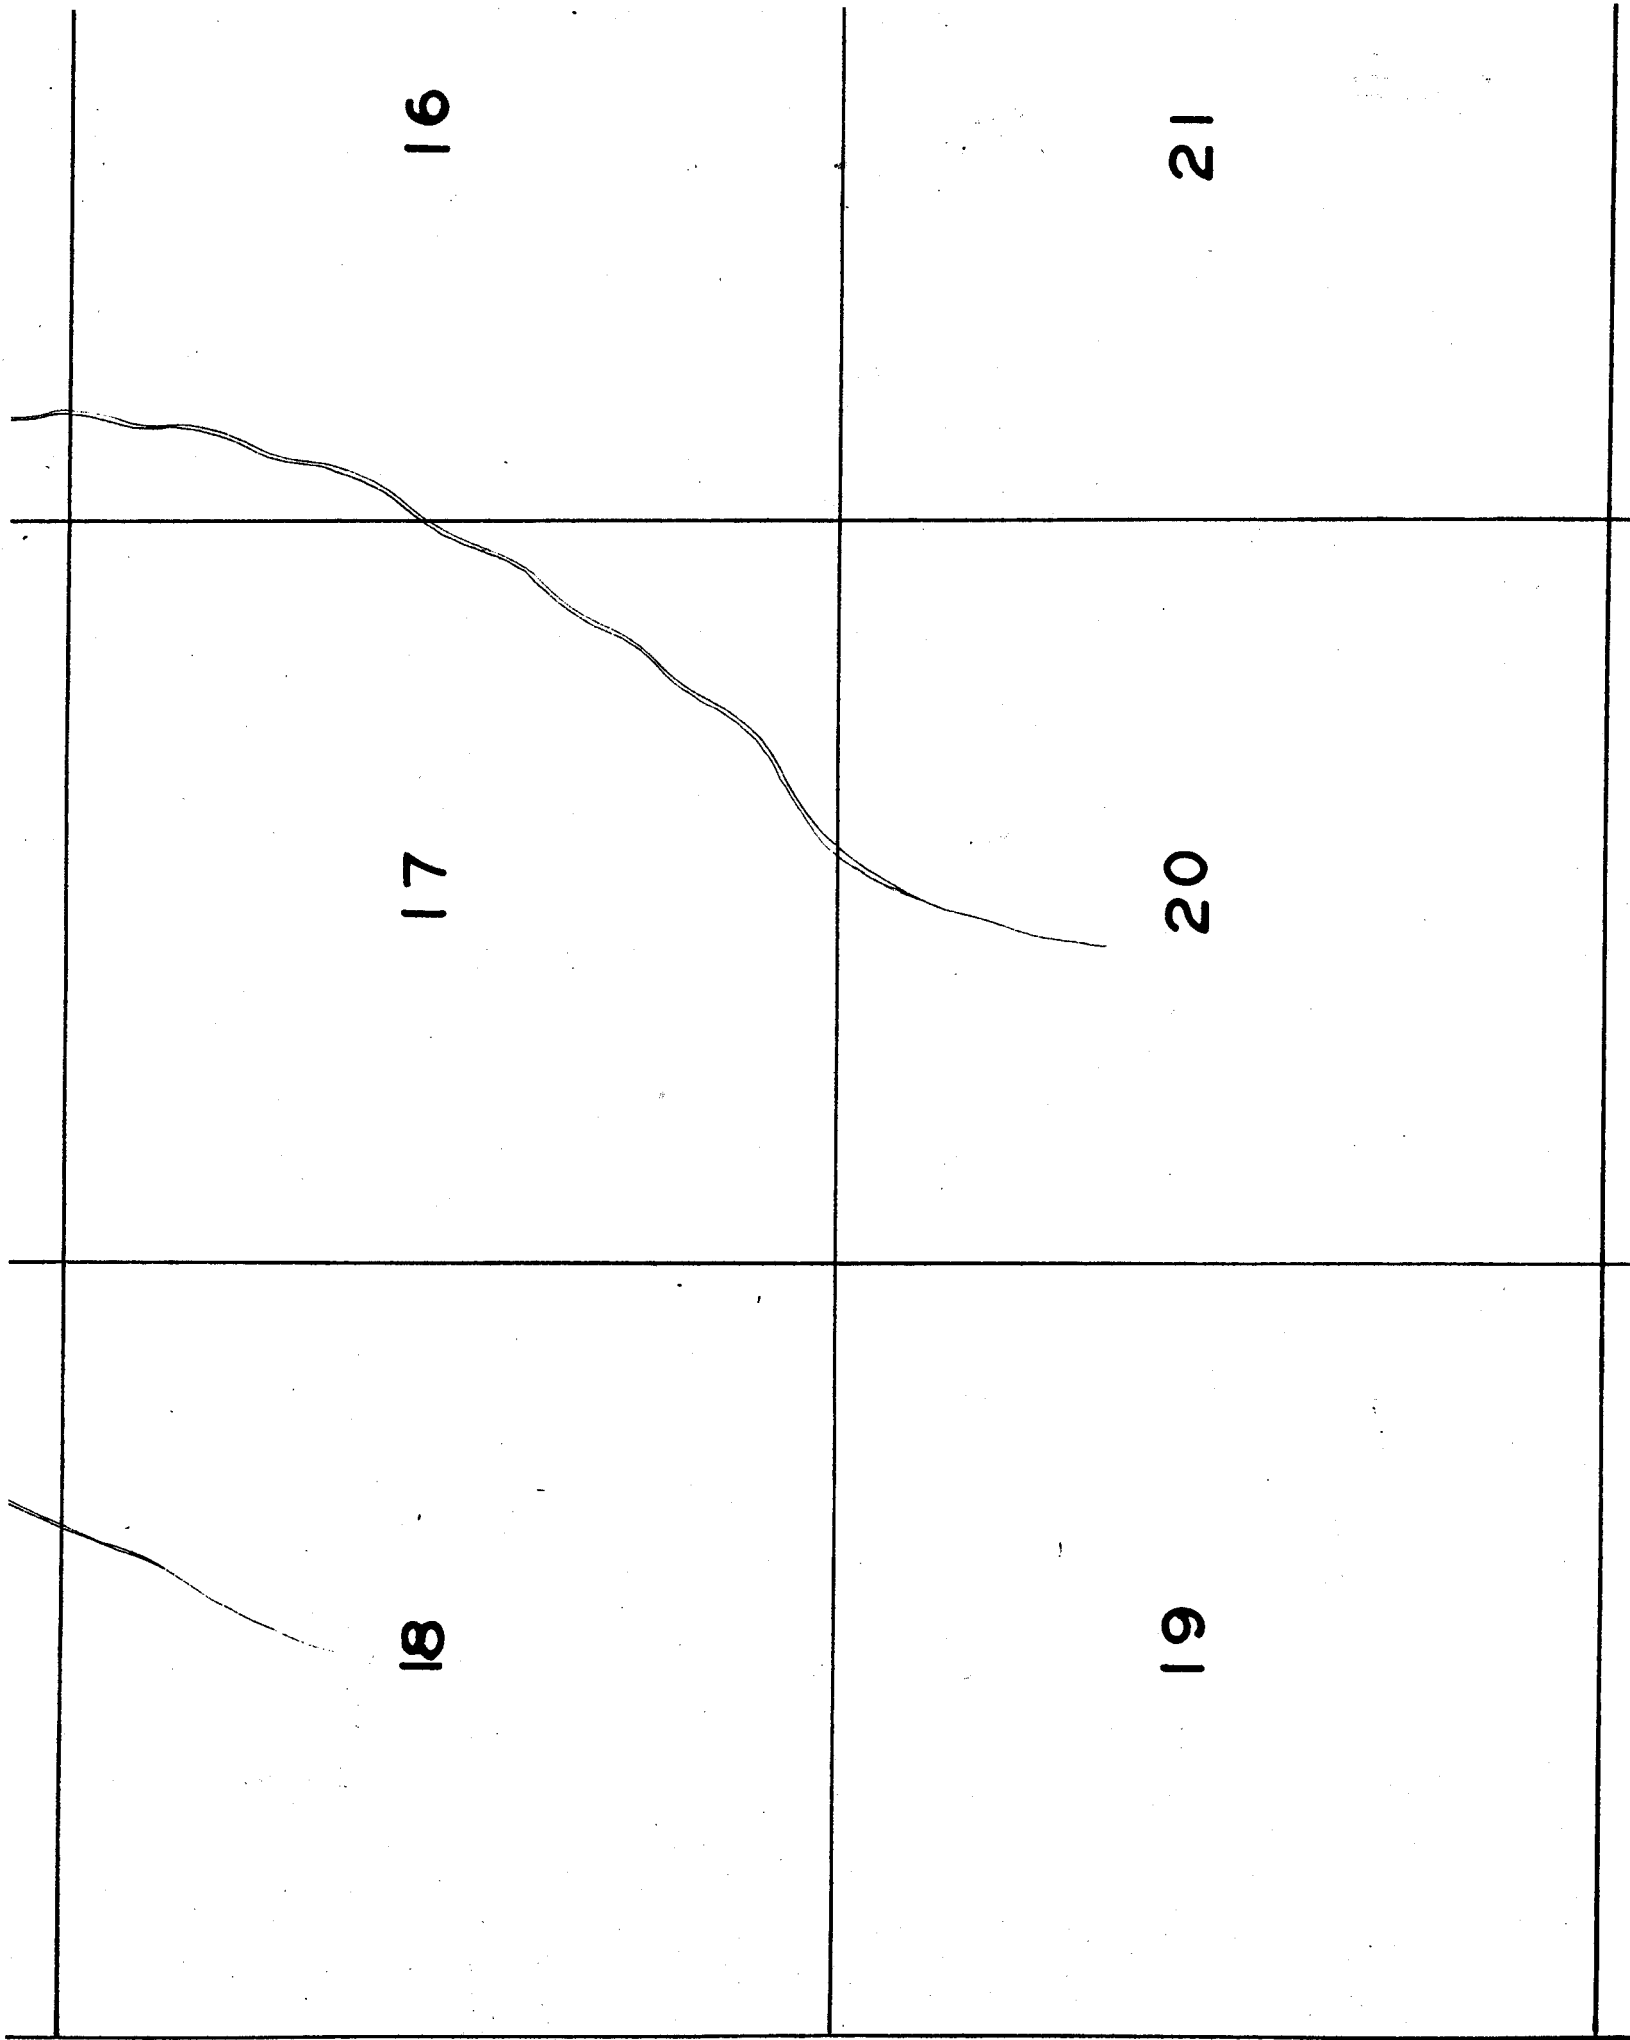

30

29

Note: Location of streams, except in the vicinity of irrigated land is sketched in approximate location.

28

31

32

33

16

15

21


22

PARISH CREEK


Roberts

13

TOWNSHIP 9 S., RANGE 24E.

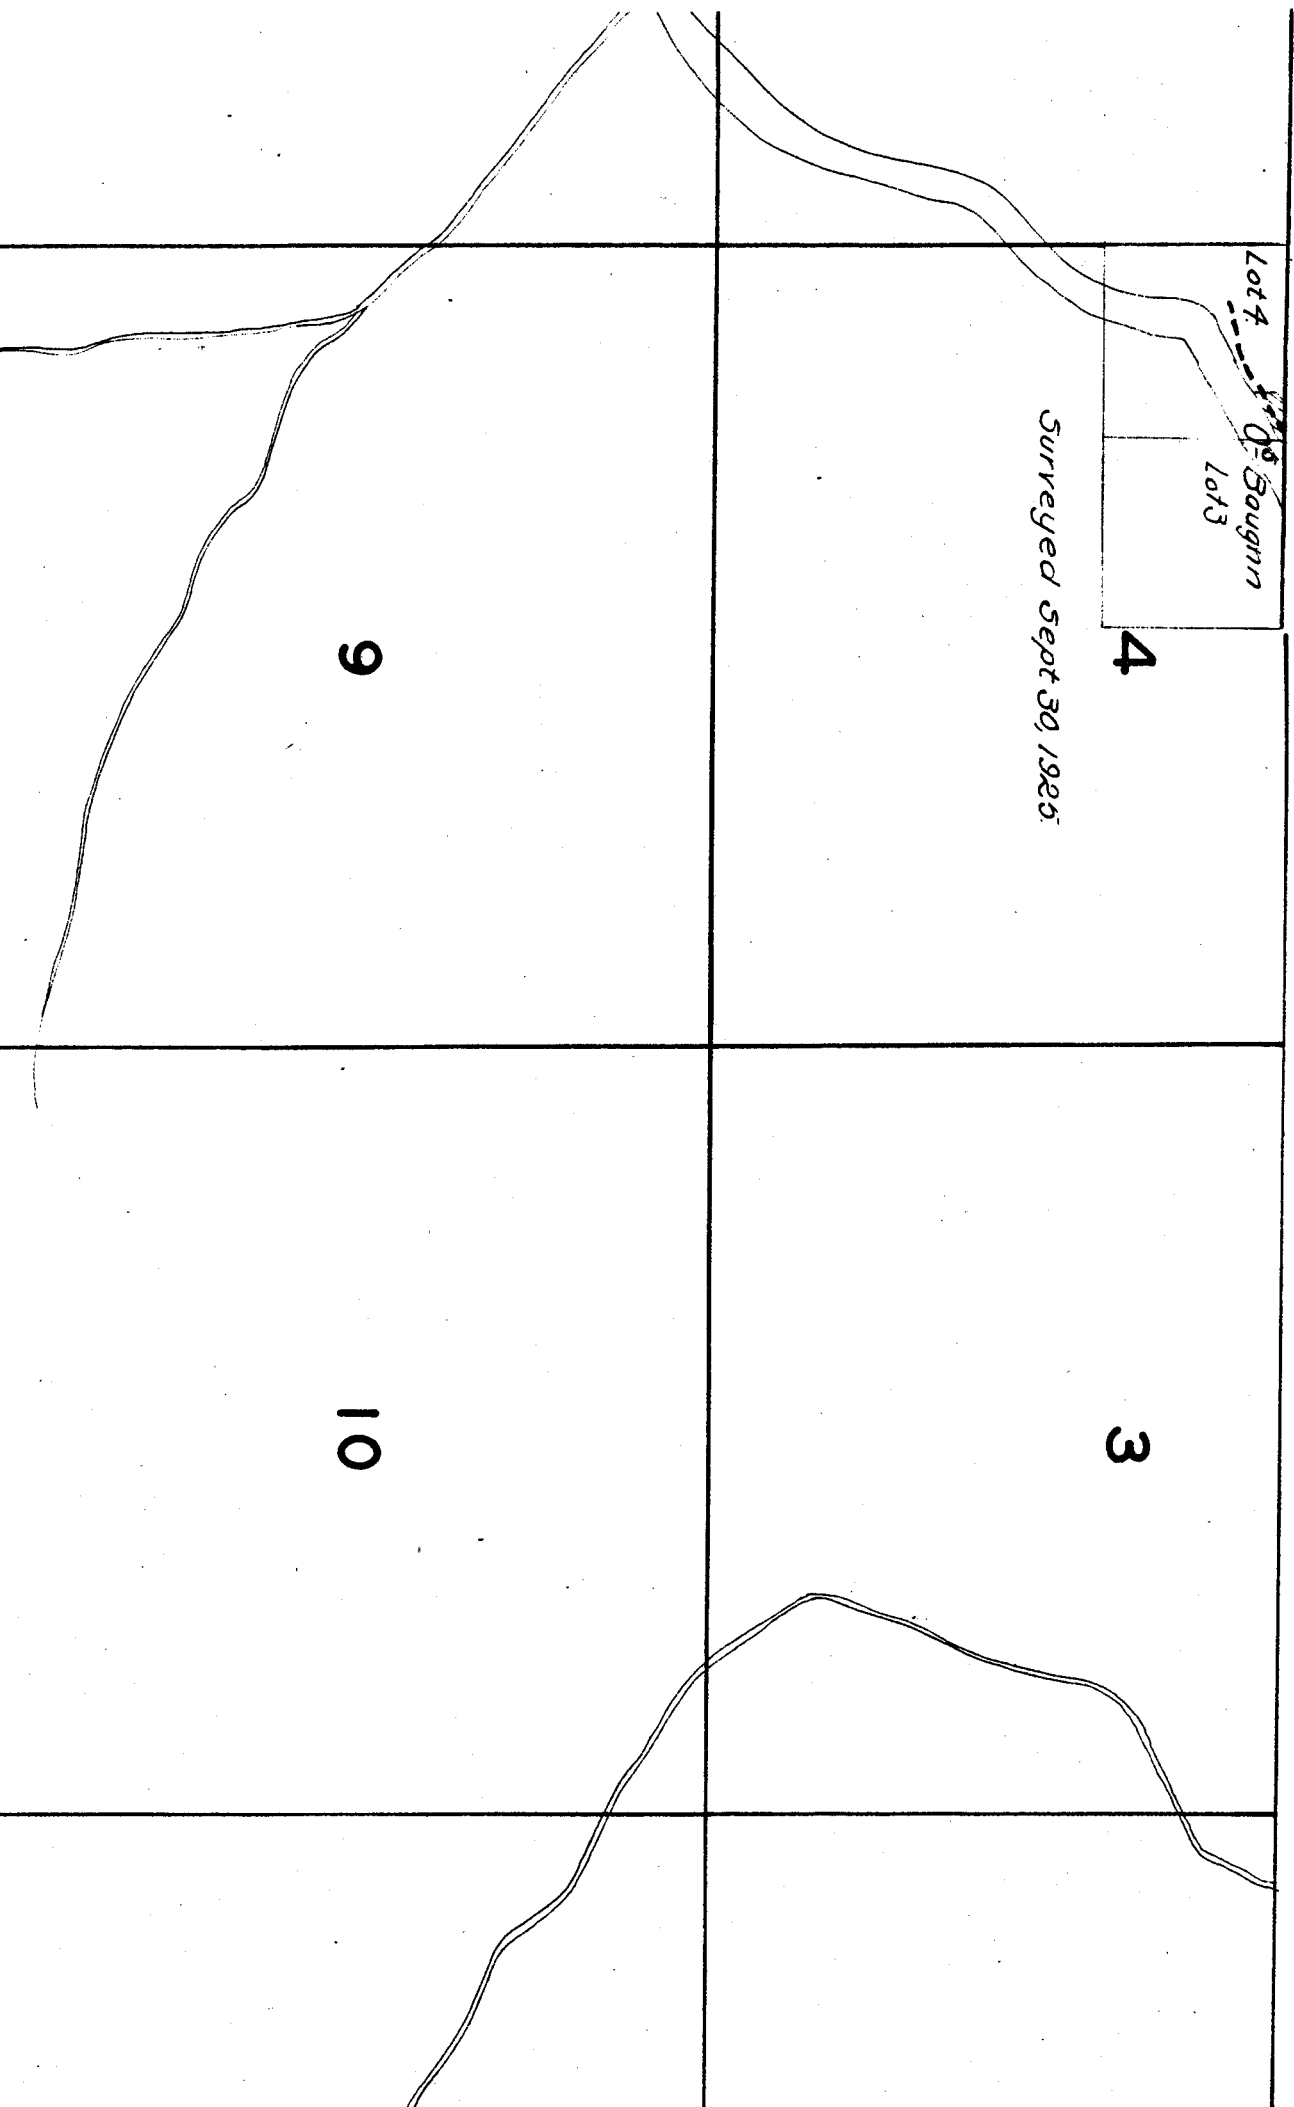

2

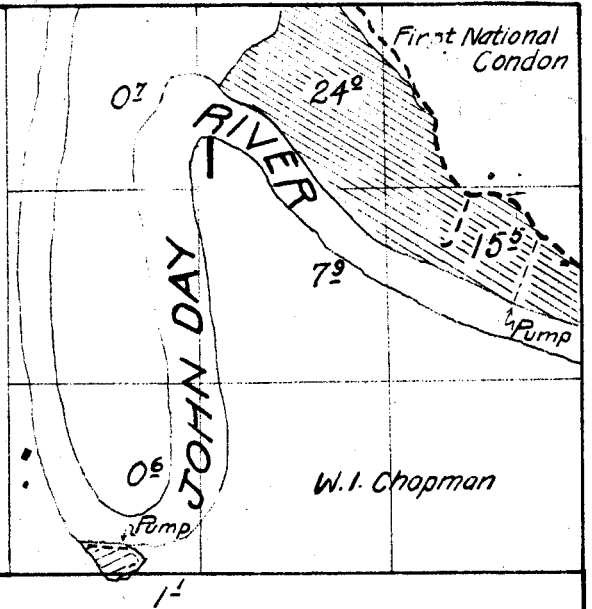


Surveyed Sept. 29, 1925.

11

12

14

13

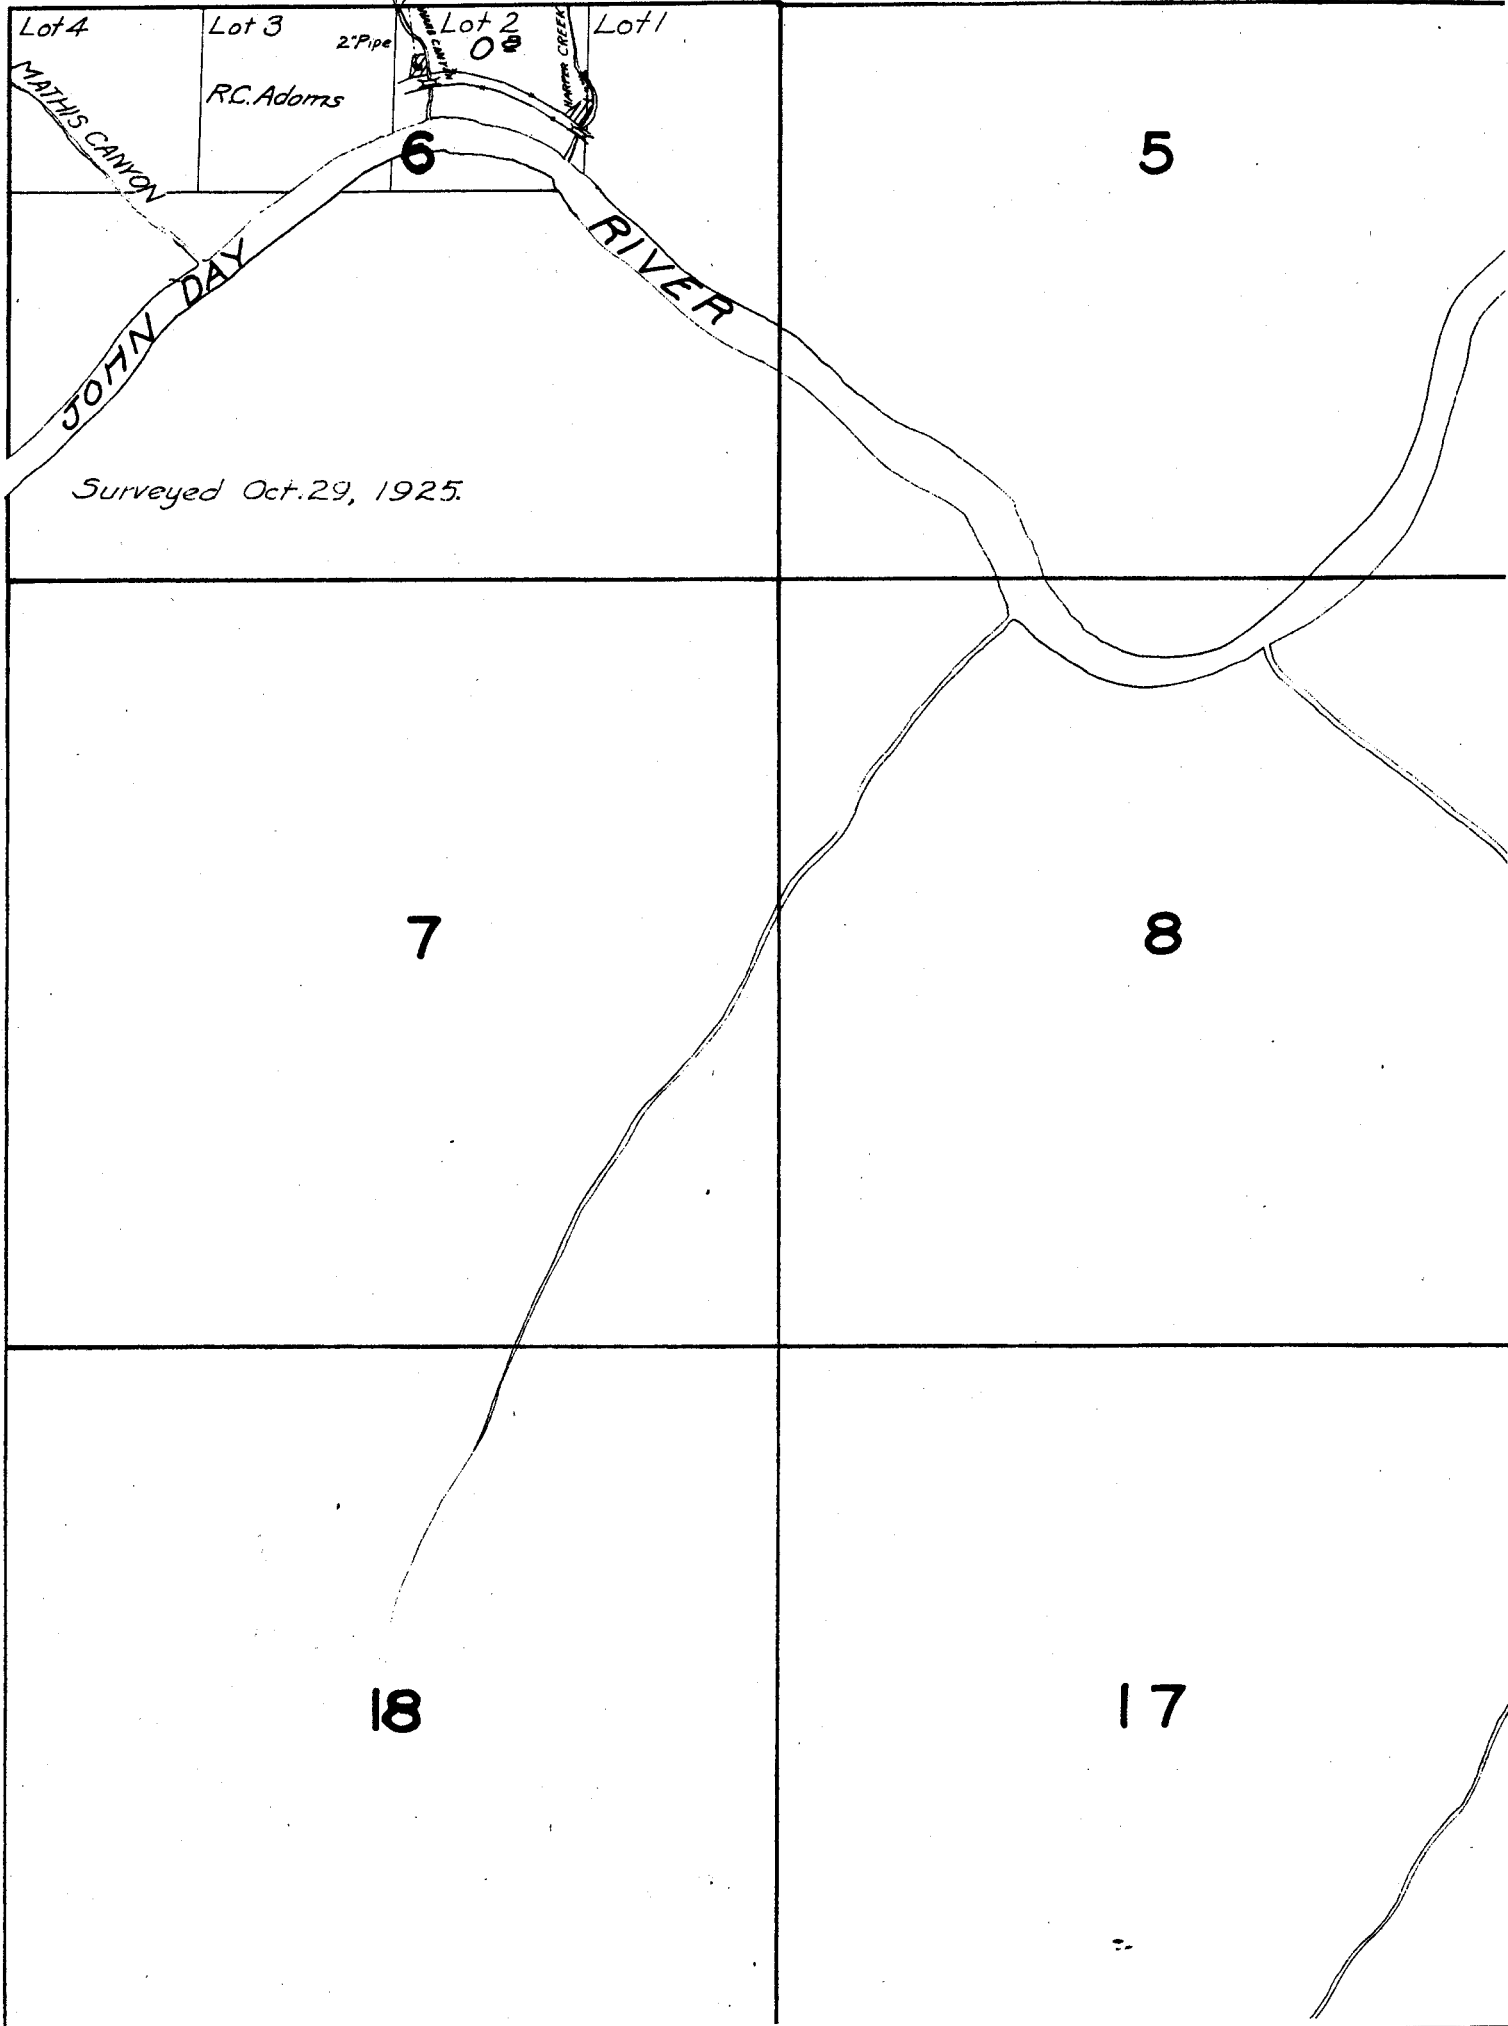

21

22

4'

28

27

33

34

