


27	26	25
34	35	36

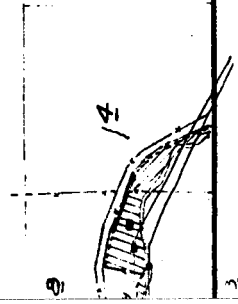

15

14


13

22

23

24

sketched in approximate
at in the vicinity of

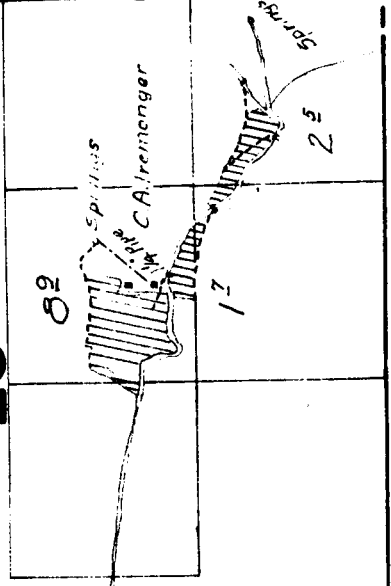

6

5

7

8

18

17

30

29

28

Lot 3
Lot 4

EBUTLE
30° 23' 30"

Edwards & Cooke

0 5

17 5
27 8

E.J. Tipley

31

32

FOSSIL

33

C. Johnson

101

CRELL

JOHN DAY HIGHWAY

COTTONWOOD

C.L. Prindle

0 3

Chas. W. Morris

0 2

City Reservoir
865' x 65'

Dry Groun

Flume

6 9

DEFLORY

0 1

Mrs. Nancu Clark

6 2

CELEX

Cemetery

LA MII

Rocks end

JOHN DAY HIGHWAY

CC Busby

509'

Surveyed Nov. 12, 14, 2

18


17

16

19

20

21

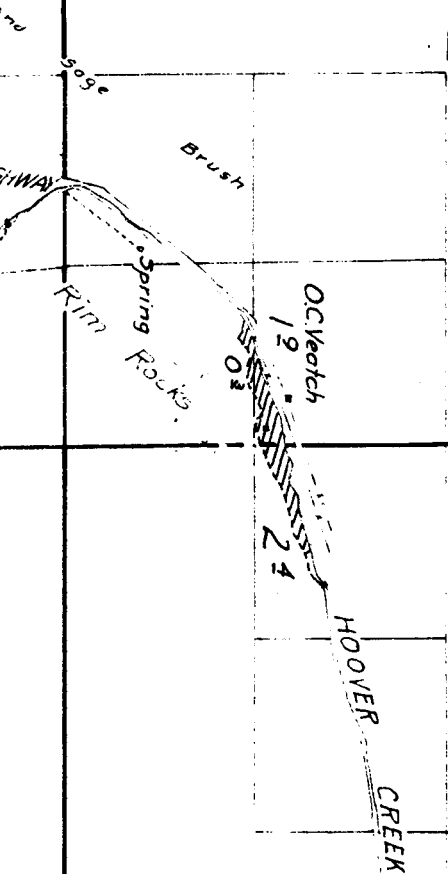

2


1

11

12

14

13

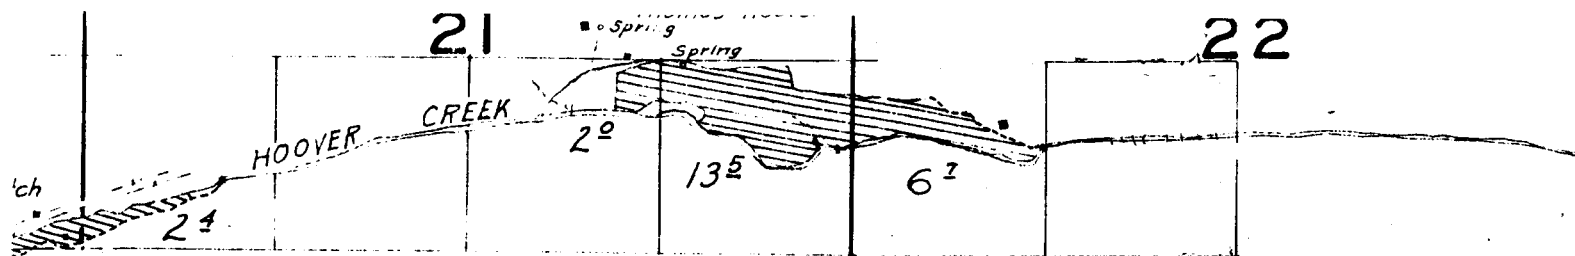

NOTE: Streams sketched in approximate location except in the vicinity of irrigated land.


28

27

Surveyed Nov. 12, 14, 20, & 21, 1925.


FOSSIL 33

34

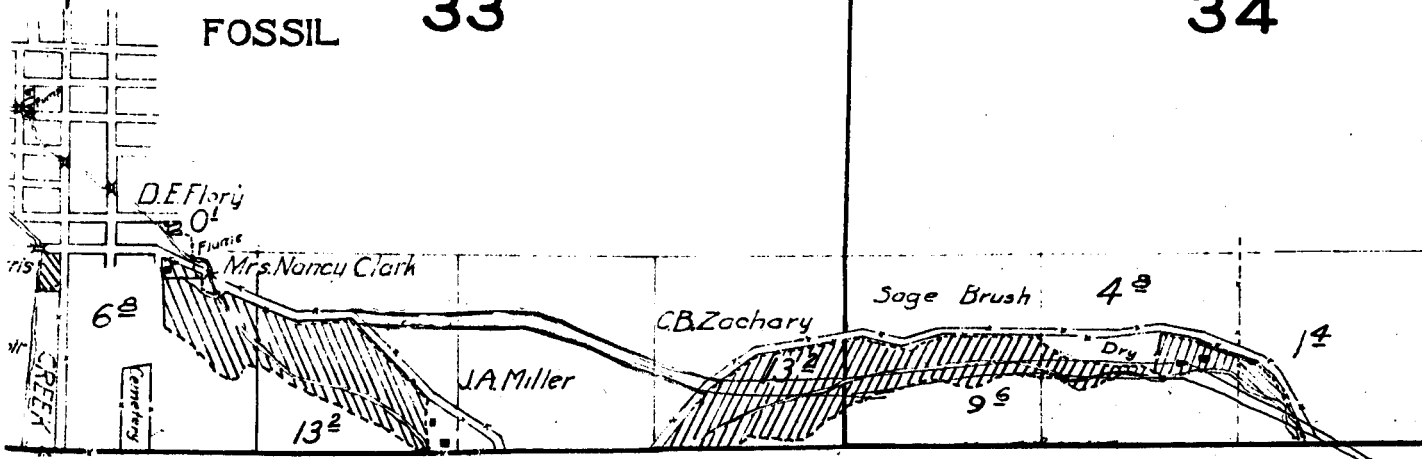


16

15

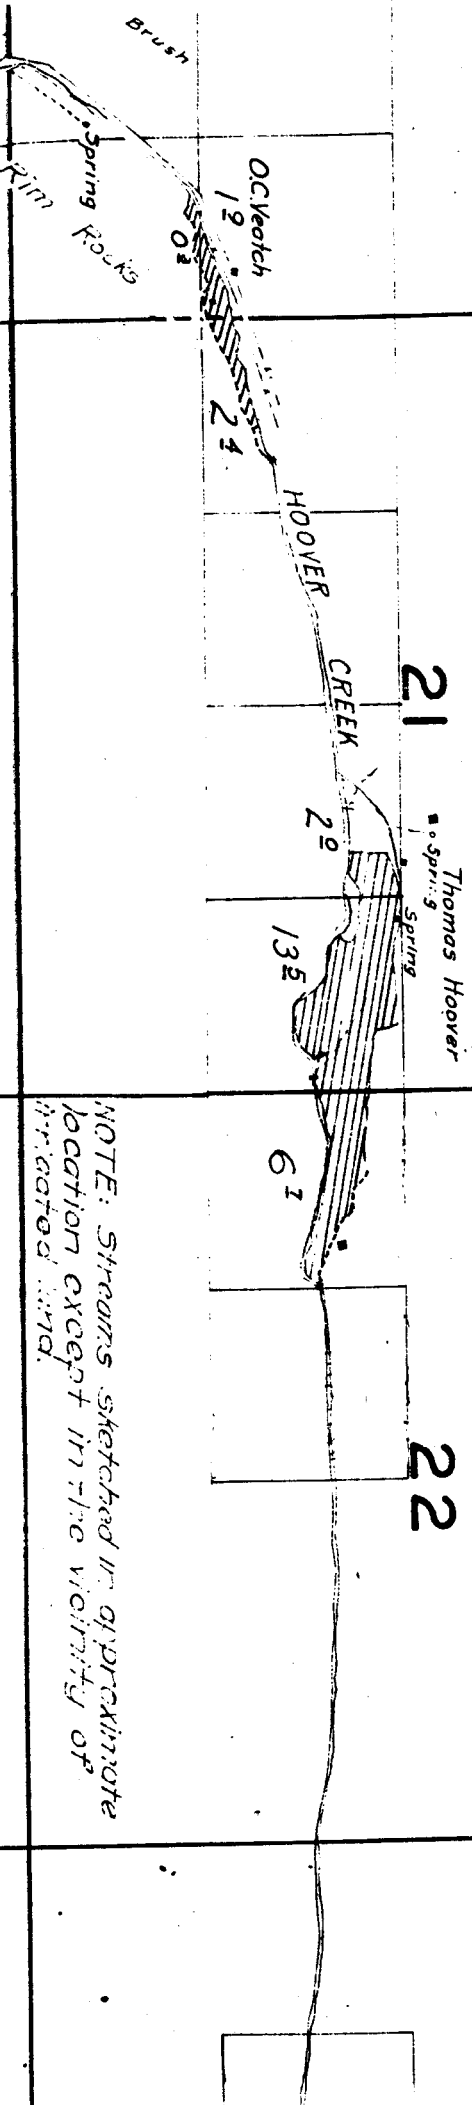

NOTE: Streams sketched in approximate location except in the vicinity of irrigated land.

TOWNSHIP 7 S., RANGE 21 E.

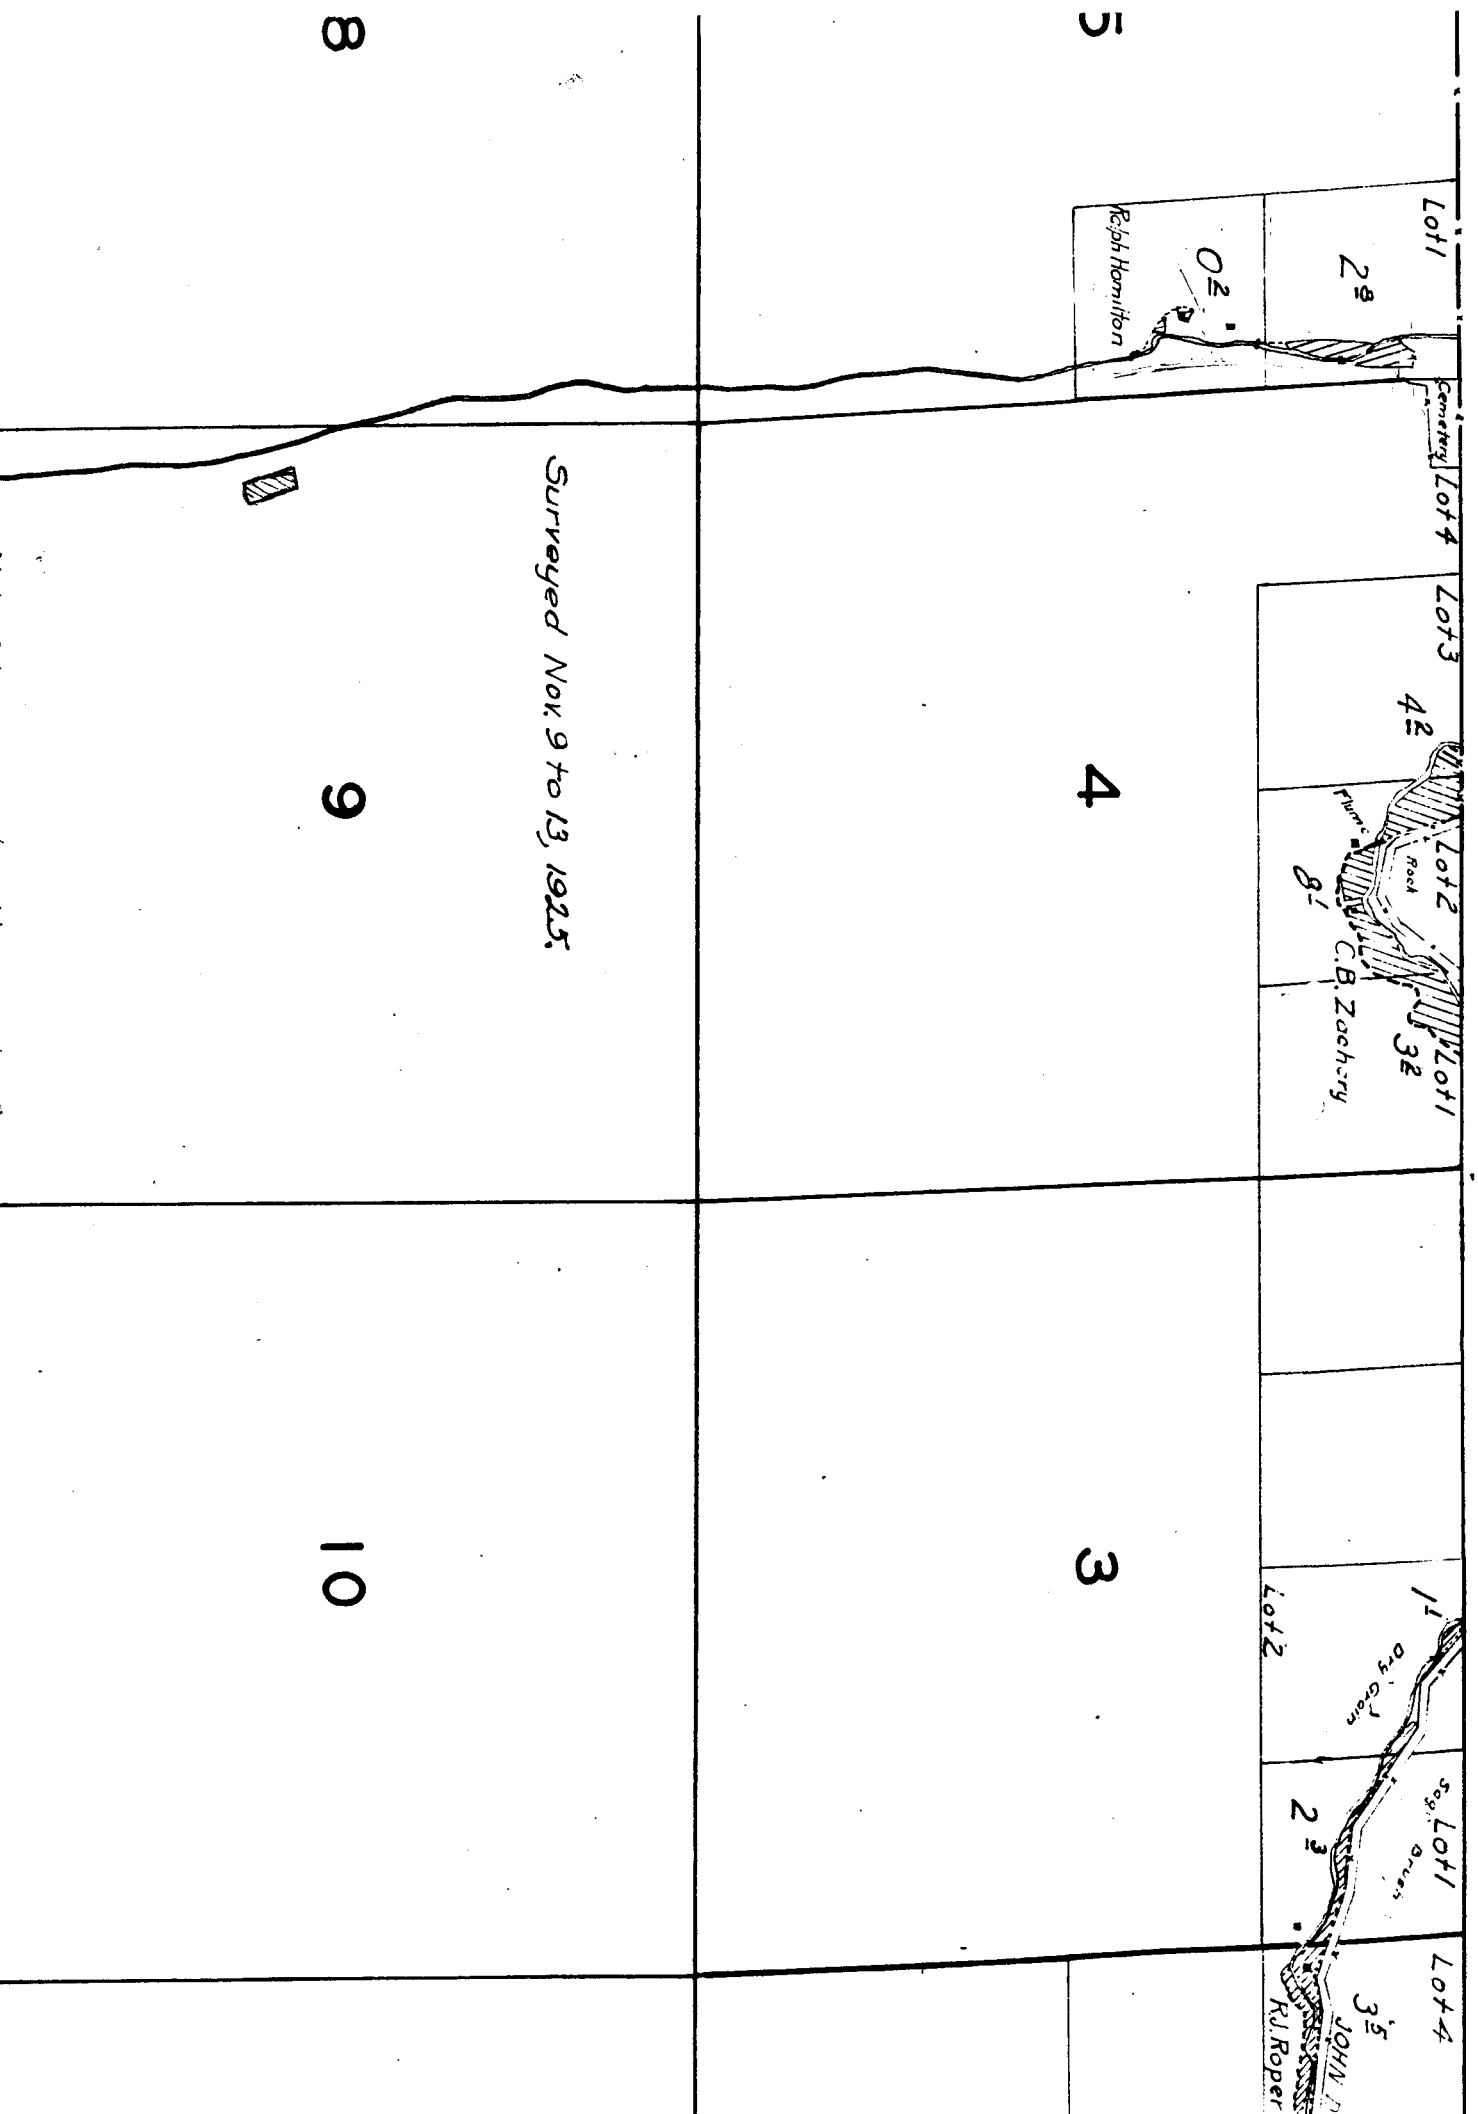

Note: Streams not in the vicinity of
irrigated lands sketched in approximate location.

COTTONWOOD

7

16

15

C.L. Rindie 31

31

urveyed June, 1927

CREEK

0

21

22

Note: Location according
to Mr Ball
FW Ball School

22

FW Ball

School

27


26

25

34

35

36

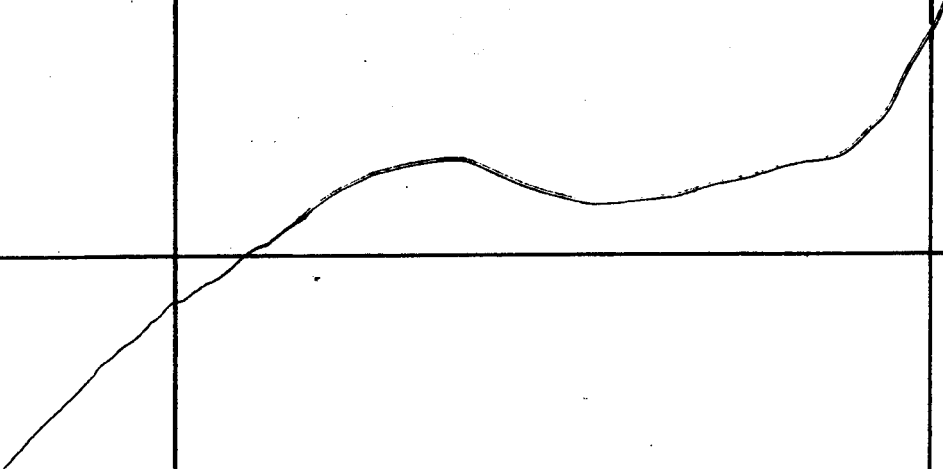

15


14

22


23

24

Location according
to Mt. Bell

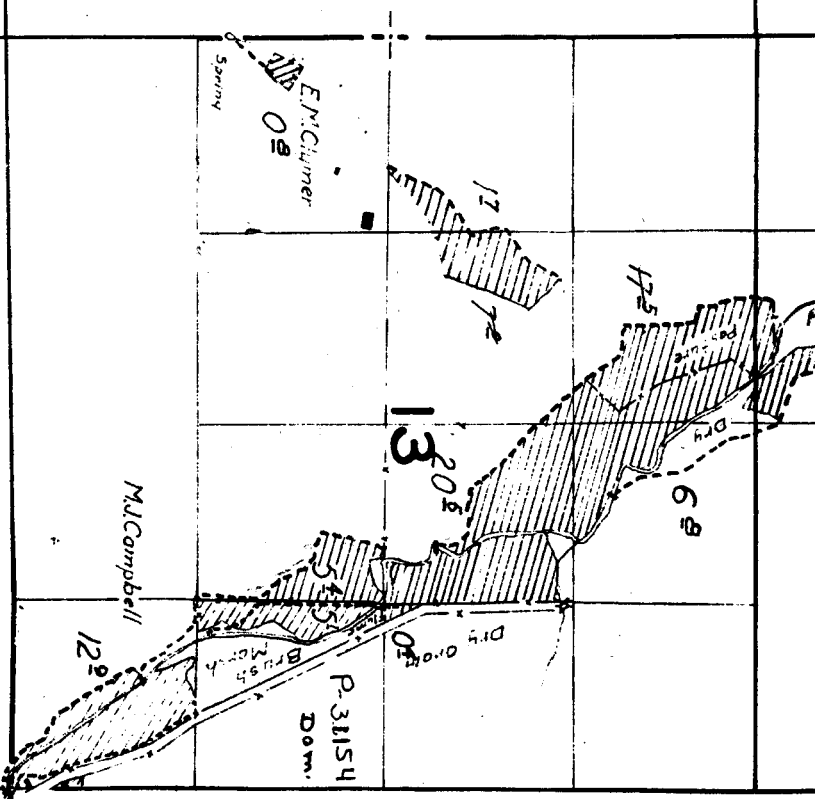

Note: Streams not in th.
irrigated lands sketched.

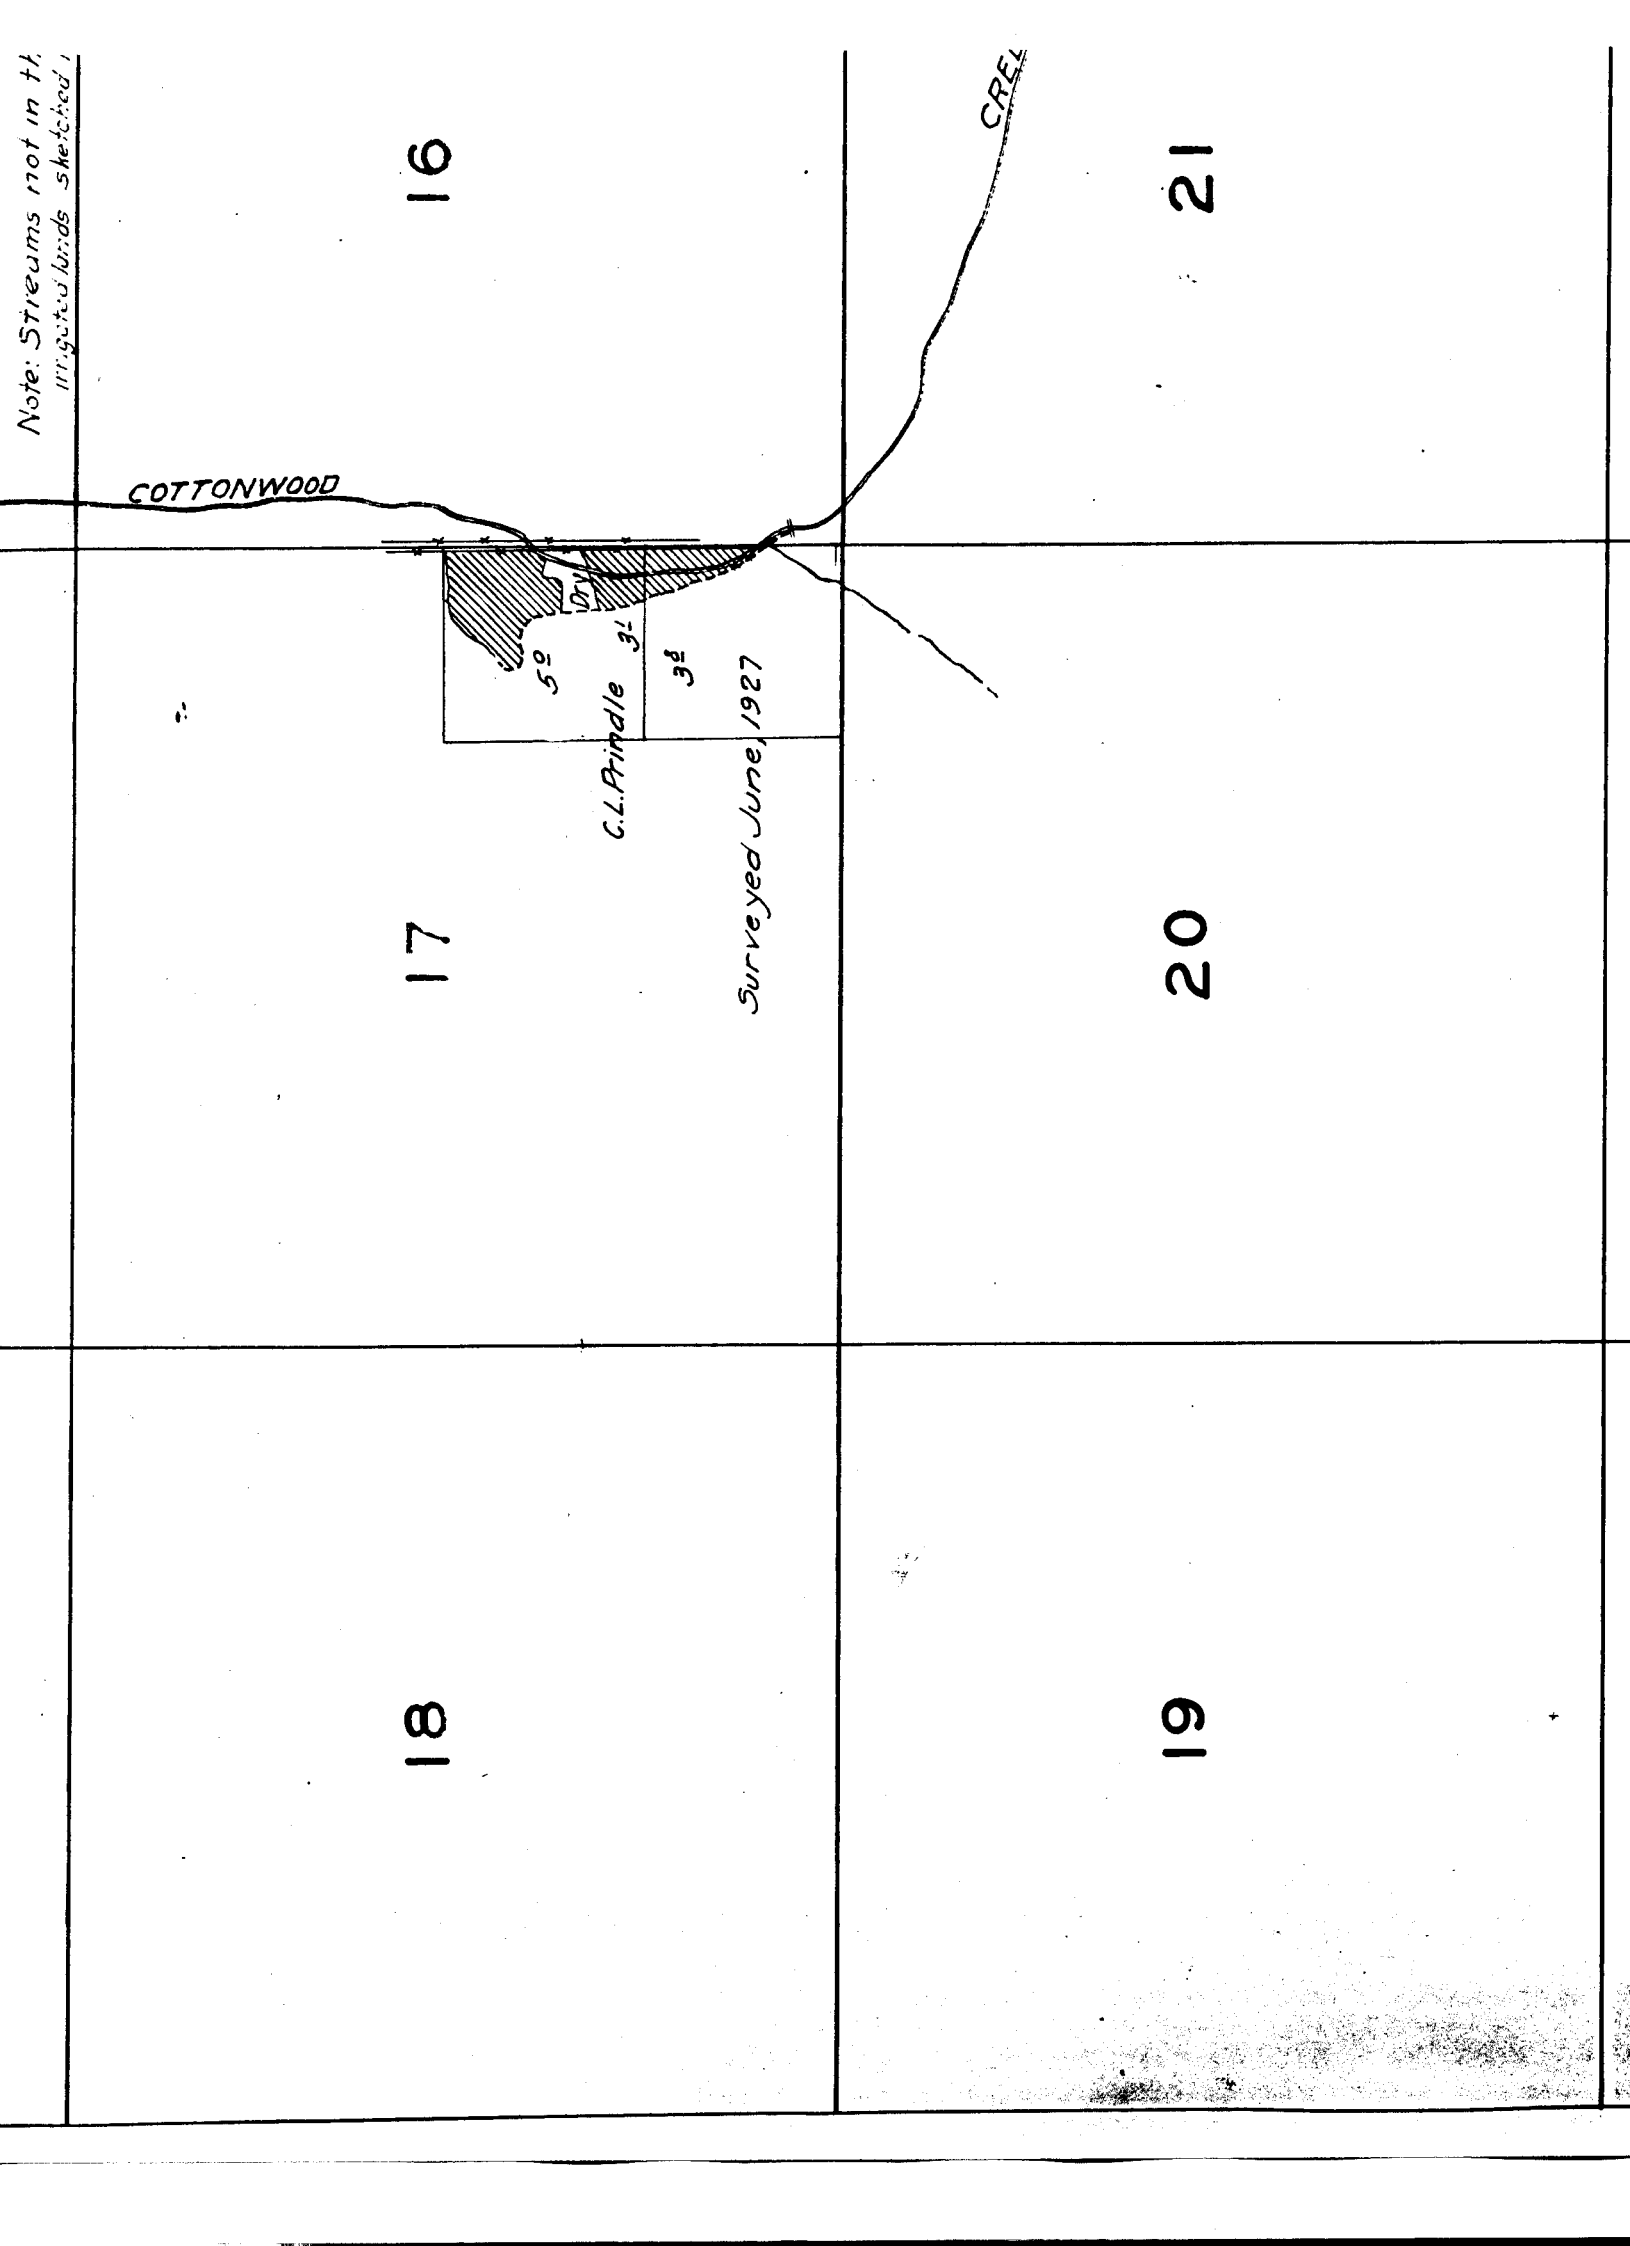

30


29


28

31

32

33

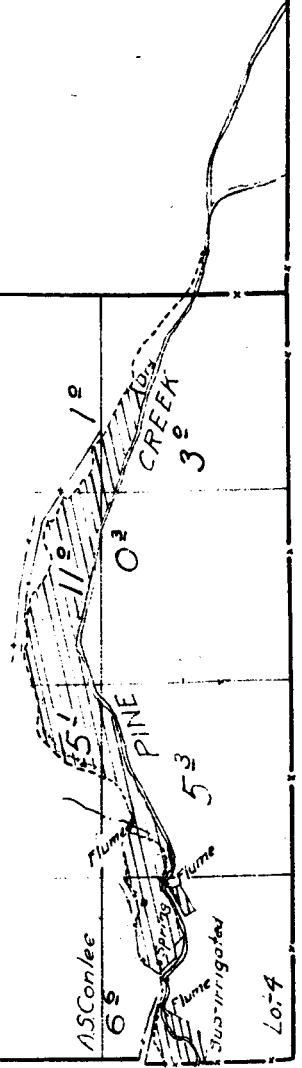

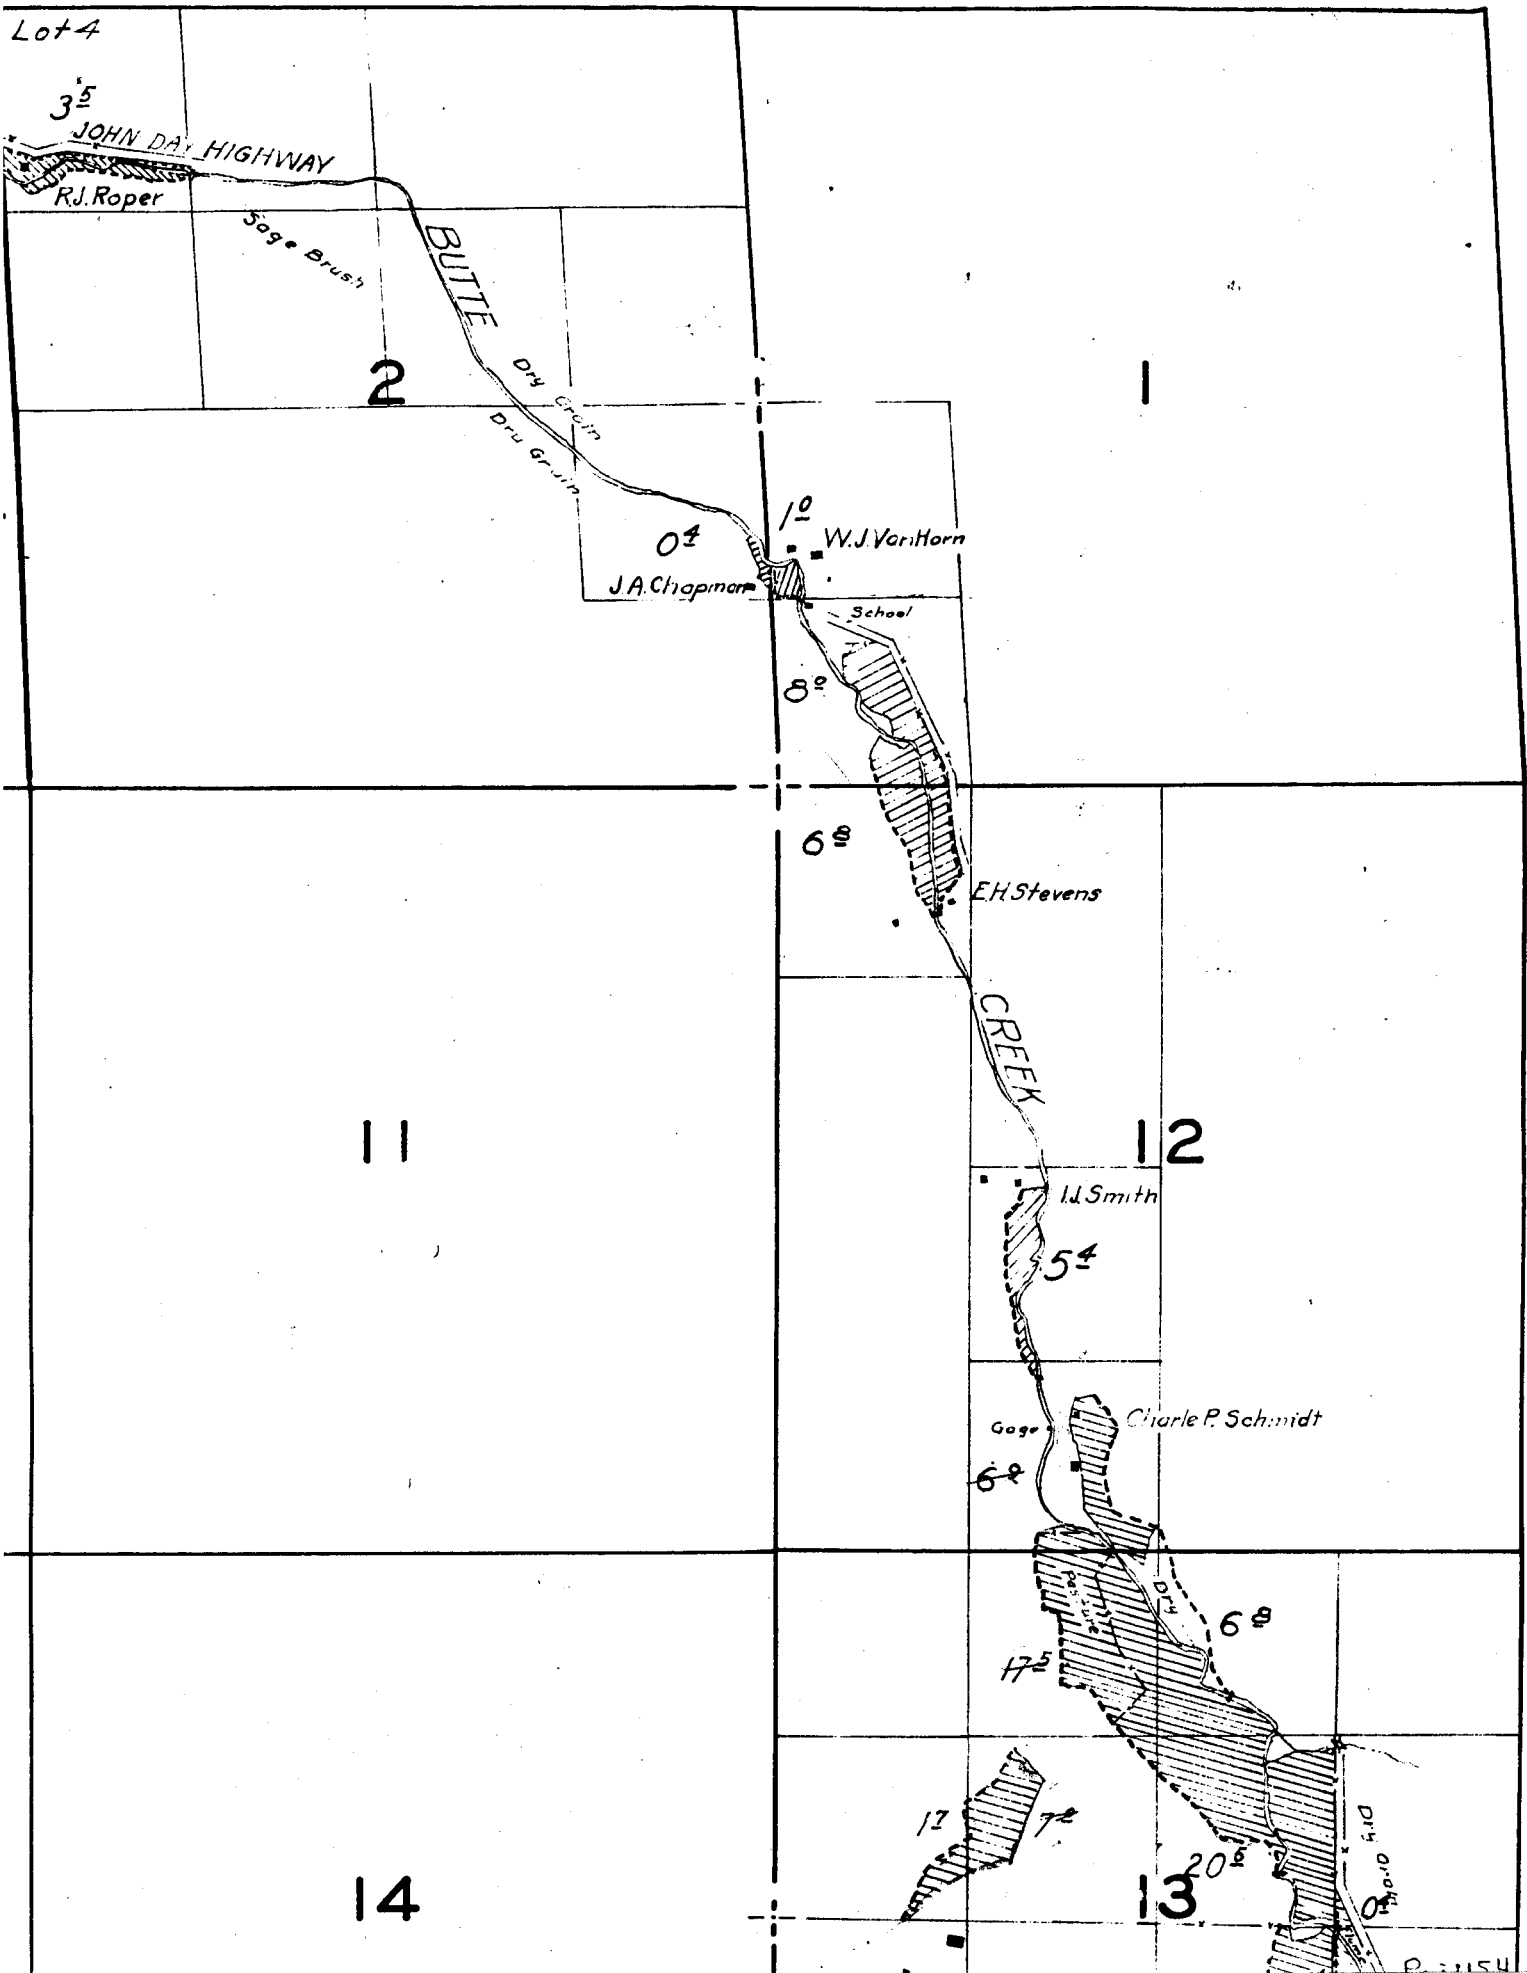

Lot 1

2^d

02

Ralph Hamilton

6

5

Lot 1

Spring

Lot 2

To Fossil

Pipe

Source of City of Fossil
Water Supply

7

8

18

17

50

21

22

2²
FWBall

*Note: Location according
to Mr. Ball.*

School

28

27

33

34

TOWNSHIP 6 S. RANGE 21 E.

4

3

9

10