

Elmer McQuinn

6

5

Lot 4.

20'

37'

CREEK

Spring

24'

Mrs Elmer McQuinn

1°

2°

32°

Lot 1.

1°

82'
ALDER

Lot 2.

04'

7

09'

Lot 3.

8

Surveyed October 16, 1925.

Lot 4.

13°

4°

18

17

TOWNSHIP 8 S. RANGE 24 E.

	4	3	Surveyed.
1925.	9	10	

				50
			15	
			16	
			21	
			22	


15

14

13

22

23

24

A.S. Borges

Amos Haws

4⁺

15^g

2^o


2⁺

5^g

22

52

28

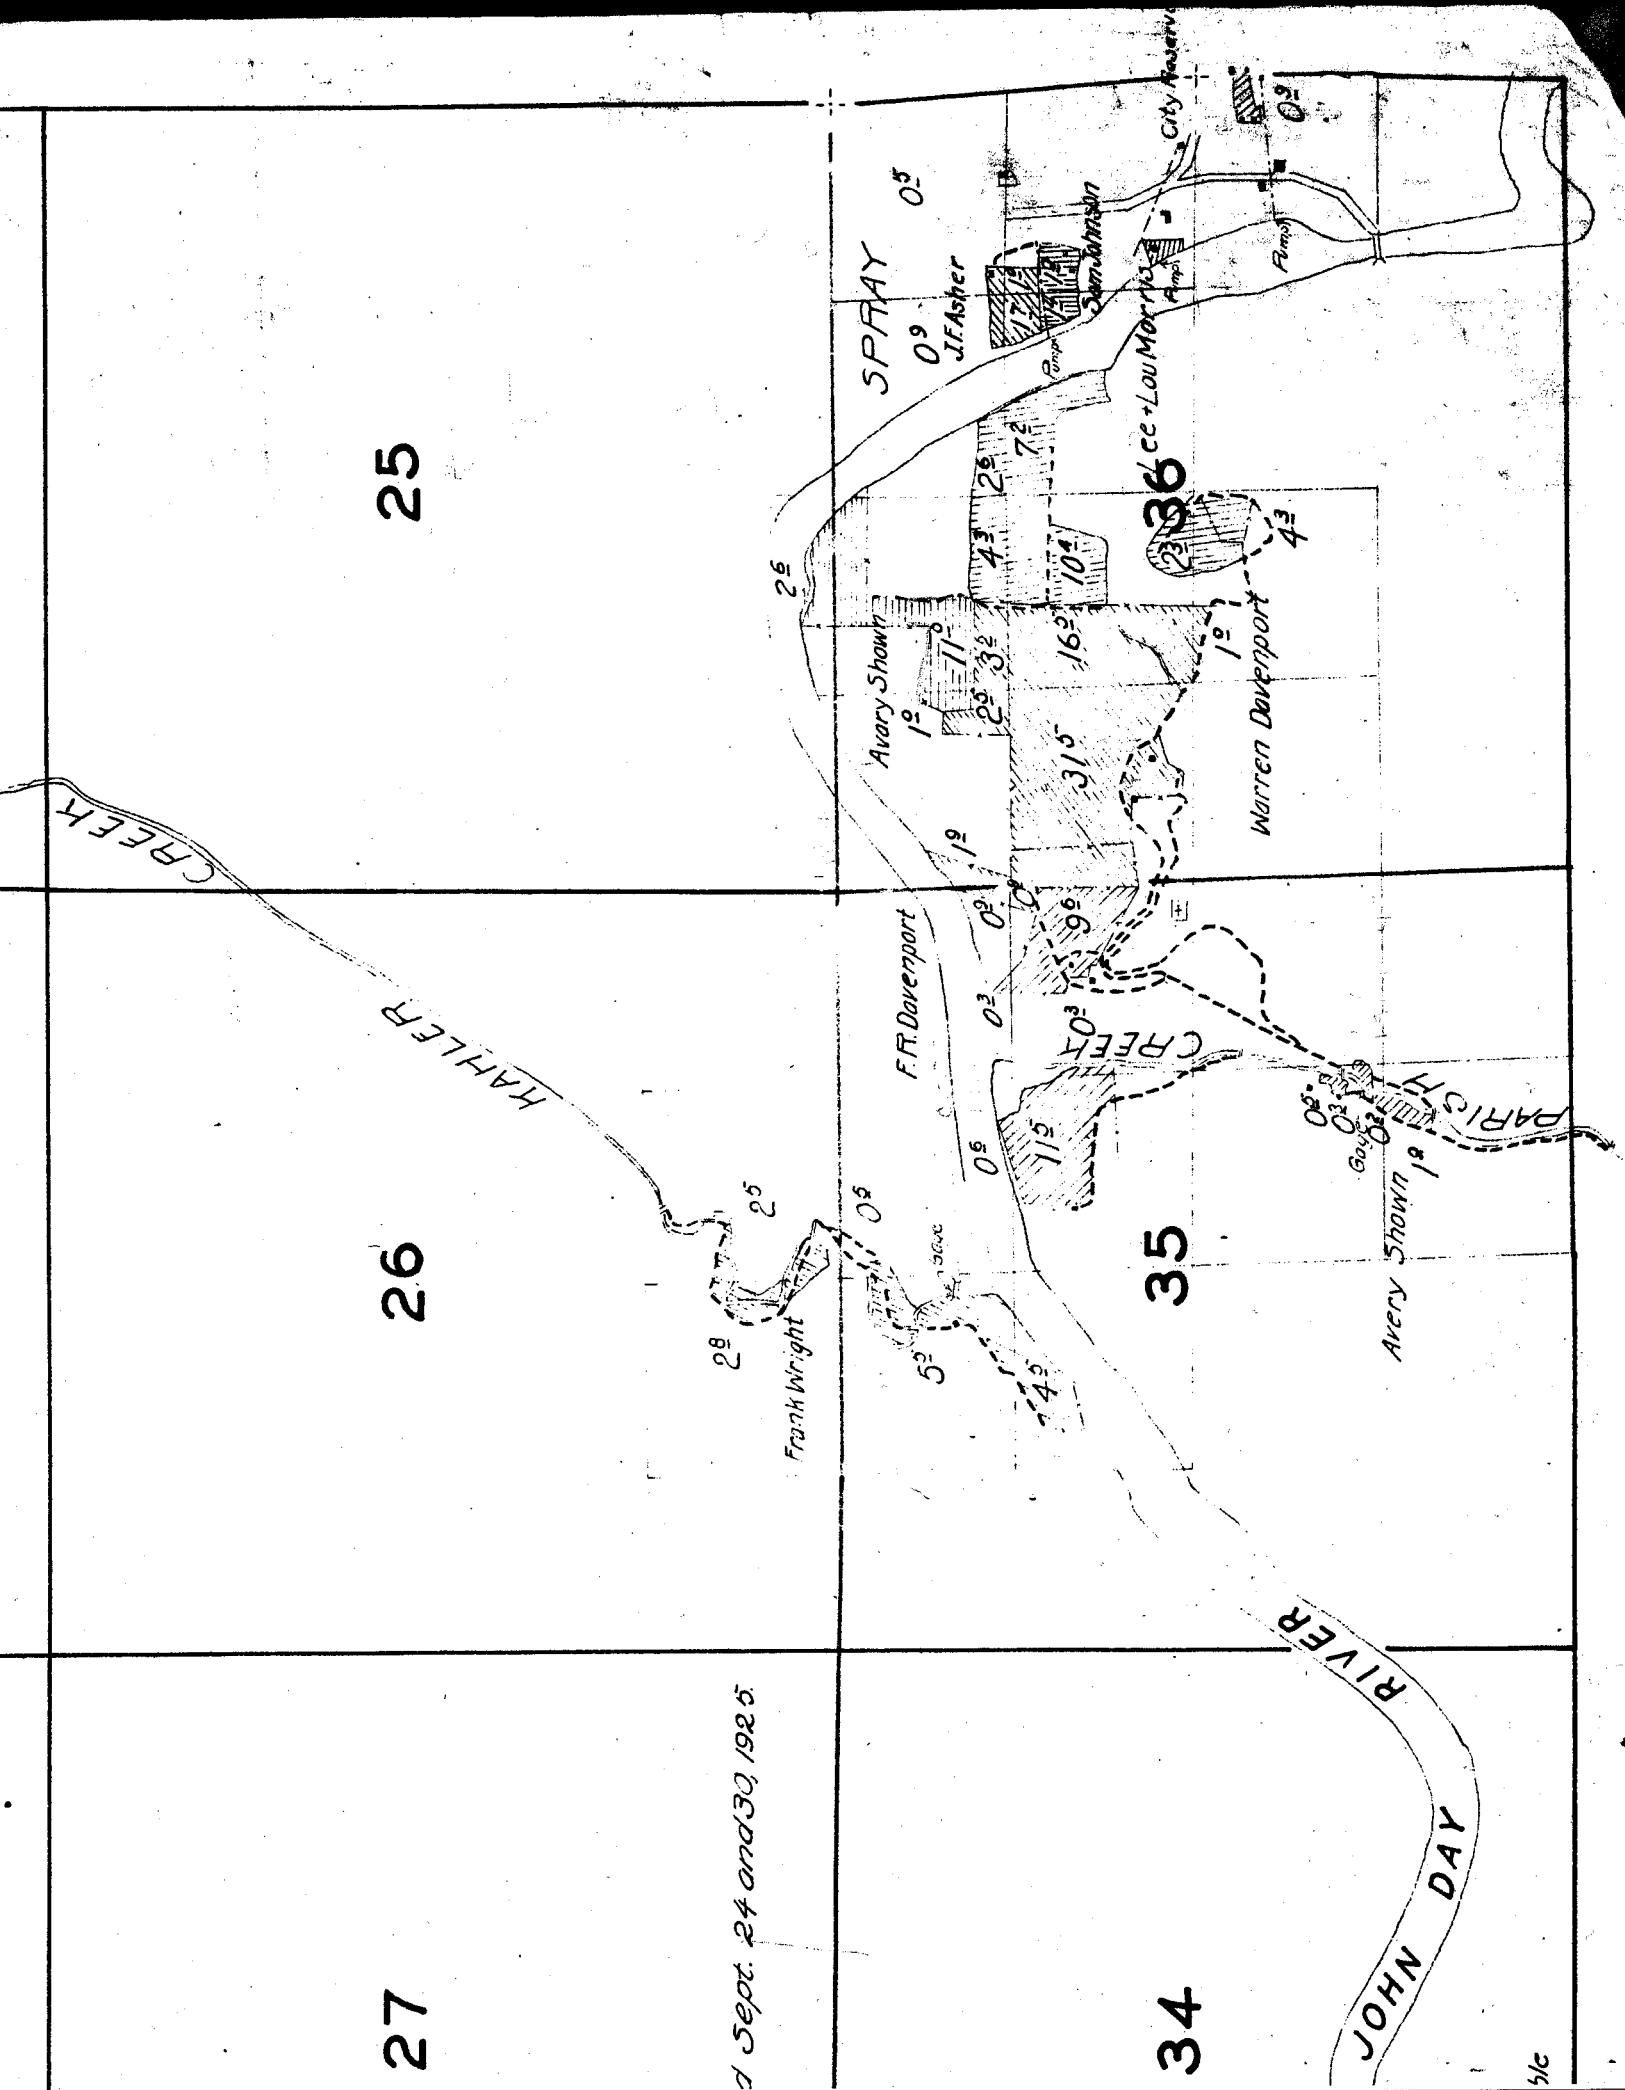

21

22

28

27

Surveyed Sept. 24 and 30, 1925.

33

34

Baughn


0^3

6^2

pump

Snoble

JOHN DAY RIVER

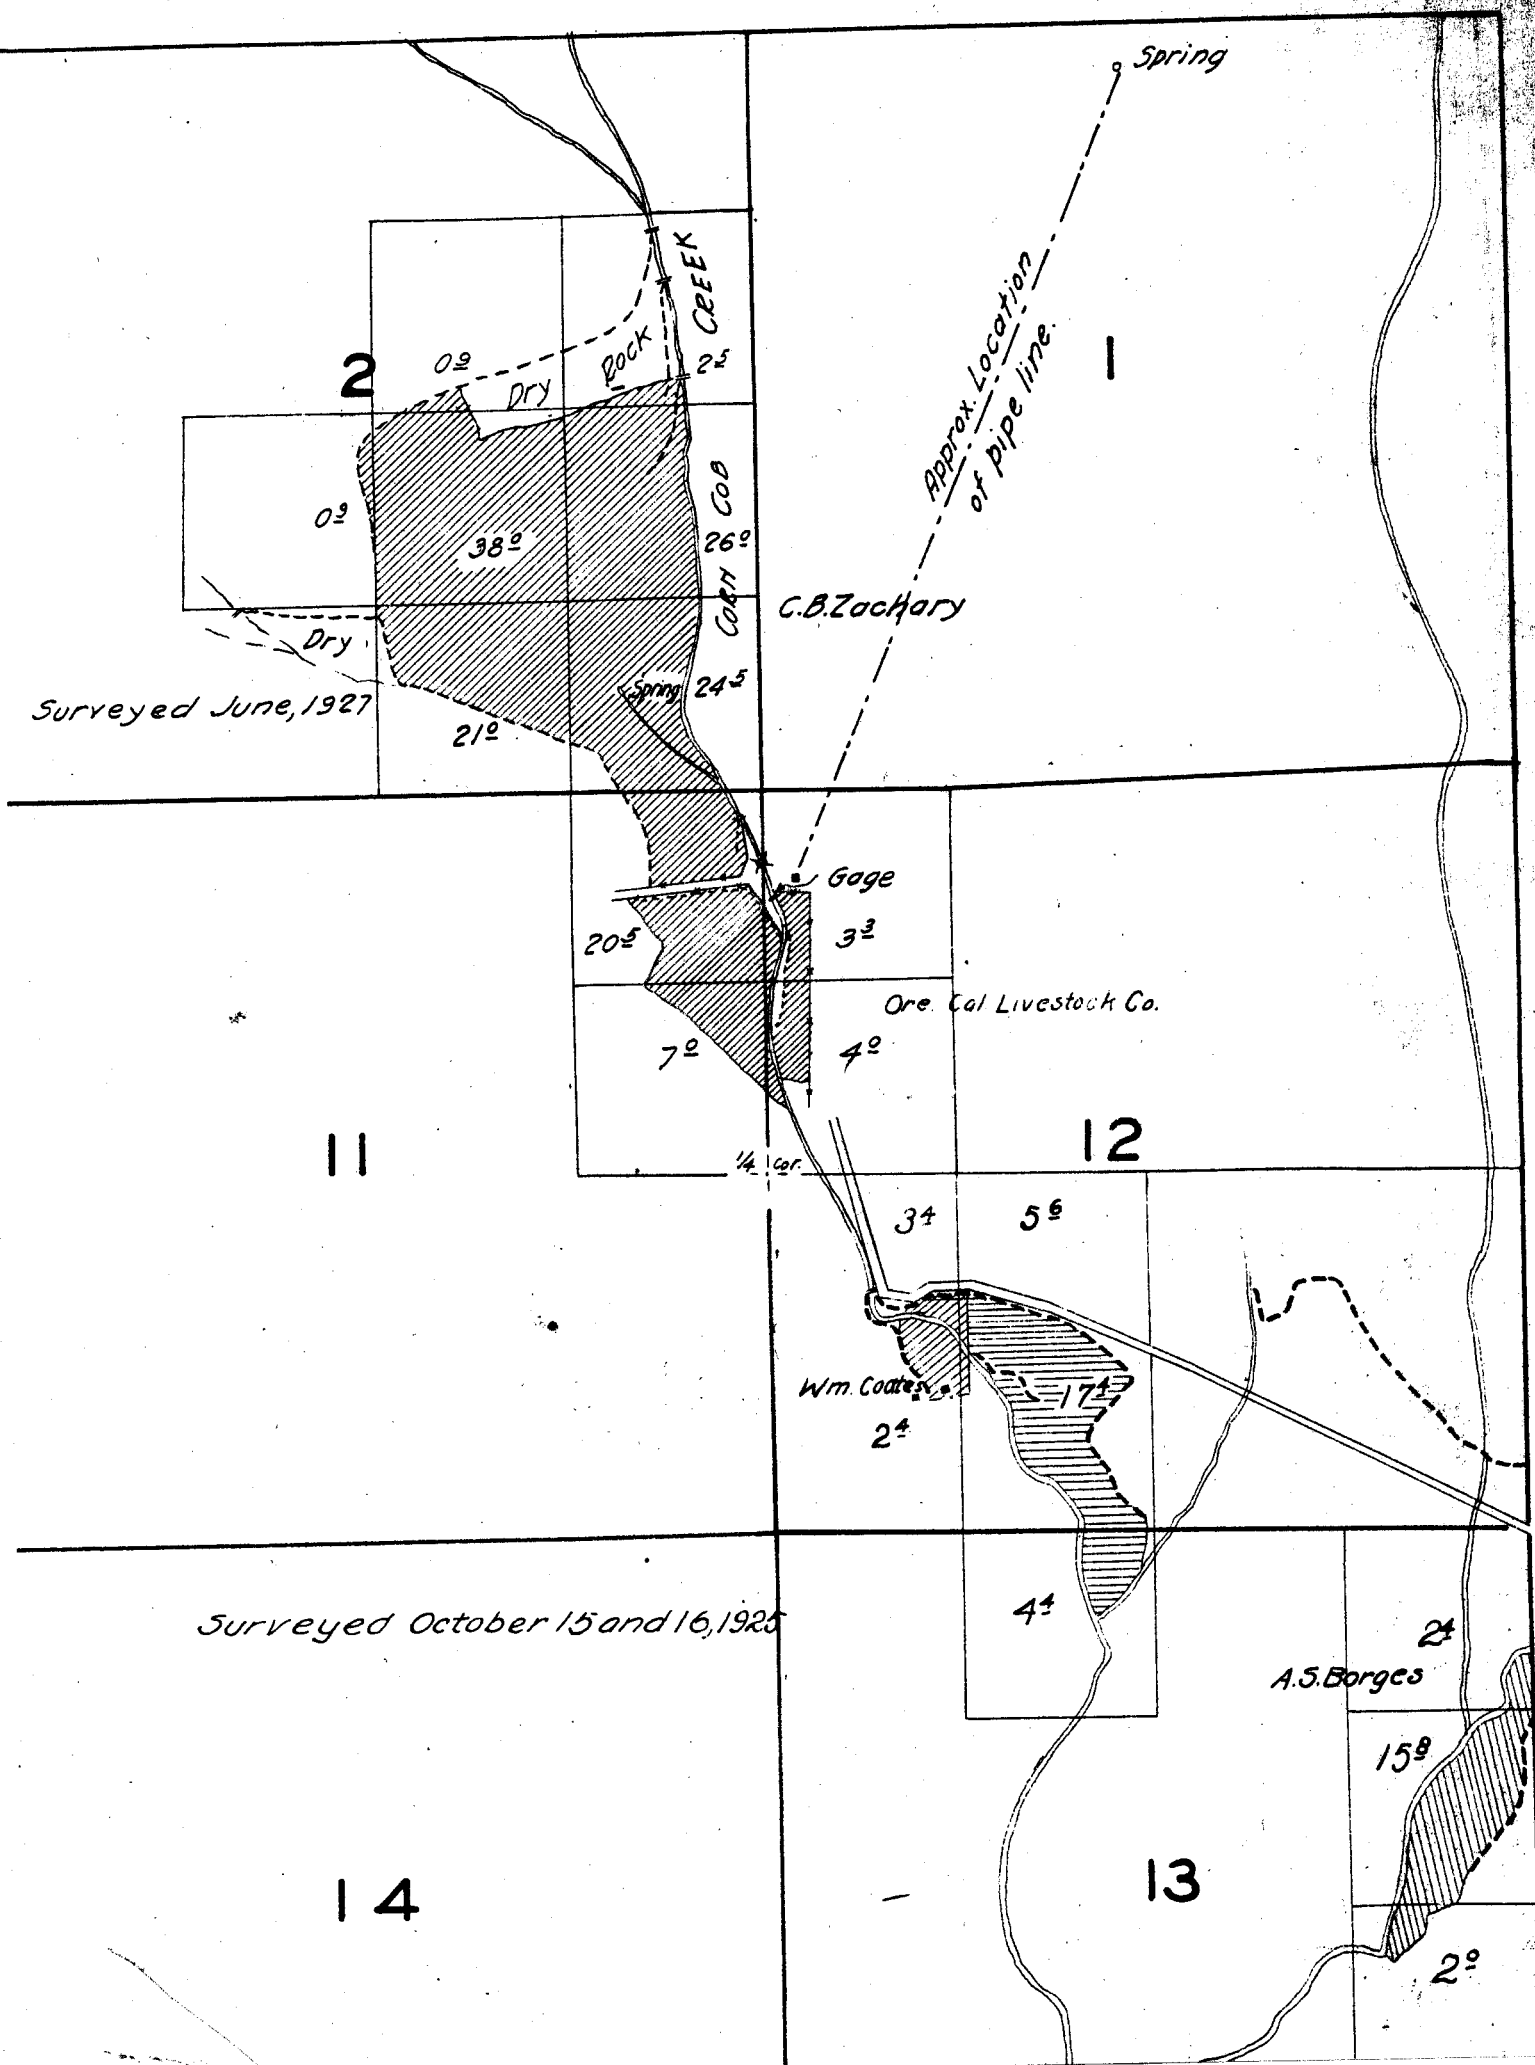

Note: Streams and Rivers except in the vicinity of irrigated land, sketched in approximate location.

30

29

28

MATHIS
31

32

33

Surveyed Oct 29, 1925

0-1
Nixon
Mrs Mary Adams

Spring

Bough.

18

17

16

19

20

21