


T.17S.R.6 & 7W.W.M.

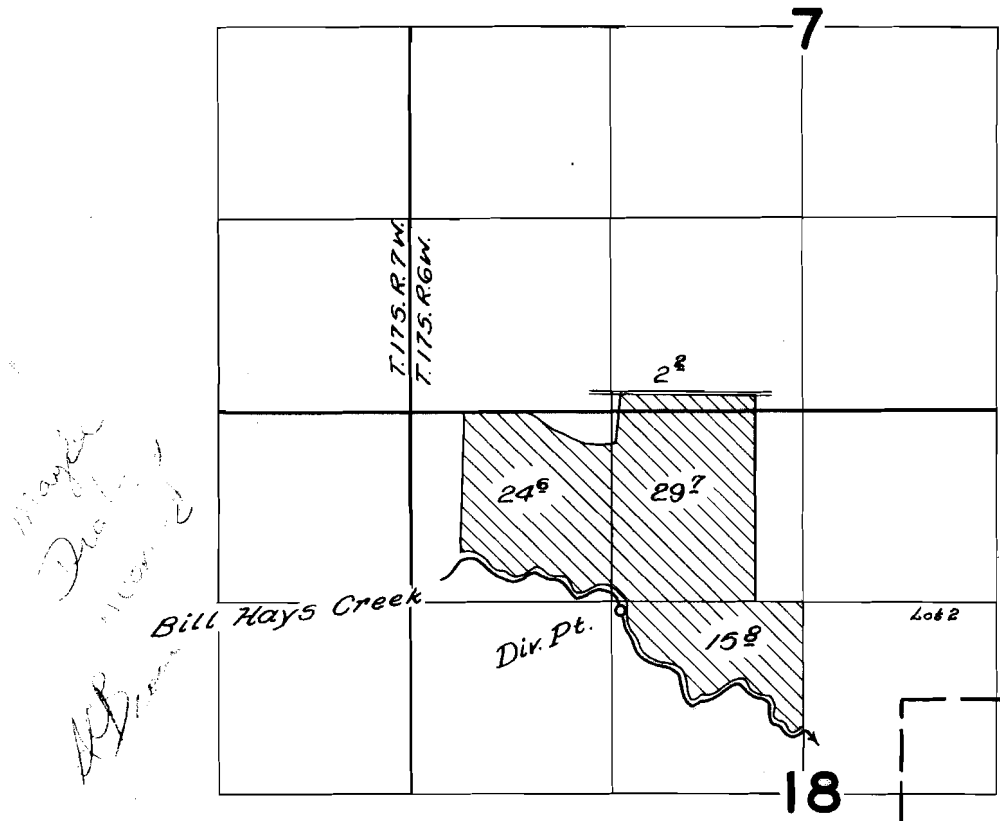

FINAL PROOF SURVEY

UNDER

Application No. 18894 Permit No. 14509

IN NAME OF

J. P. Allison

Surveyed May 2 1957, by R. H. Whitby