


T.4S.R.6W.W.M.

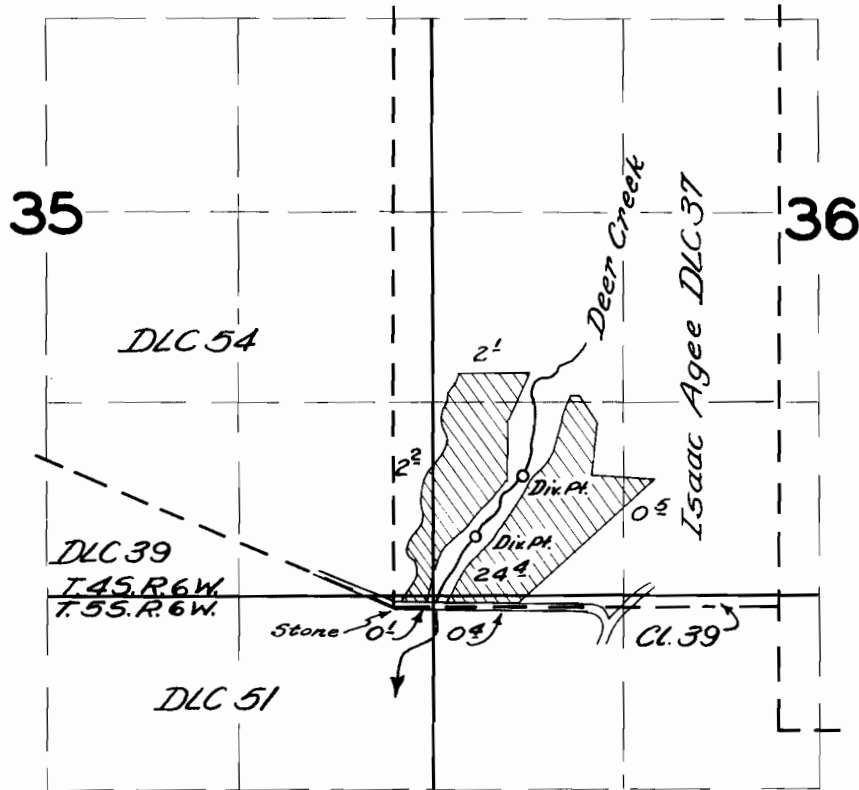

FINAL PROOF SURVEY UNDER

Application No. 23447 Permit No. 18505
IN NAME OF

Wm. & Mabel J. Vanderwood

Surveyed June 2, 1958, by *M. Bisk*