


T.41 S.R.13 W.W.M.

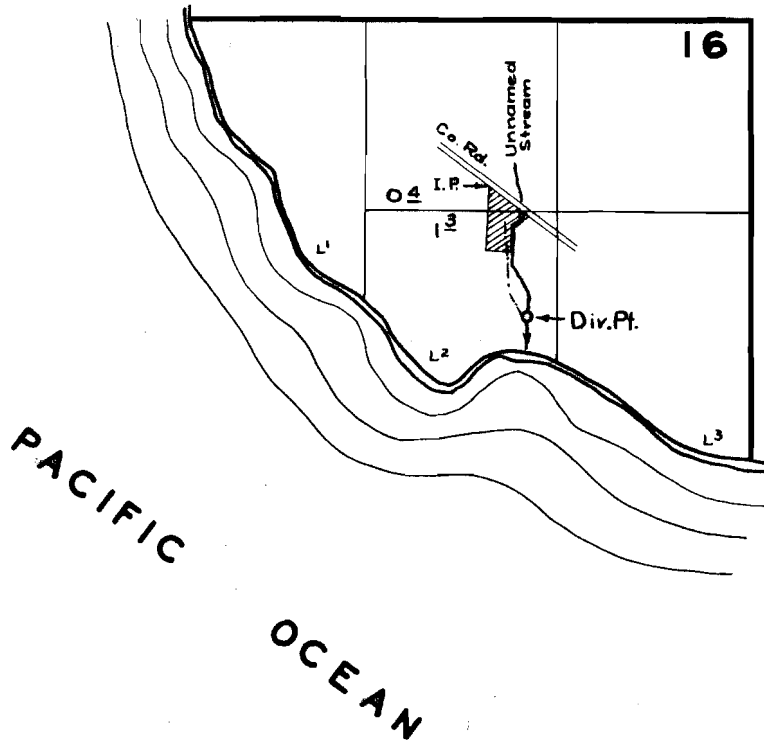

FINAL PROOF SURVEY
UNDER

Application No. 24167 Permit No. 19081
IN NAME OF

Joe Zumpfe

Surveyed Mar. 21, 1958, by M. Bish