


T.9S. R.6 W.W.M.

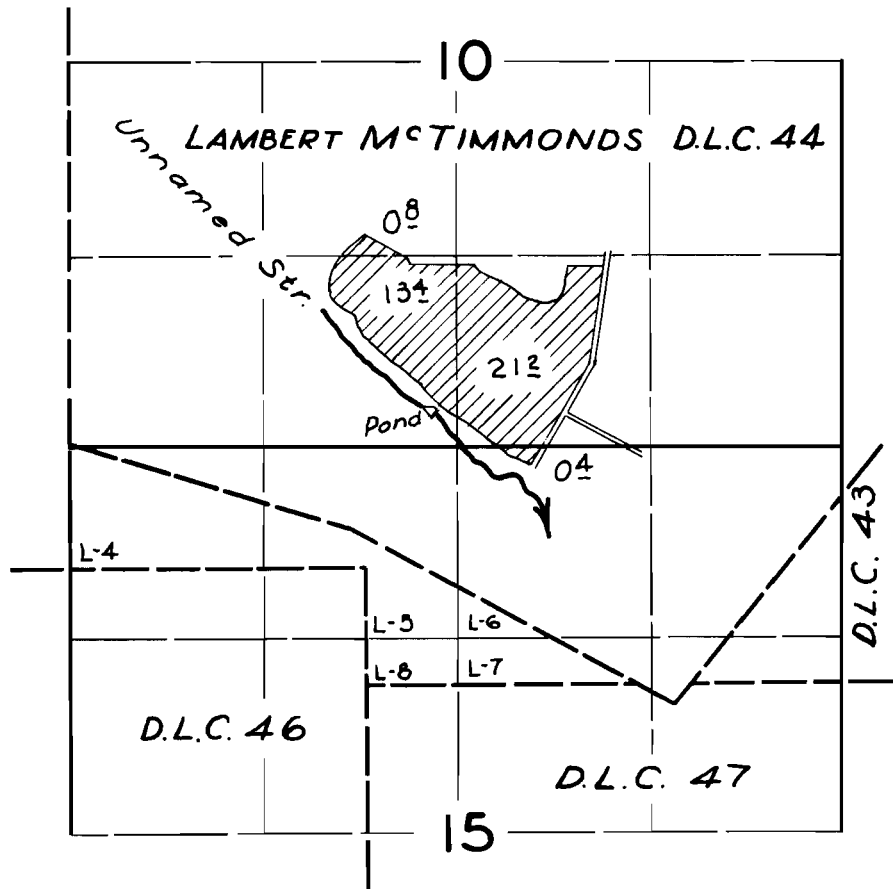

**FINAL PROOF SURVEY**  
UNDER

Application No. 23553 Permit No. 19430  
IN NAME OF

**CLYDE C. BACKSON**

Surveyed May 14 1958, by R.H. Whitby