


T.4 S.R.3 W.W.M.

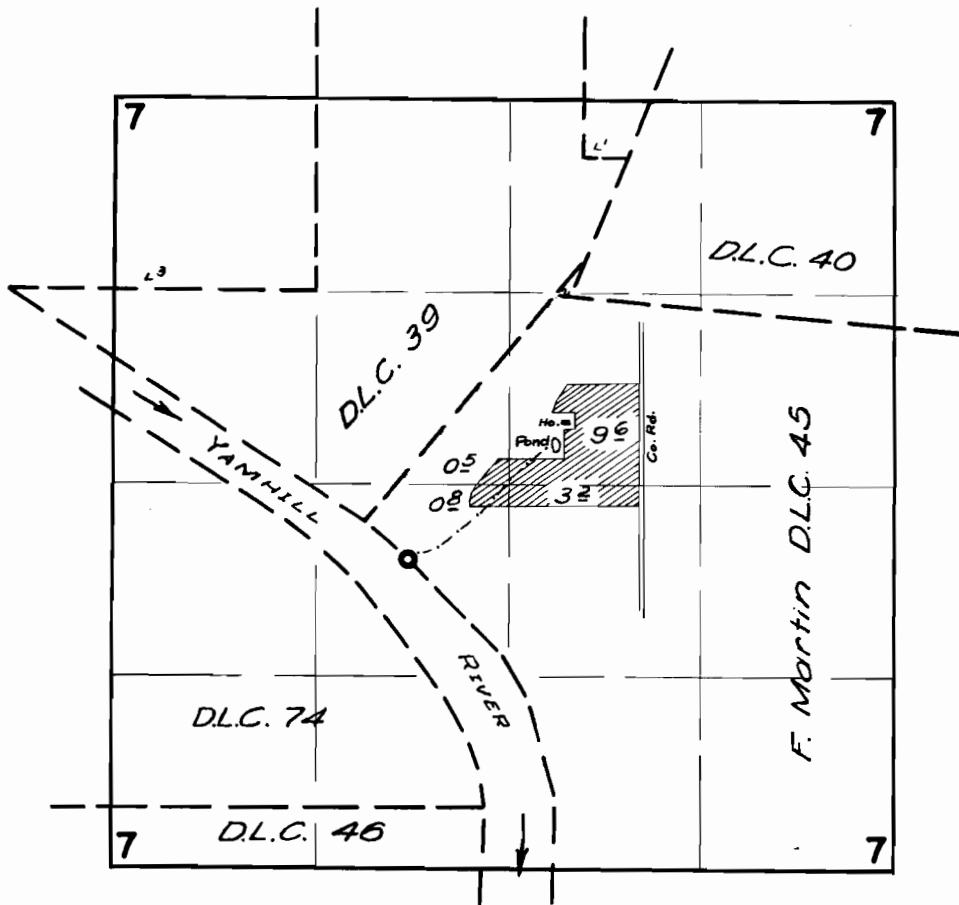

FINAL PROOF SURVEY UNDER

Application No. 25746 Permit No. 21308
IN NAME OF

BEN B. BUNN

Surveyed 29 April 1958, by M. Bish