


T. 36 S., R. 2 W., W.M.

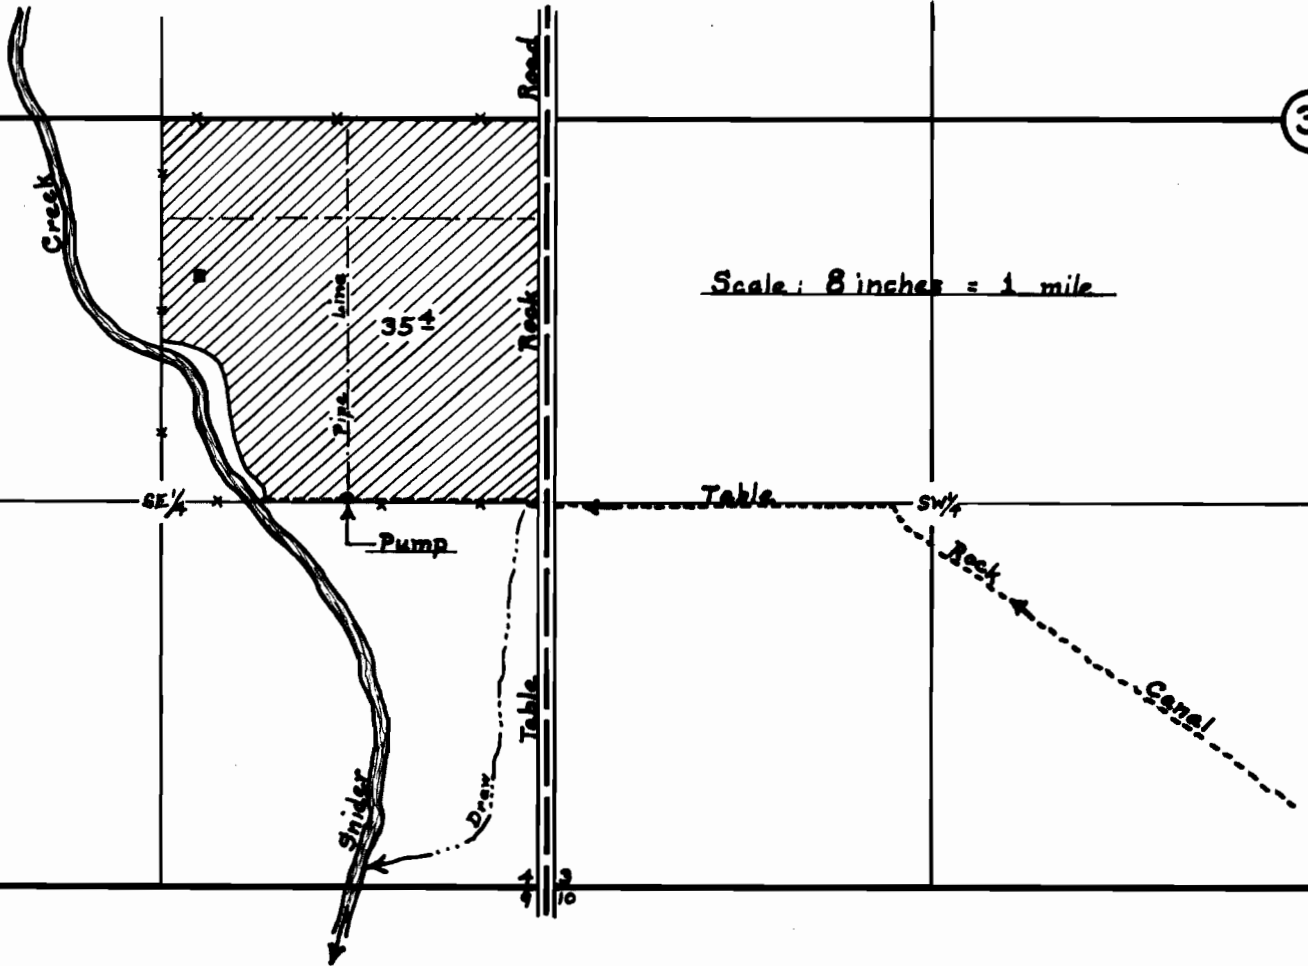

# FINAL PROOF SURVEY

UNDER

Application No. 27158 Permit No. 21359

IN NAME OF

Earl Peffley

Surveyed 3-12, 1959, by D.C. Hendrix, W.M.