


# T.5 S. R.7 W.W.M.

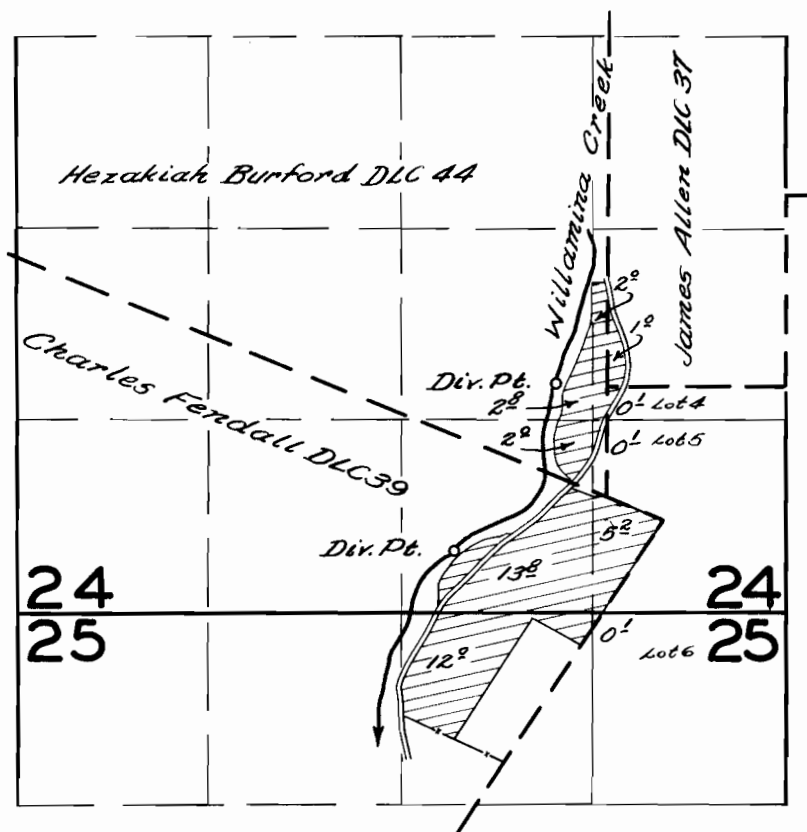

## FINAL PROOF SURVEY UNDER

Application No. 27223 Permit No. 21419  
IN NAME OF

*Roy O. Dent*

Surveyed June 2, 1958, by *M. Bisk*