


T.6S. R.6 W.W.M.

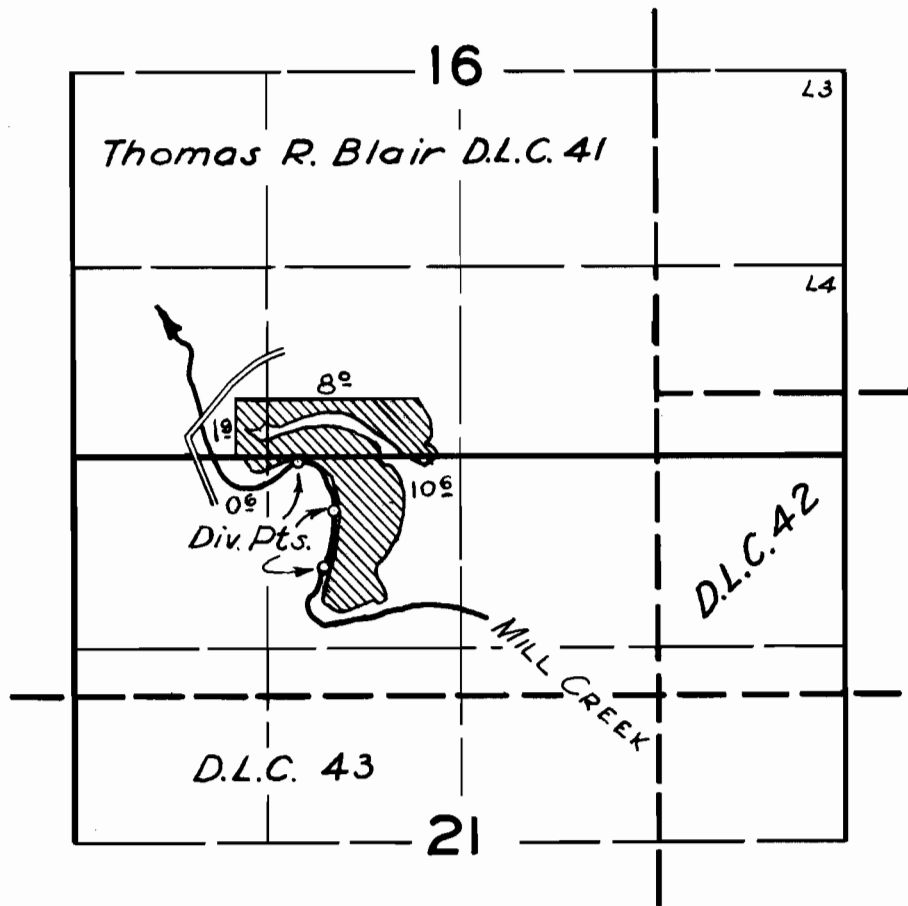

FINAL PROOF SURVEY
UNDER

Application No. 27904 Permit No. 21978
IN NAME OF

C. O. DUNCAN

Surveyed April 8, 1958, by R.H. Whitby