


T.17S.R.6W.W.M.

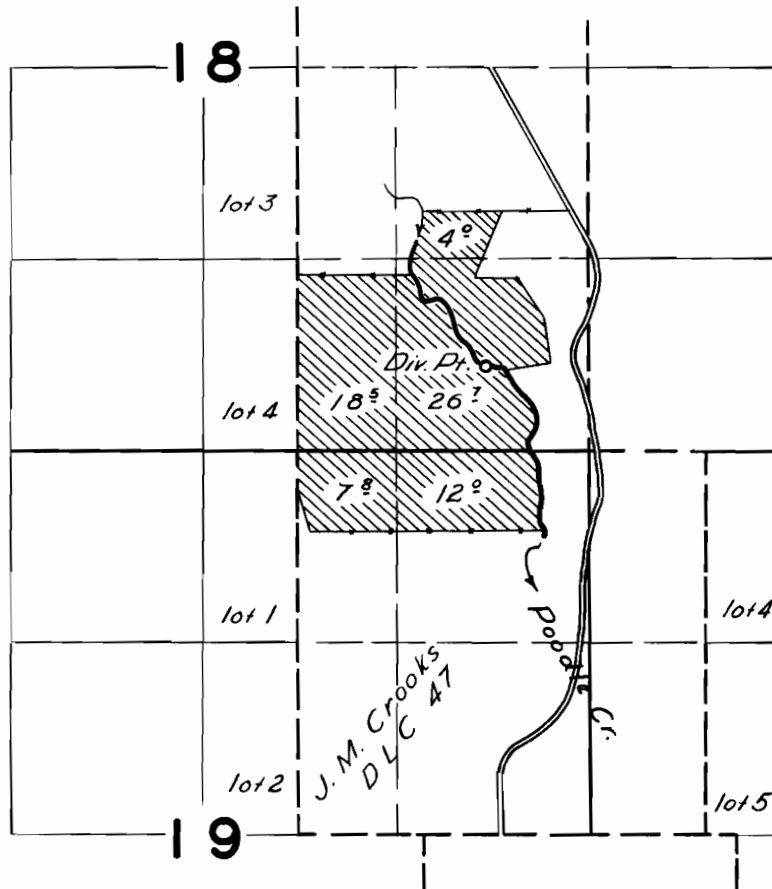

FINAL PROOF SURVEY
UNDER

Application No. 28251 Permit No. 22445
IN NAME OF

MARCUS D. MCKEE

Surveyed 2 May 1957, by W. H. Hilly