


23740
26045

T. 32-33S. R. 7 $\frac{1}{2}$ E.W.M.

Anna Creek & Pond

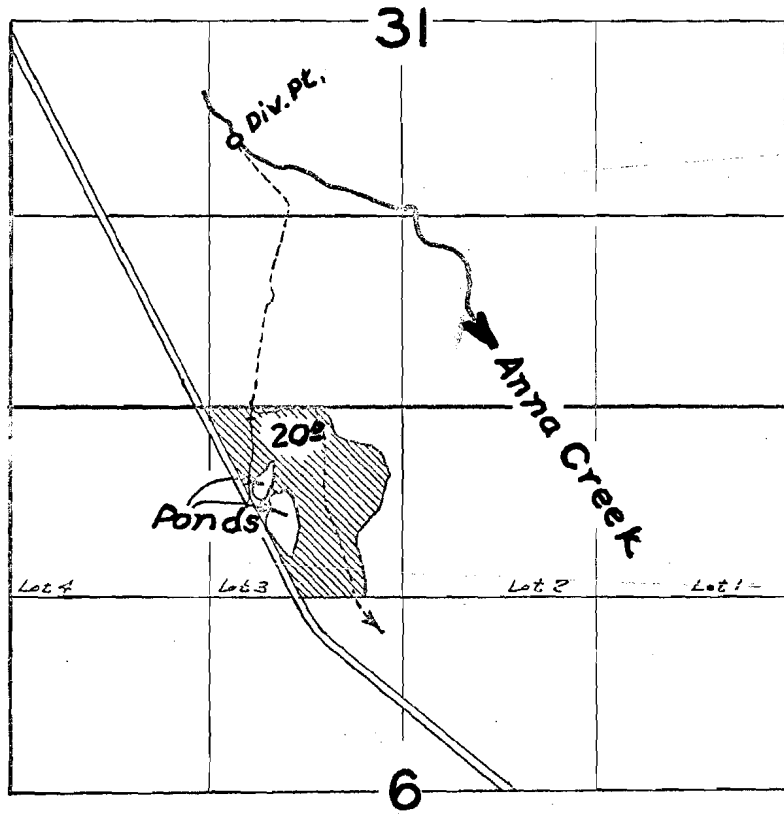

FINAL PROOF SURVEY
UNDER

Application No. 22220... Permit No. 23740
IN NAME OF

HARRY C. & HARRY W. SMITH

Surveyed 2 May 1958, by C.O. Bartels