


T. 4 S. R. 3 W. W. M.

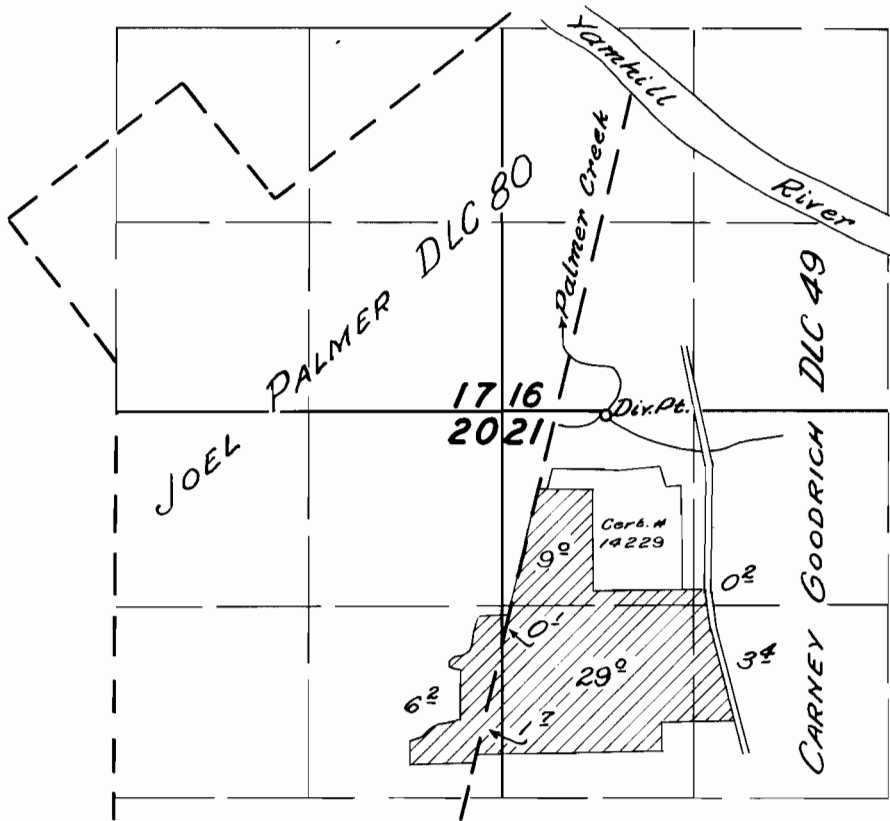

FINAL PROOF SURVEY
UNDER

Application No. 32128 Permit No. 25346
IN NAME OF

RUSSELL COBURN

Surveyed JUNE 3, 1958, by M. BISH