


T.1N.R.4 W.W.M.

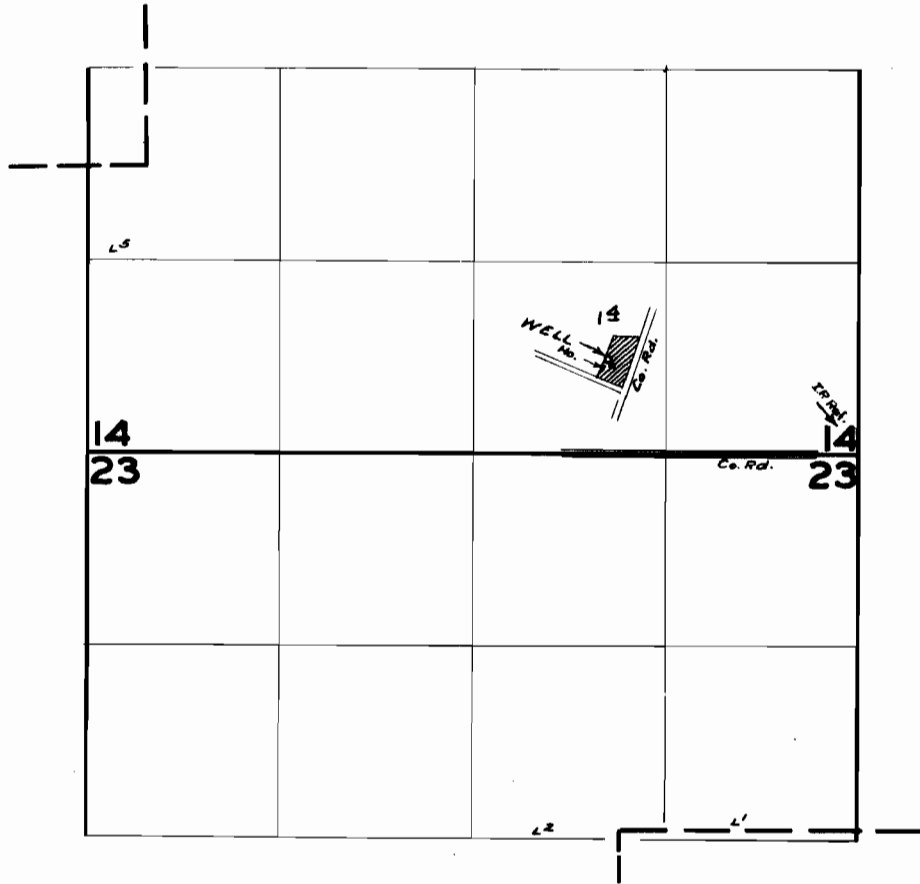

FINAL PROOF SURVEY UNDER

Application No. G-818 Permit No. G-740
IN NAME OF

WAYNE J. WILLIAMS

Surveyed 3 July 1958, by M. Bish