


T.16S.R.5W.W.M.

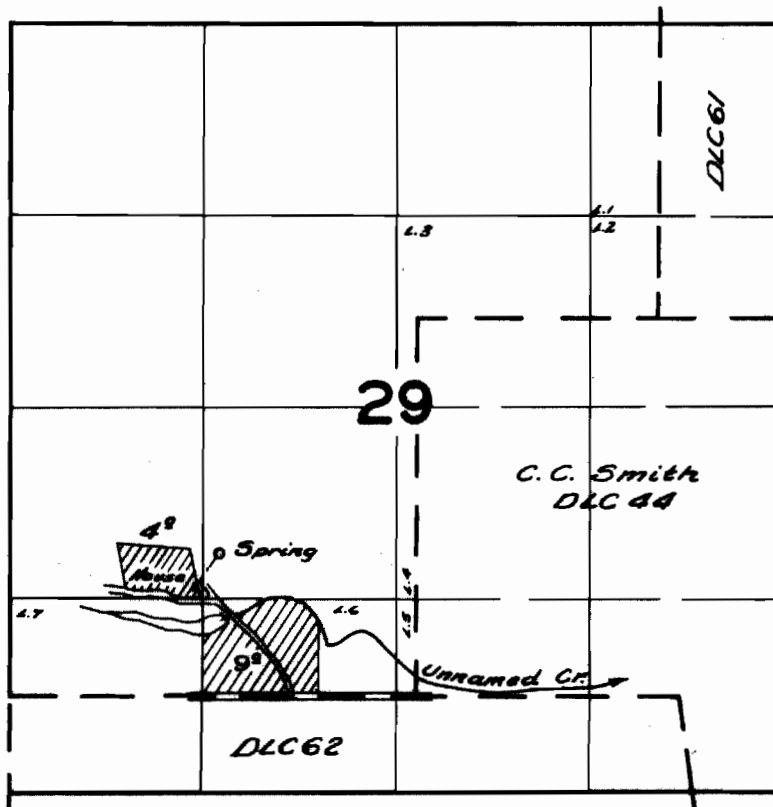

FINAL PROOF SURVEY
UNDER

Application No. ^{R-24763}~~24762~~ Permit No. ^{R-1088}~~19928~~
IN NAME OF

Calvin C. Thayer

Surveyed April 10, 1957, by R. H. Whitty