


T.5 S.R.1 W.W.M.

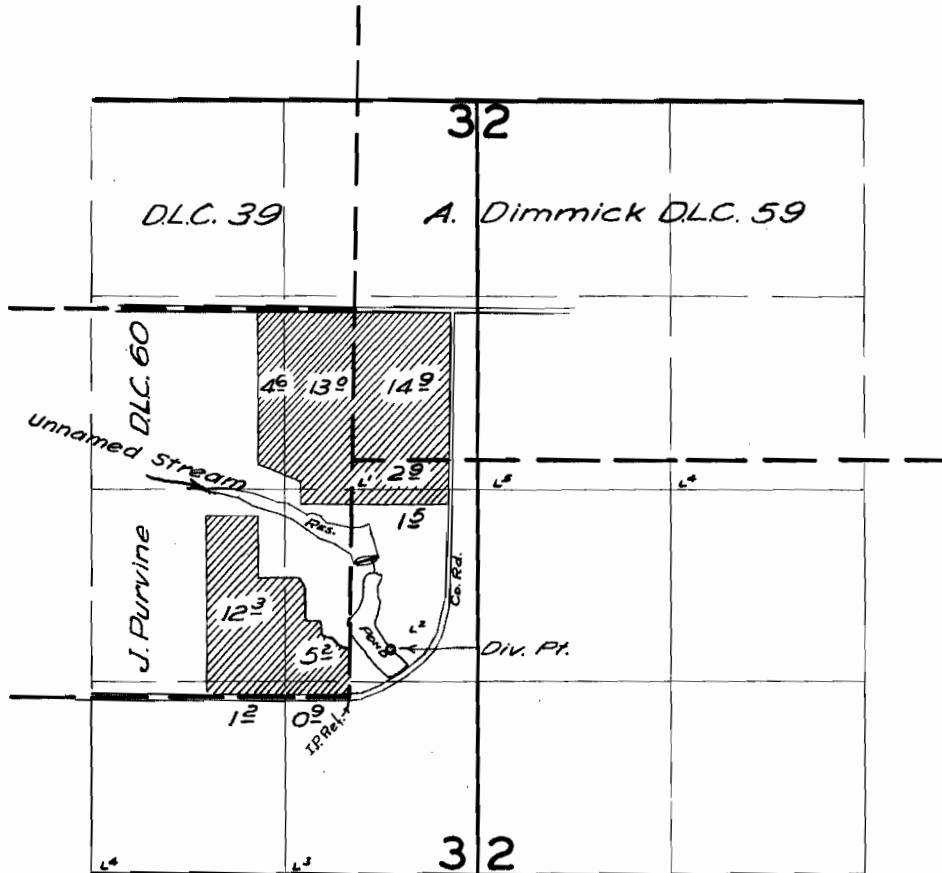

FINAL PROOF SURVEY UNDER

R-25382 R-1584
 Application No. 25383 Permit No. 22728
 IN NAME OF

MANTON A. CARL

Surveyed 25 June 1958, by M. Bish