


T. 35 S., R. 2 W., W.M.

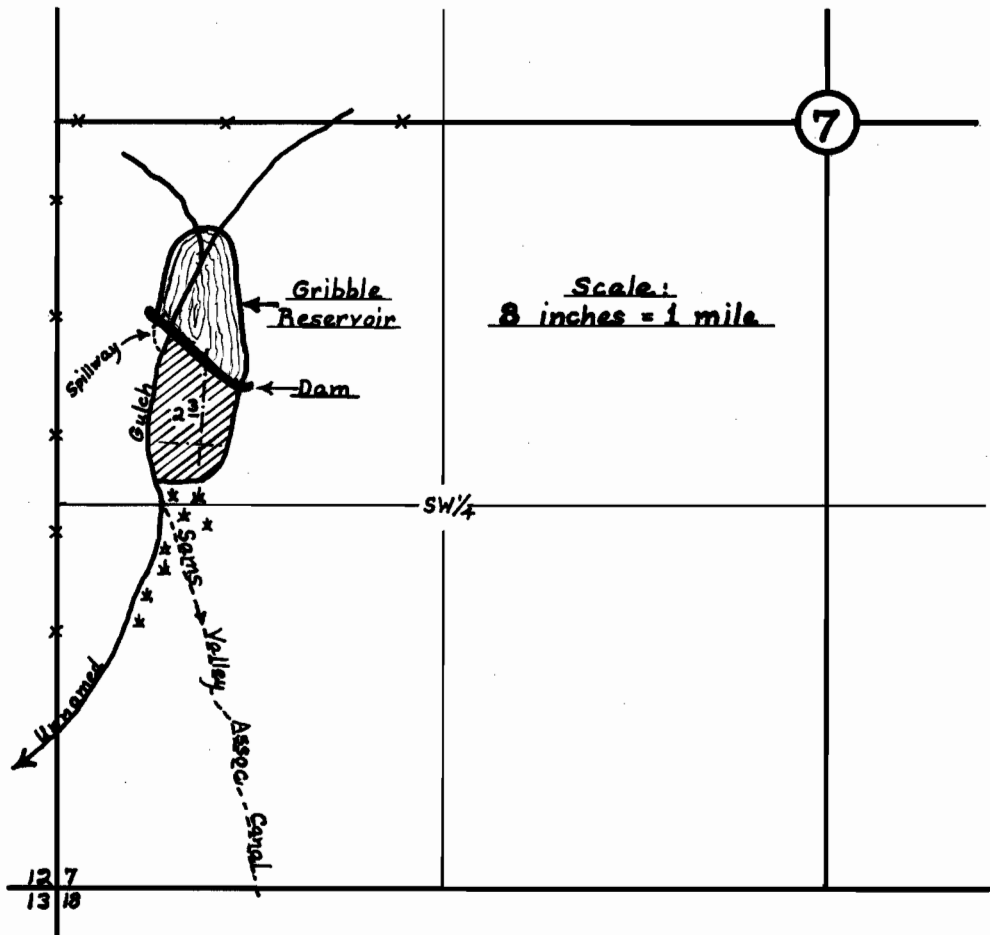

FINAL PROOF SURVEY

UNDER

Application No. R-26605 26529 Permit No. R-1274 20791
IN NAME OF

Earl Paffley & Frank Straus

Surveyed 3-11, 1959, by D.C. Hendrix, W.M.