


T.4S.R.5W.W.M.

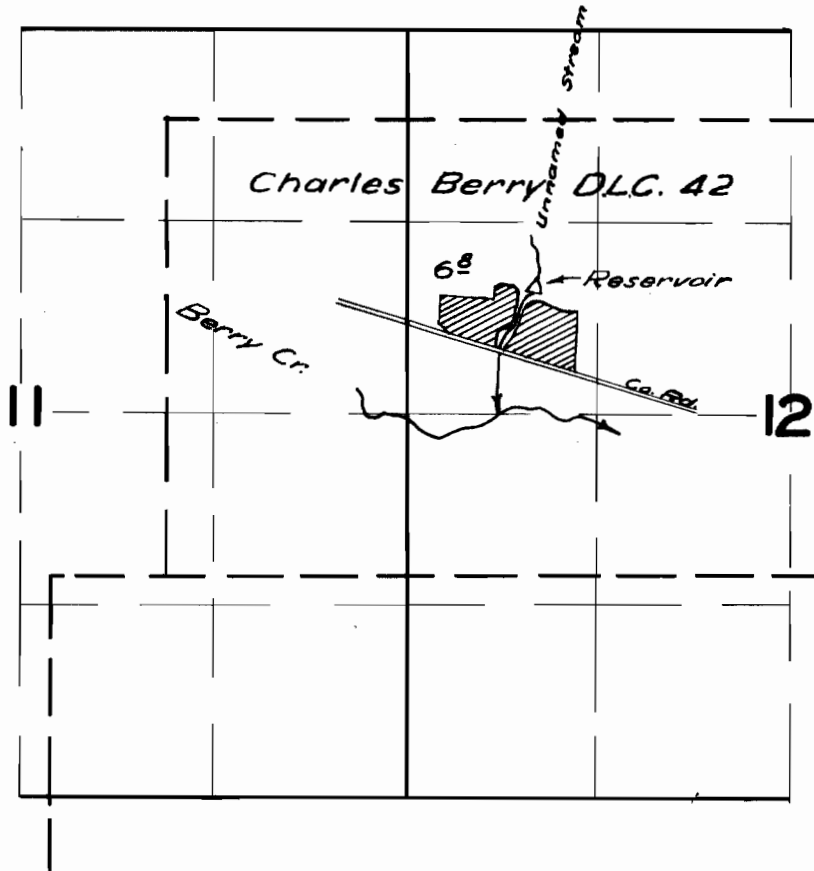

**FINAL PROOF SURVEY**  
UNDER

Application No. 28285. Permit No. 22240  
IN NAME OF

*CARTER & HELEN KVAVLE*

Surveyed *1 May* 1959, by *M. B. Bish*