
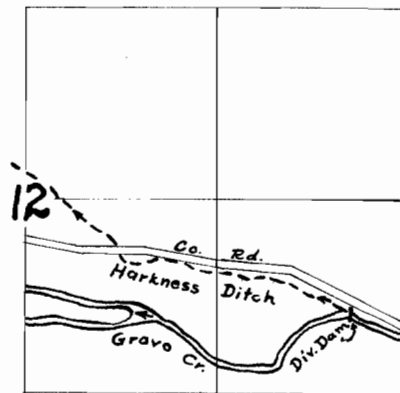


T. 34 S. R. 6 W. W.M.

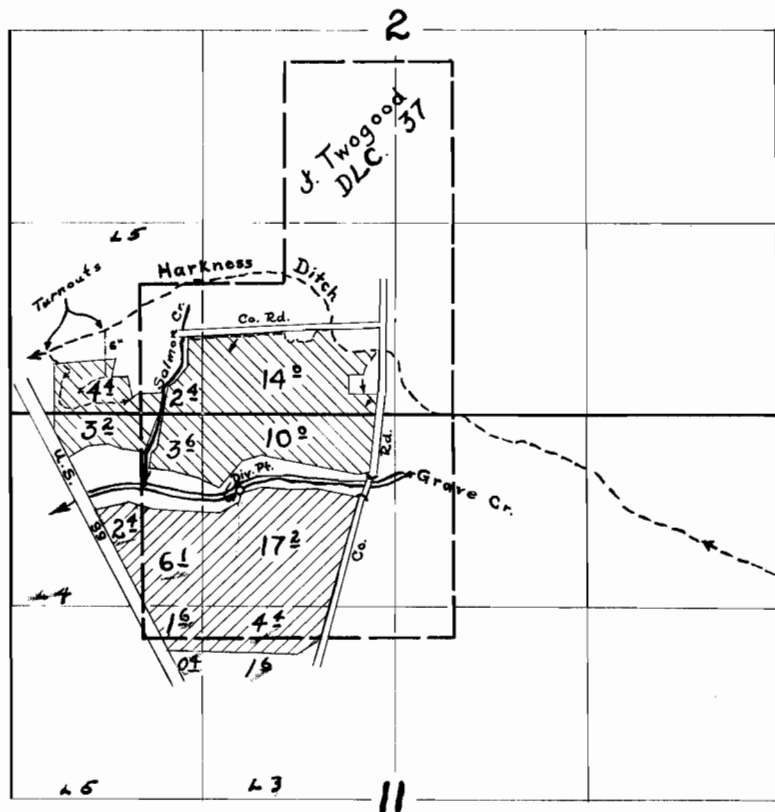

FINAL PROOF SURVEY
UNDER

Application No. 29623 Permit No. 23335
Application No. 29625 Permit No. 23337

IN NAME OF
Genevieve Price
Frank E. Price

Surveyed 19 May 1959, by C. O. Bartels.