


T. 7 S. R. 3 E. 4 W. W.M.

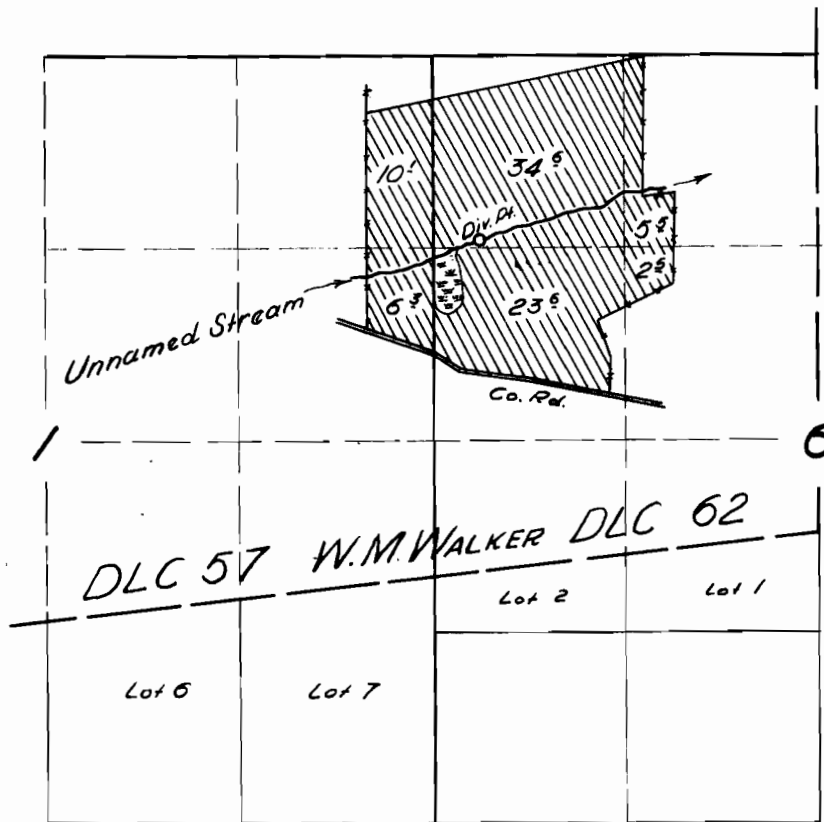

**FINAL PROOF SURVEY**

UNDER

Application No. 24947 Permit No. 19692

IN NAME OF

**K. W. NOTEBOOM**

Surveyed 13 Mar. 1957, by [Signature]