


# T. 1 N. R. 27 E. W. M.

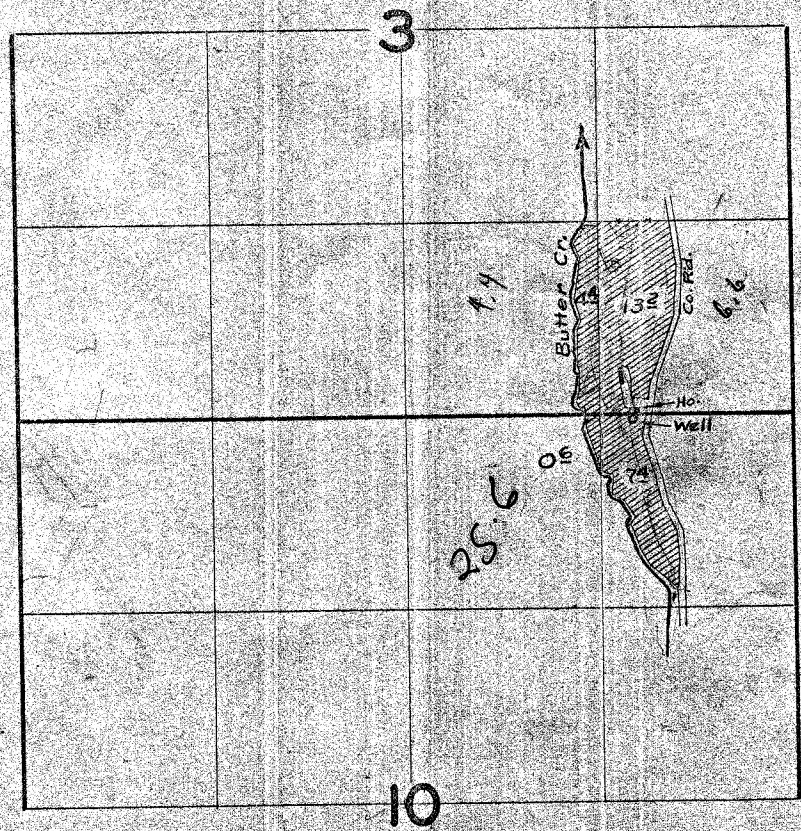

## FINAL PROOF SURVEY UNDER

Application No. U-540 Permit No. U-495  
IN NAME OF

EARL W. WATTENBURGER

Surveyed 23 Oct. 1958, by M. B. Rich