


# T.3&4 N.R.30 E.W.M.

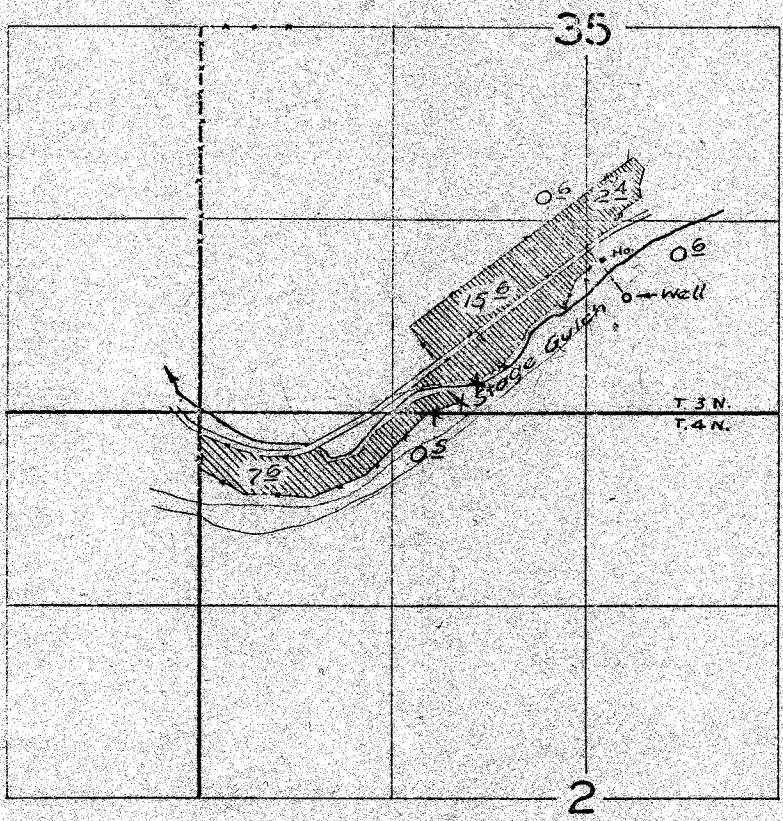

## FINAL PROOF SURVEY UNDER

Application No. U-558... Permit No. U-506...  
IN NAME OF

LEONARD LORENZEN

Surveyed 20 Nov. 1958, by Tm. Bish