


T.2 N.R.16 E.W.M.

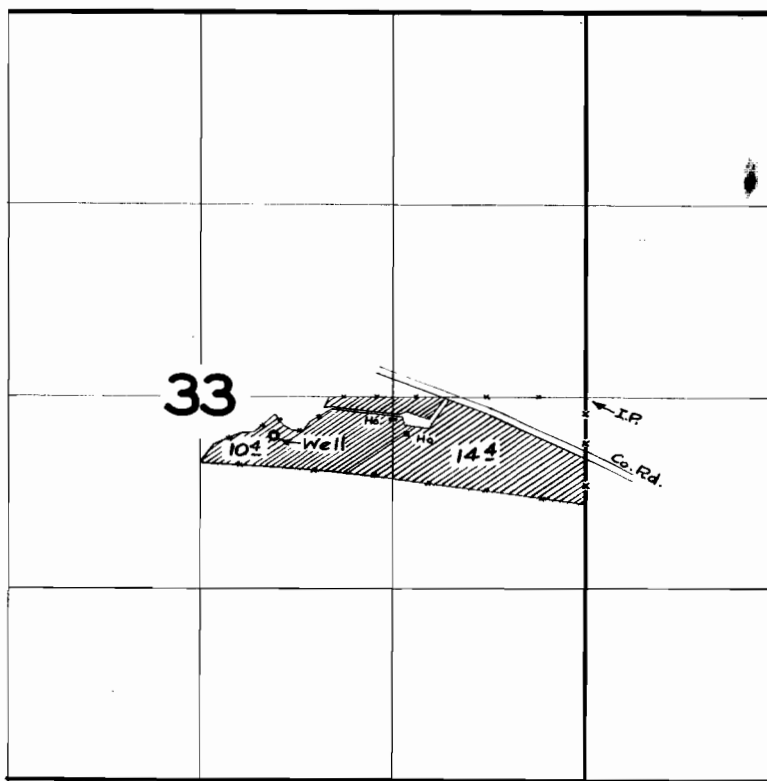

FINAL PROOF SURVEY
UNDER

Application No. U-562 Permit No. U-510
IN NAME OF

H.A. & Rosalie White

Surveyed Oct. 30 1958, by *M. Bish*