


T. 4 N. R. 29 E. W.M.

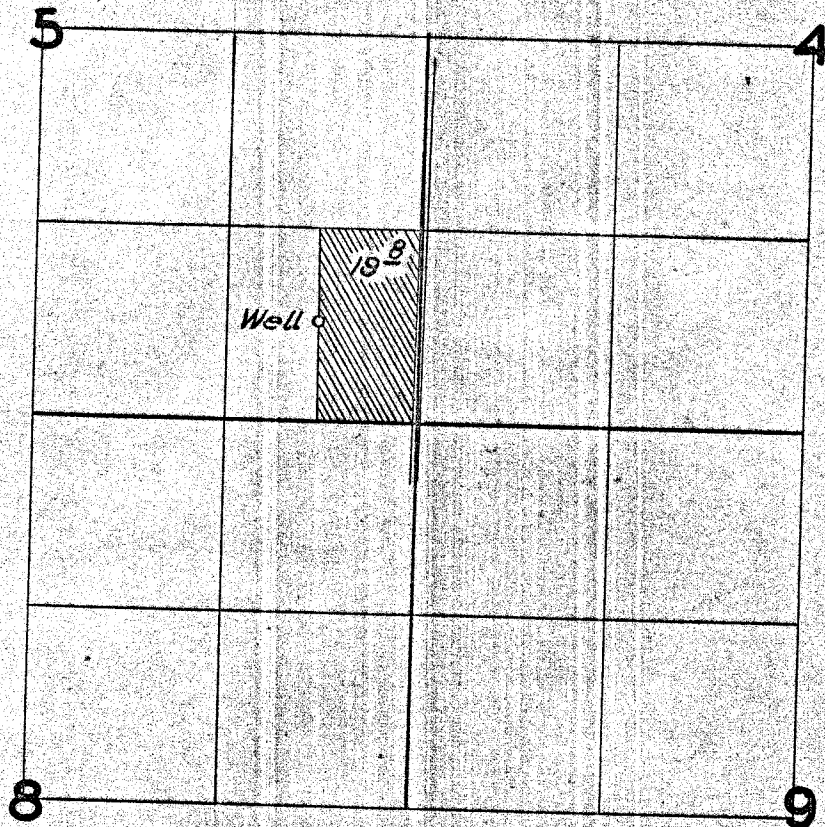

FINAL PROOF SURVEY UNDER

Application No. *U-614* Permit No. *U-570*
IN NAME OF

John & Mary Jane Hershey

Surveyed *Nov. 17, 1958*, by *M. Fish*