


T. 23 S. R. 32 E. W. M.

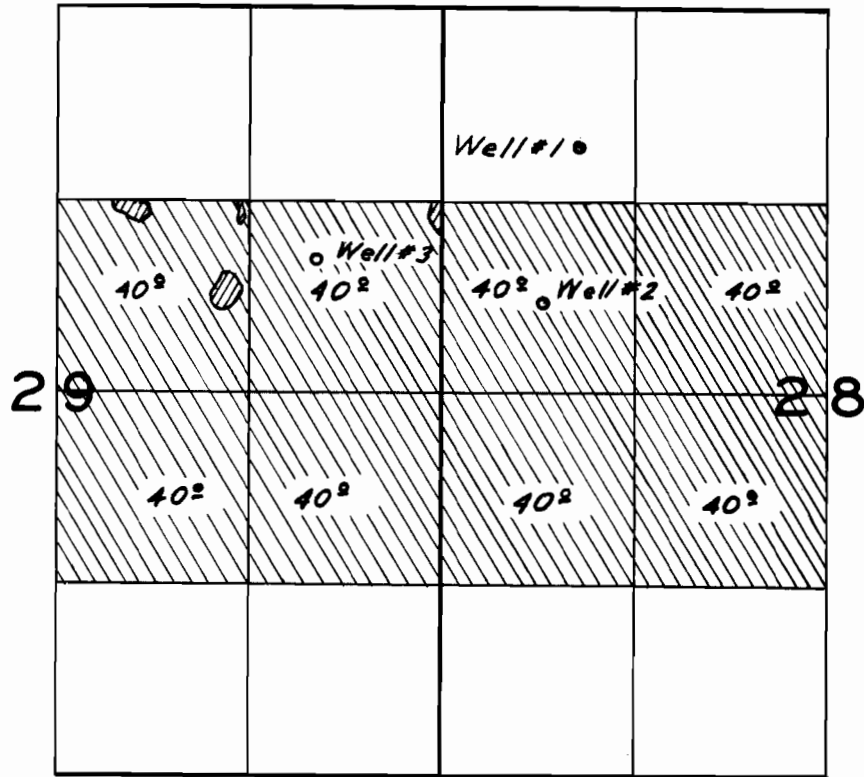

FINAL PROOF SURVEY
UNDER

primary  suppl. 
Application No. U-836 Permit No. U-731
IN NAME OF

T. J. & Bessie Duhaime

Surveyed July 21 1958, by W. N. Perry