


T.3N. R.29E.W.M.

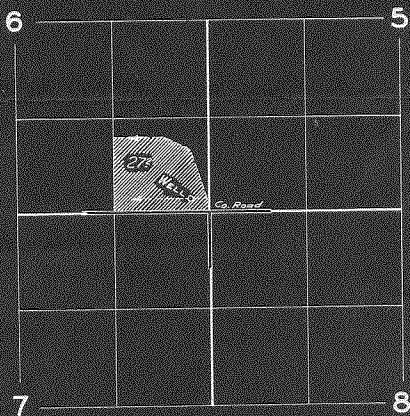

FINAL PROOF SURVEY
UNDER

Application No. G-42... Permit No. G-44
IN NAME OF

J. F. RILEY

Surveyed 15 Nov. 1958, by M. Bish

SK