


T. 4S. R. 1 & 2W. W. M.

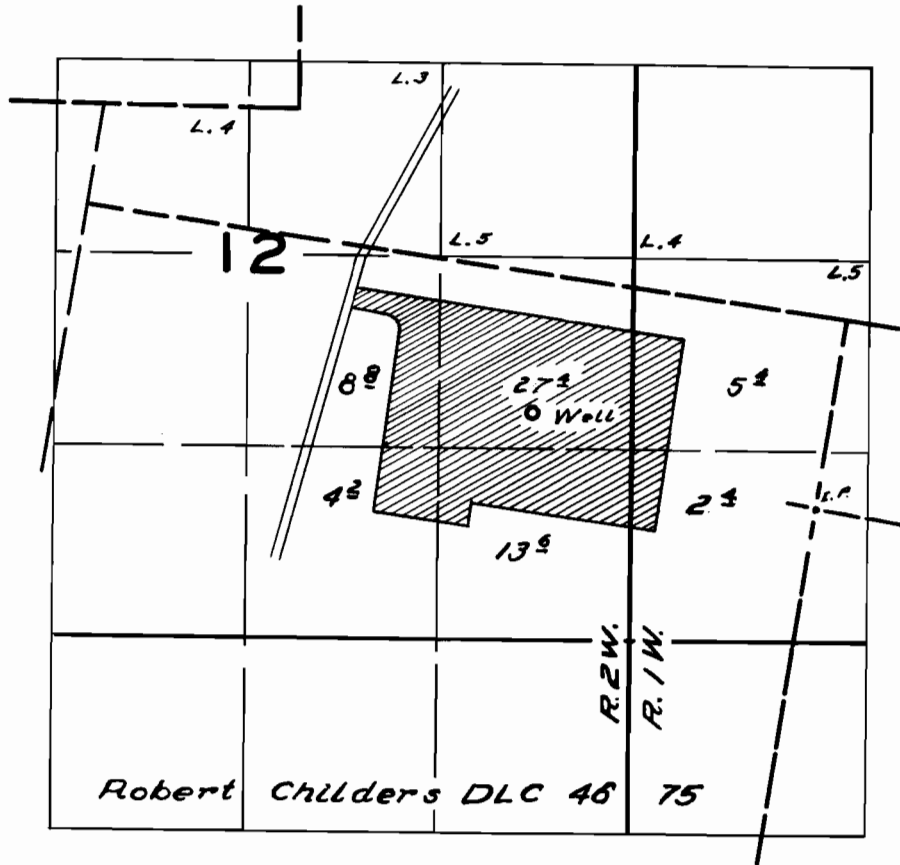

FINAL PROOF SURVEY
UNDER

Application No. *G-371* Permit No. *G-247*
IN NAME OF

Kilian W. Smith

Surveyed *June 26 1958*, by *M. Bish*