


T.1N.R.17E.W.M.

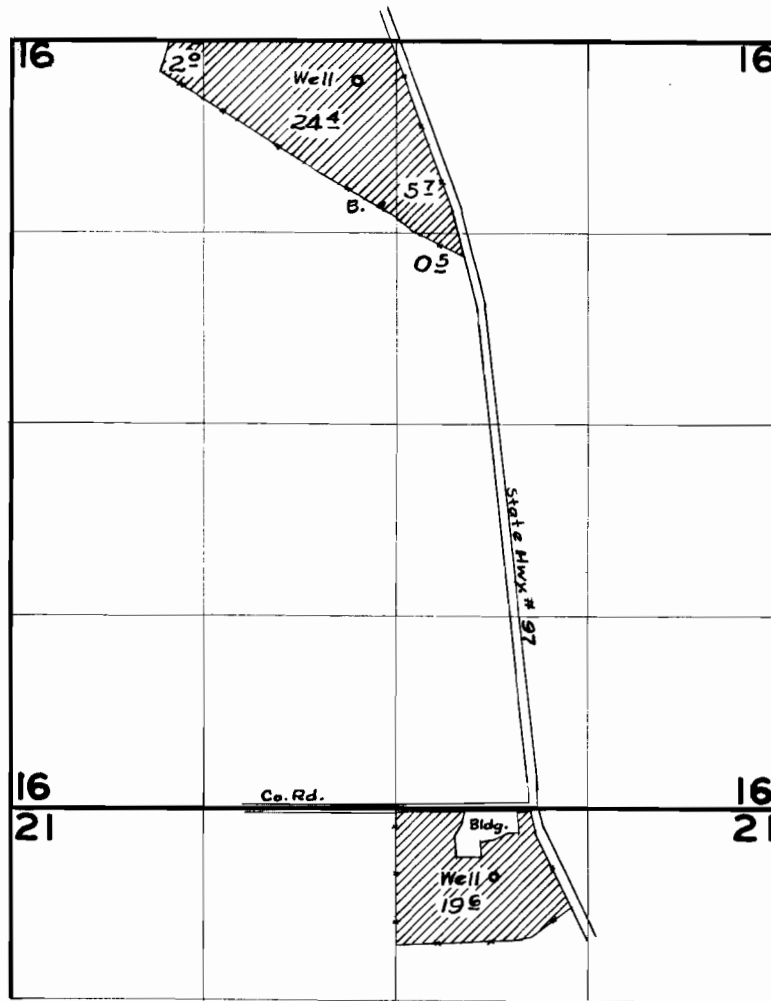

FINAL PROOF SURVEY UNDER

Application No. *G-400* Permit No. *G-277*
IN NAME OF

L. P. & MABEL HAVEN

Surveyed *29 Oct.* 1958, by *M. B. Bish*