


T. 23S. R. 27E. W.M.

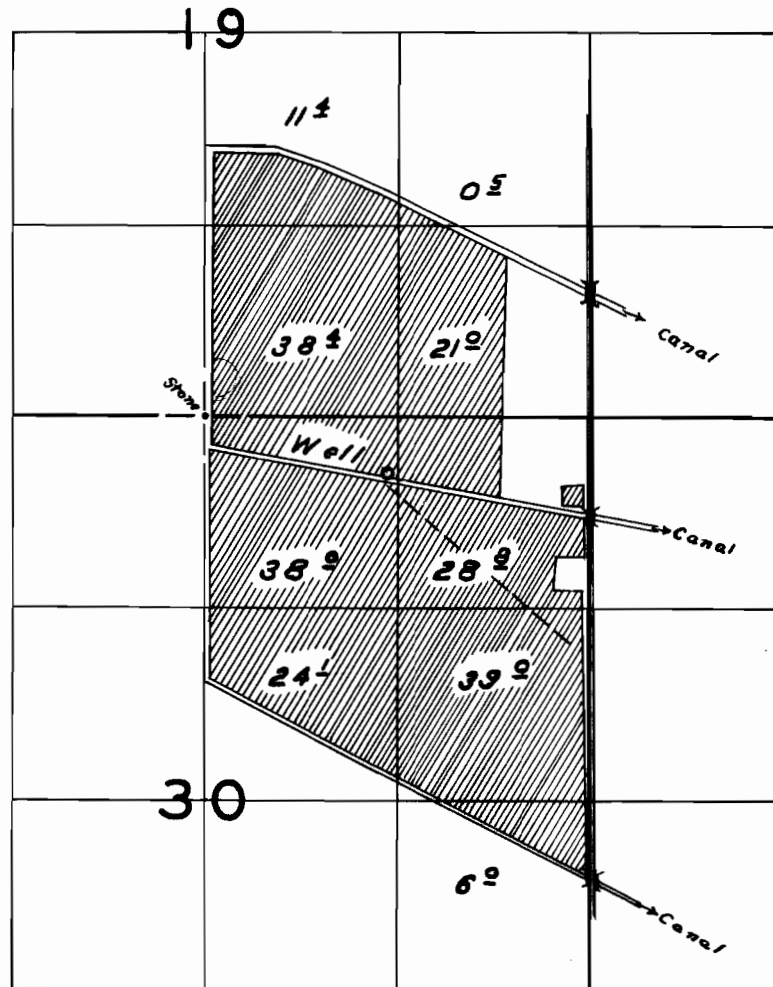

FINAL PROOF SURVEY
UNDER

Application No. G-309 Permit No. G-325
IN NAME OF

Farm Development Co.

Surveyed Sept. 23 1958, by W. N. Perry