


T.2N.R.17E.W.M.

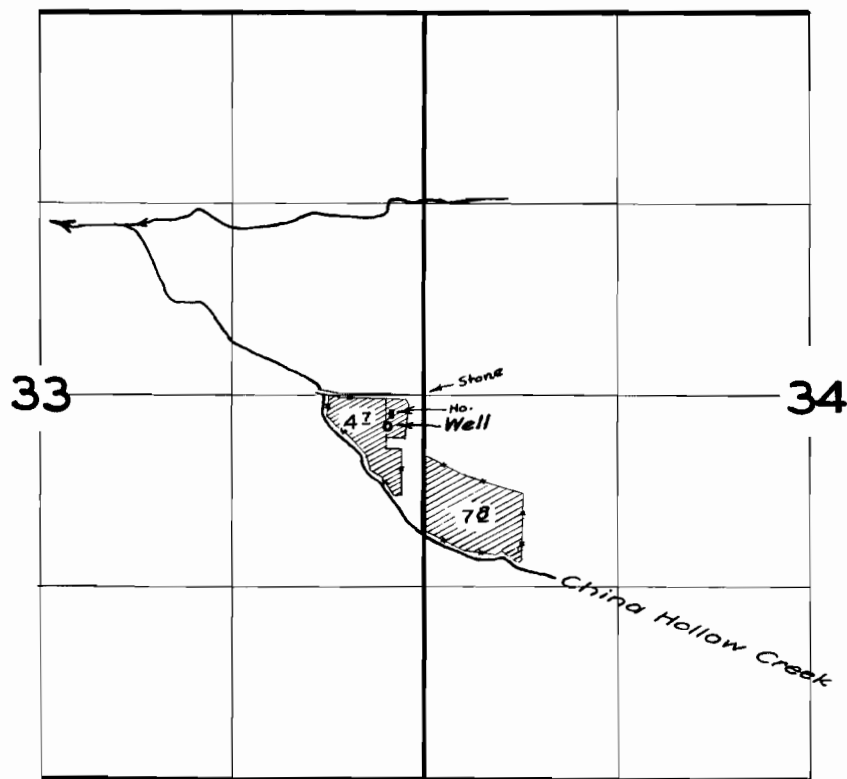

FINAL PROOF SURVEY
UNDER

Application No. G-586 Permit No. G-495
IN NAME OF

DELMER A. & MARGARET SMITH & ARTHUR J. & LEONA F. SMITH

Surveyed 30 Oct 1958, by M. Bish