


T.2 N.R.17 E.W.M.

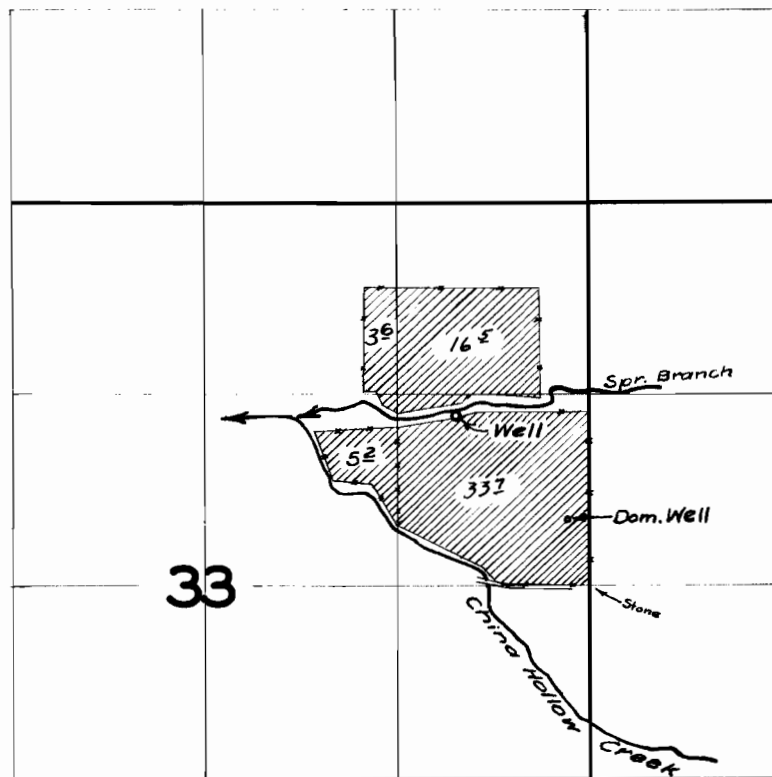

FINAL PROOF SURVEY
UNDER

Application No. G-587 Permit No. G-496
IN NAME OF

RICHELDERFER RANCH

Surveyed 30 Oct. 1958, by Tm. Bish