


T.11 S.R.5 W.W.M.

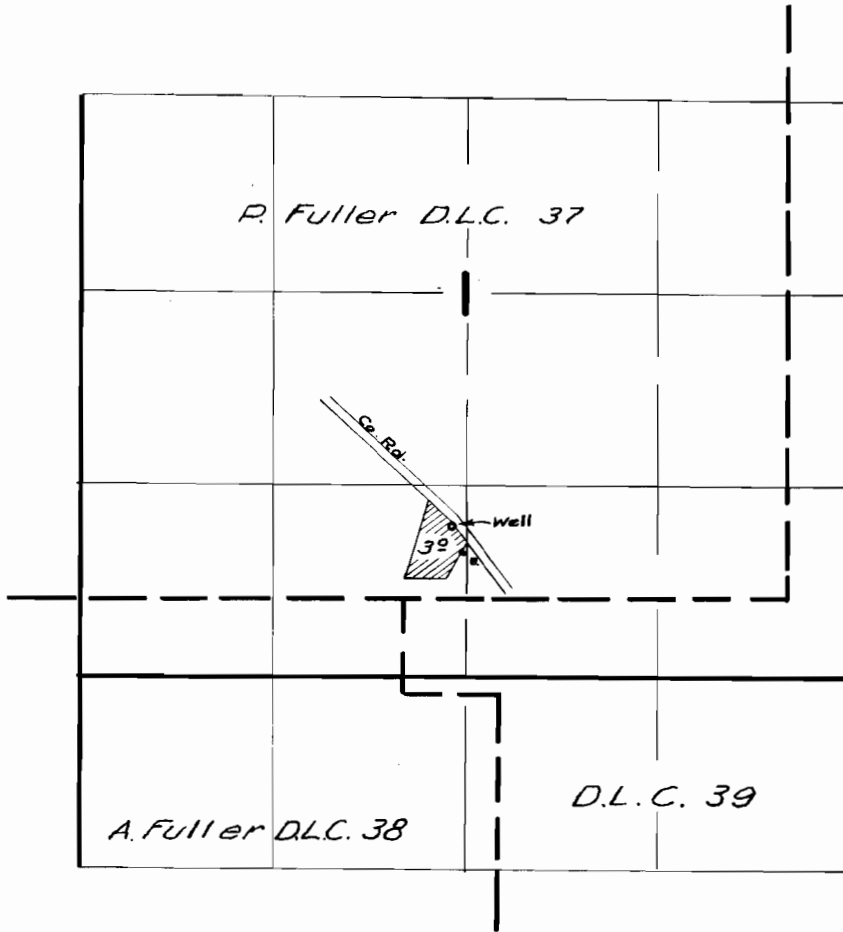

FINAL PROOF SURVEY
UNDER

Application No. G-601 Permit No. G-530
IN NAME OF

KARL BRUINSMA

Surveyed 25 Sept. 1958, by M. Bishop