


T. 11 S. R. 2 W. W.M.

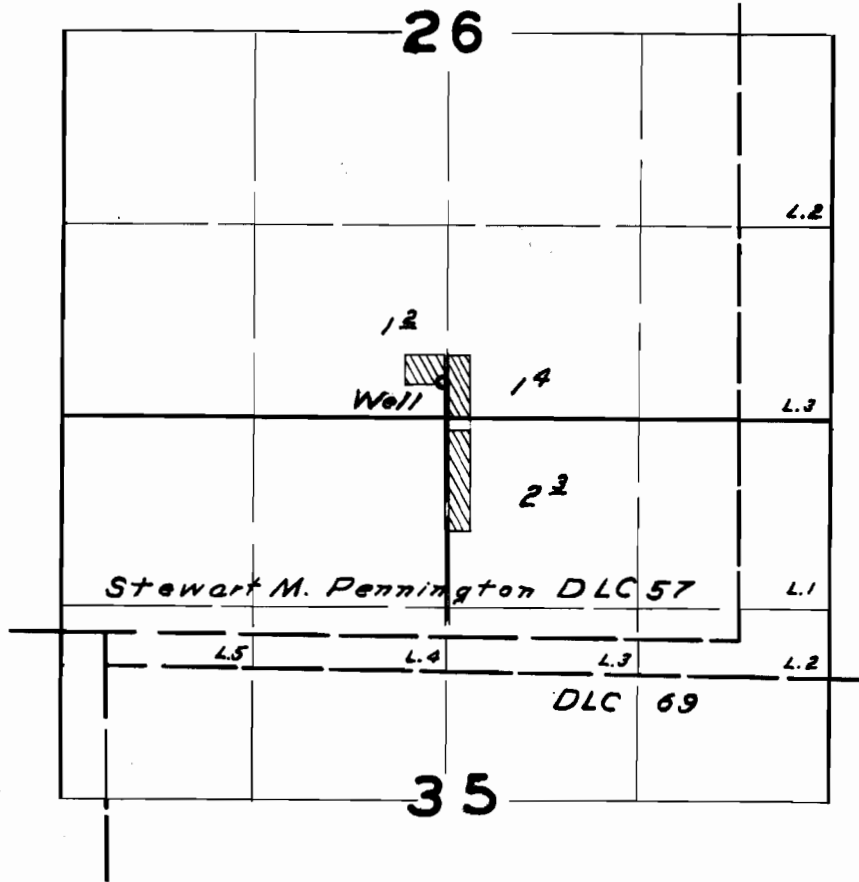

**FINAL PROOF SURVEY**  
UNDER

Application No. G-639 Permit No. G-556  
IN NAME OF

James Pesek

Surveyed Sept. 9 1958, by W.M. Perry